


1941
ORME ST. - EL. QUENTIN TO W.L. BLUFF
30' CONC WITH INTEGRAL CURB

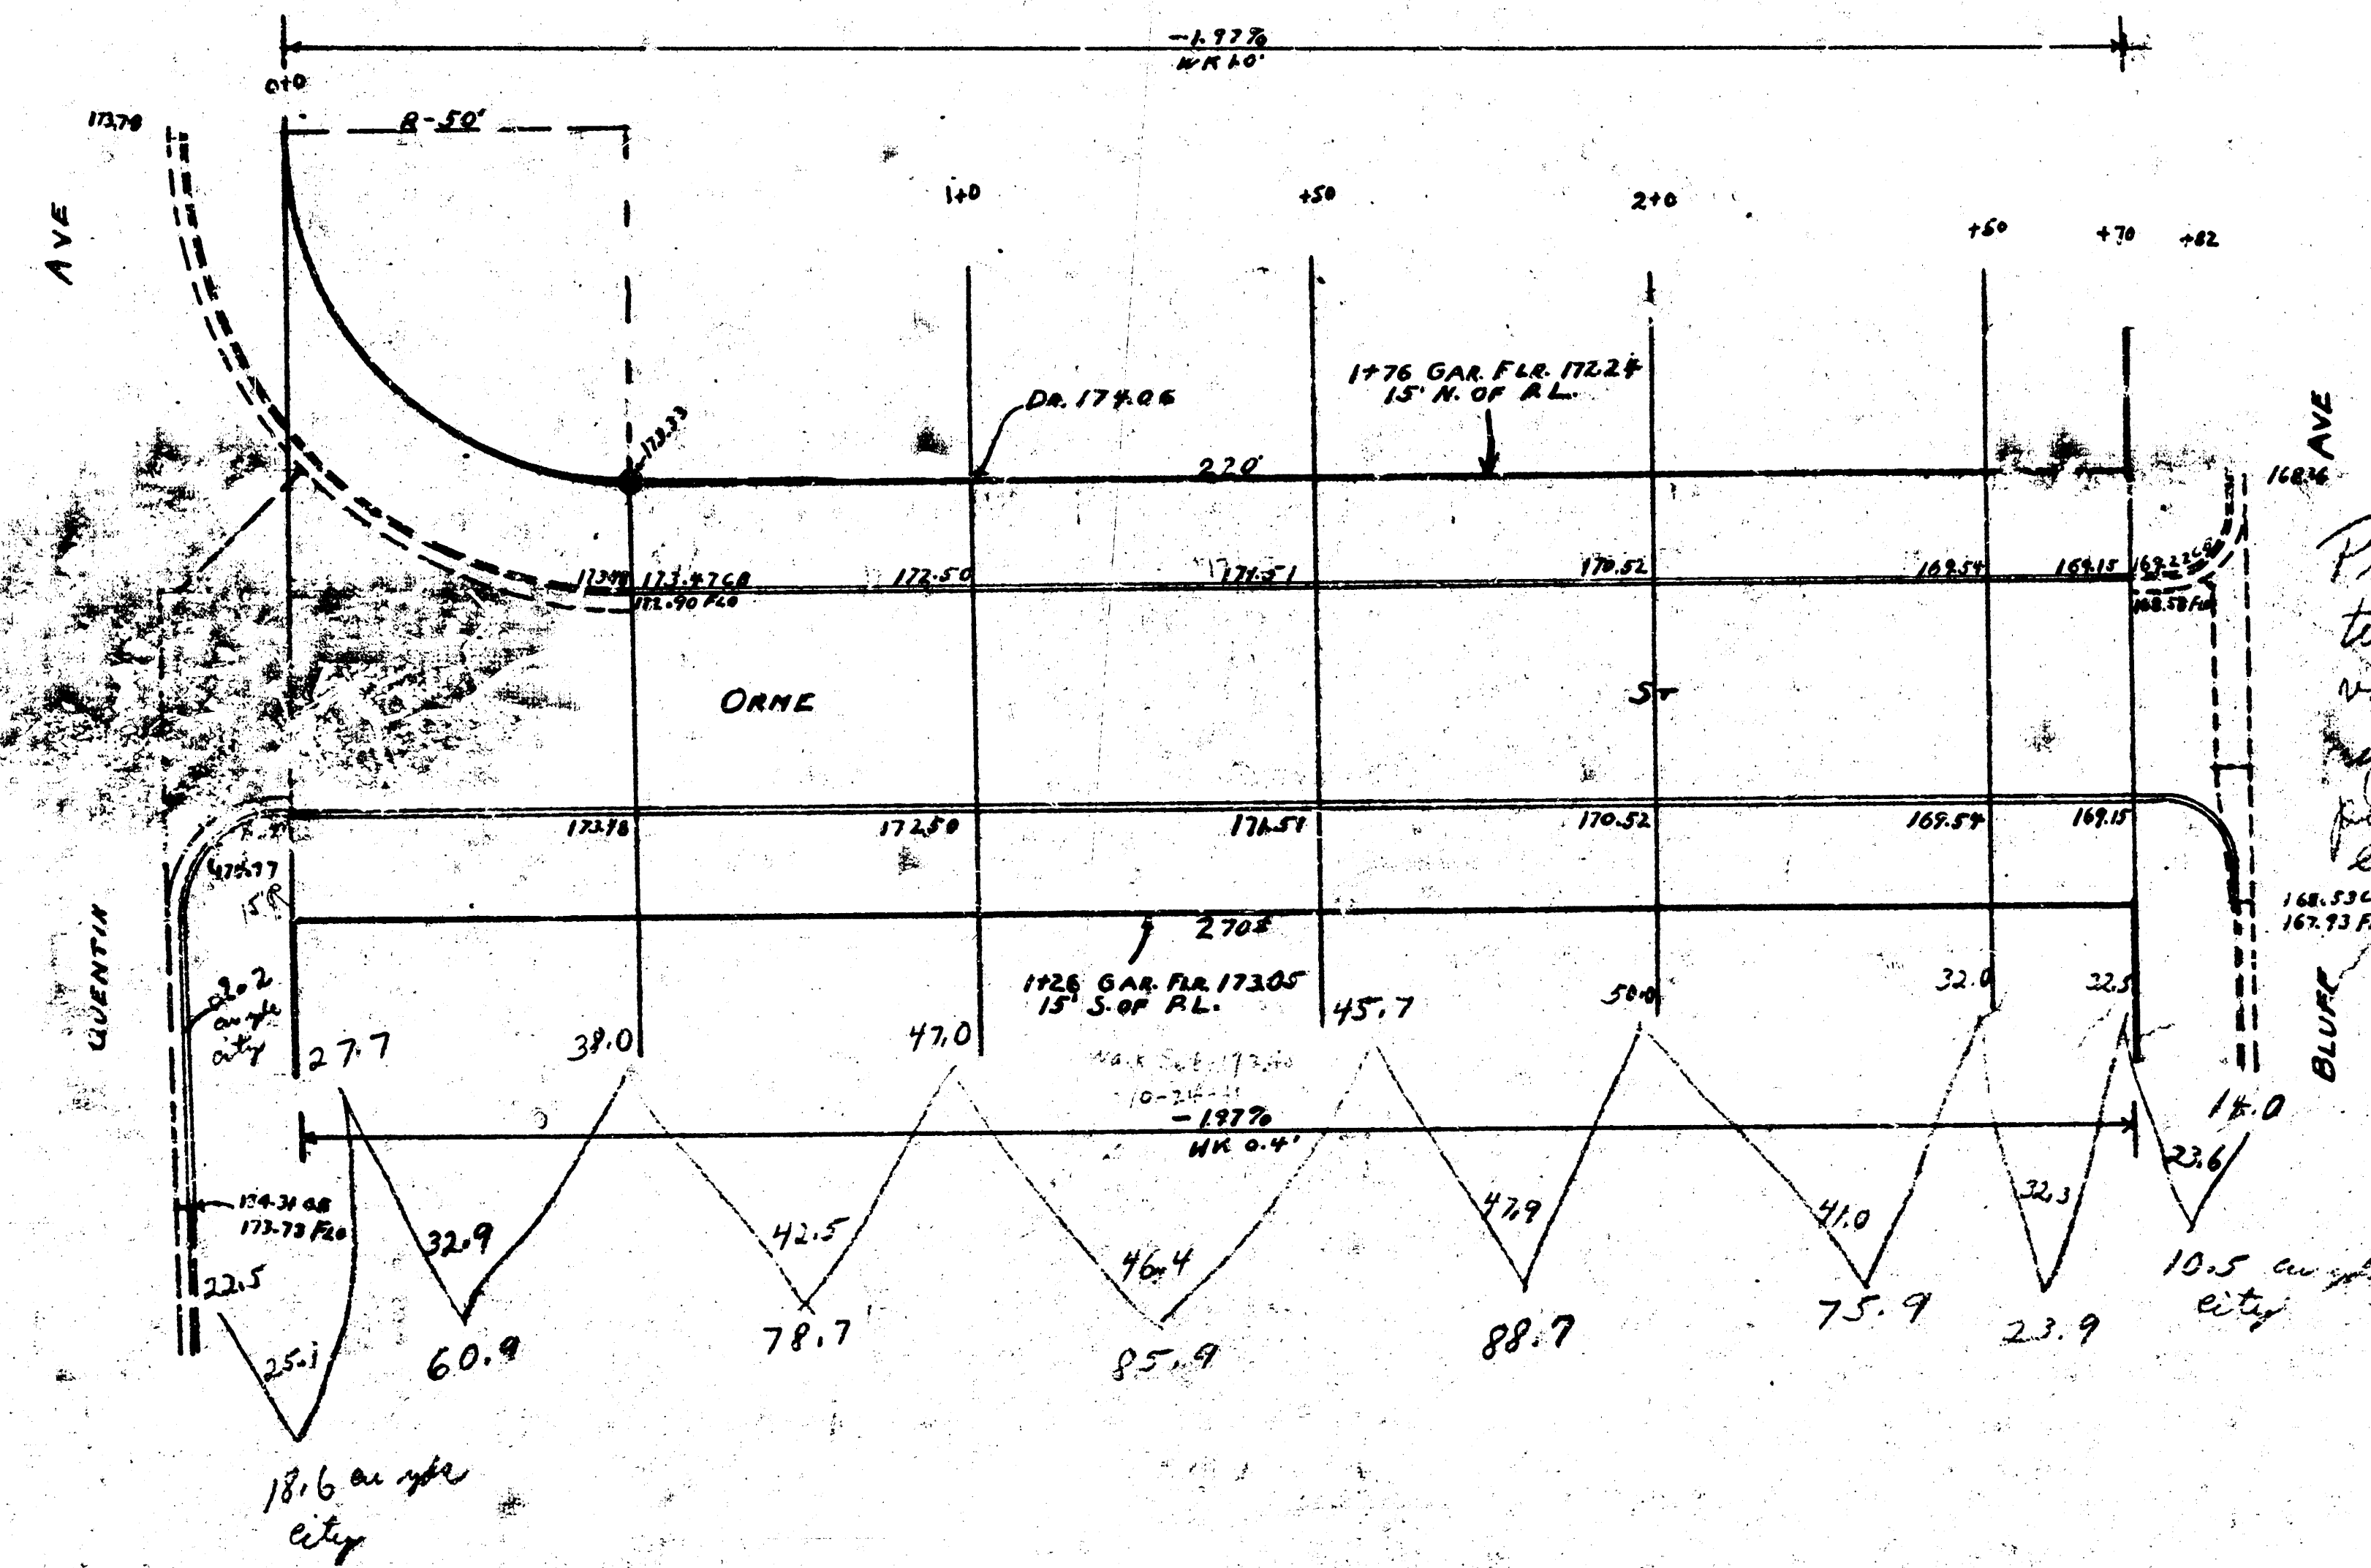

Probably advisable
to remove existing
valley gutter and
replace with 6"
pavement unless in
excellent condition
P.L.K.

PROP	CITY
60.9	3.2
78.7	18.6
85.7	15.5
88.7	31.3
75.9	
23.9	
414.0	

C.U. YDS + 1073 =
PROP 414.0 + 41.4 = 455.4
CITY 31.3 3.1 = 34.4
489.8

PAVING PLAN
1941
ORME ST.
EL. QUENTIN
W.L. BLUFF