


Book "G"



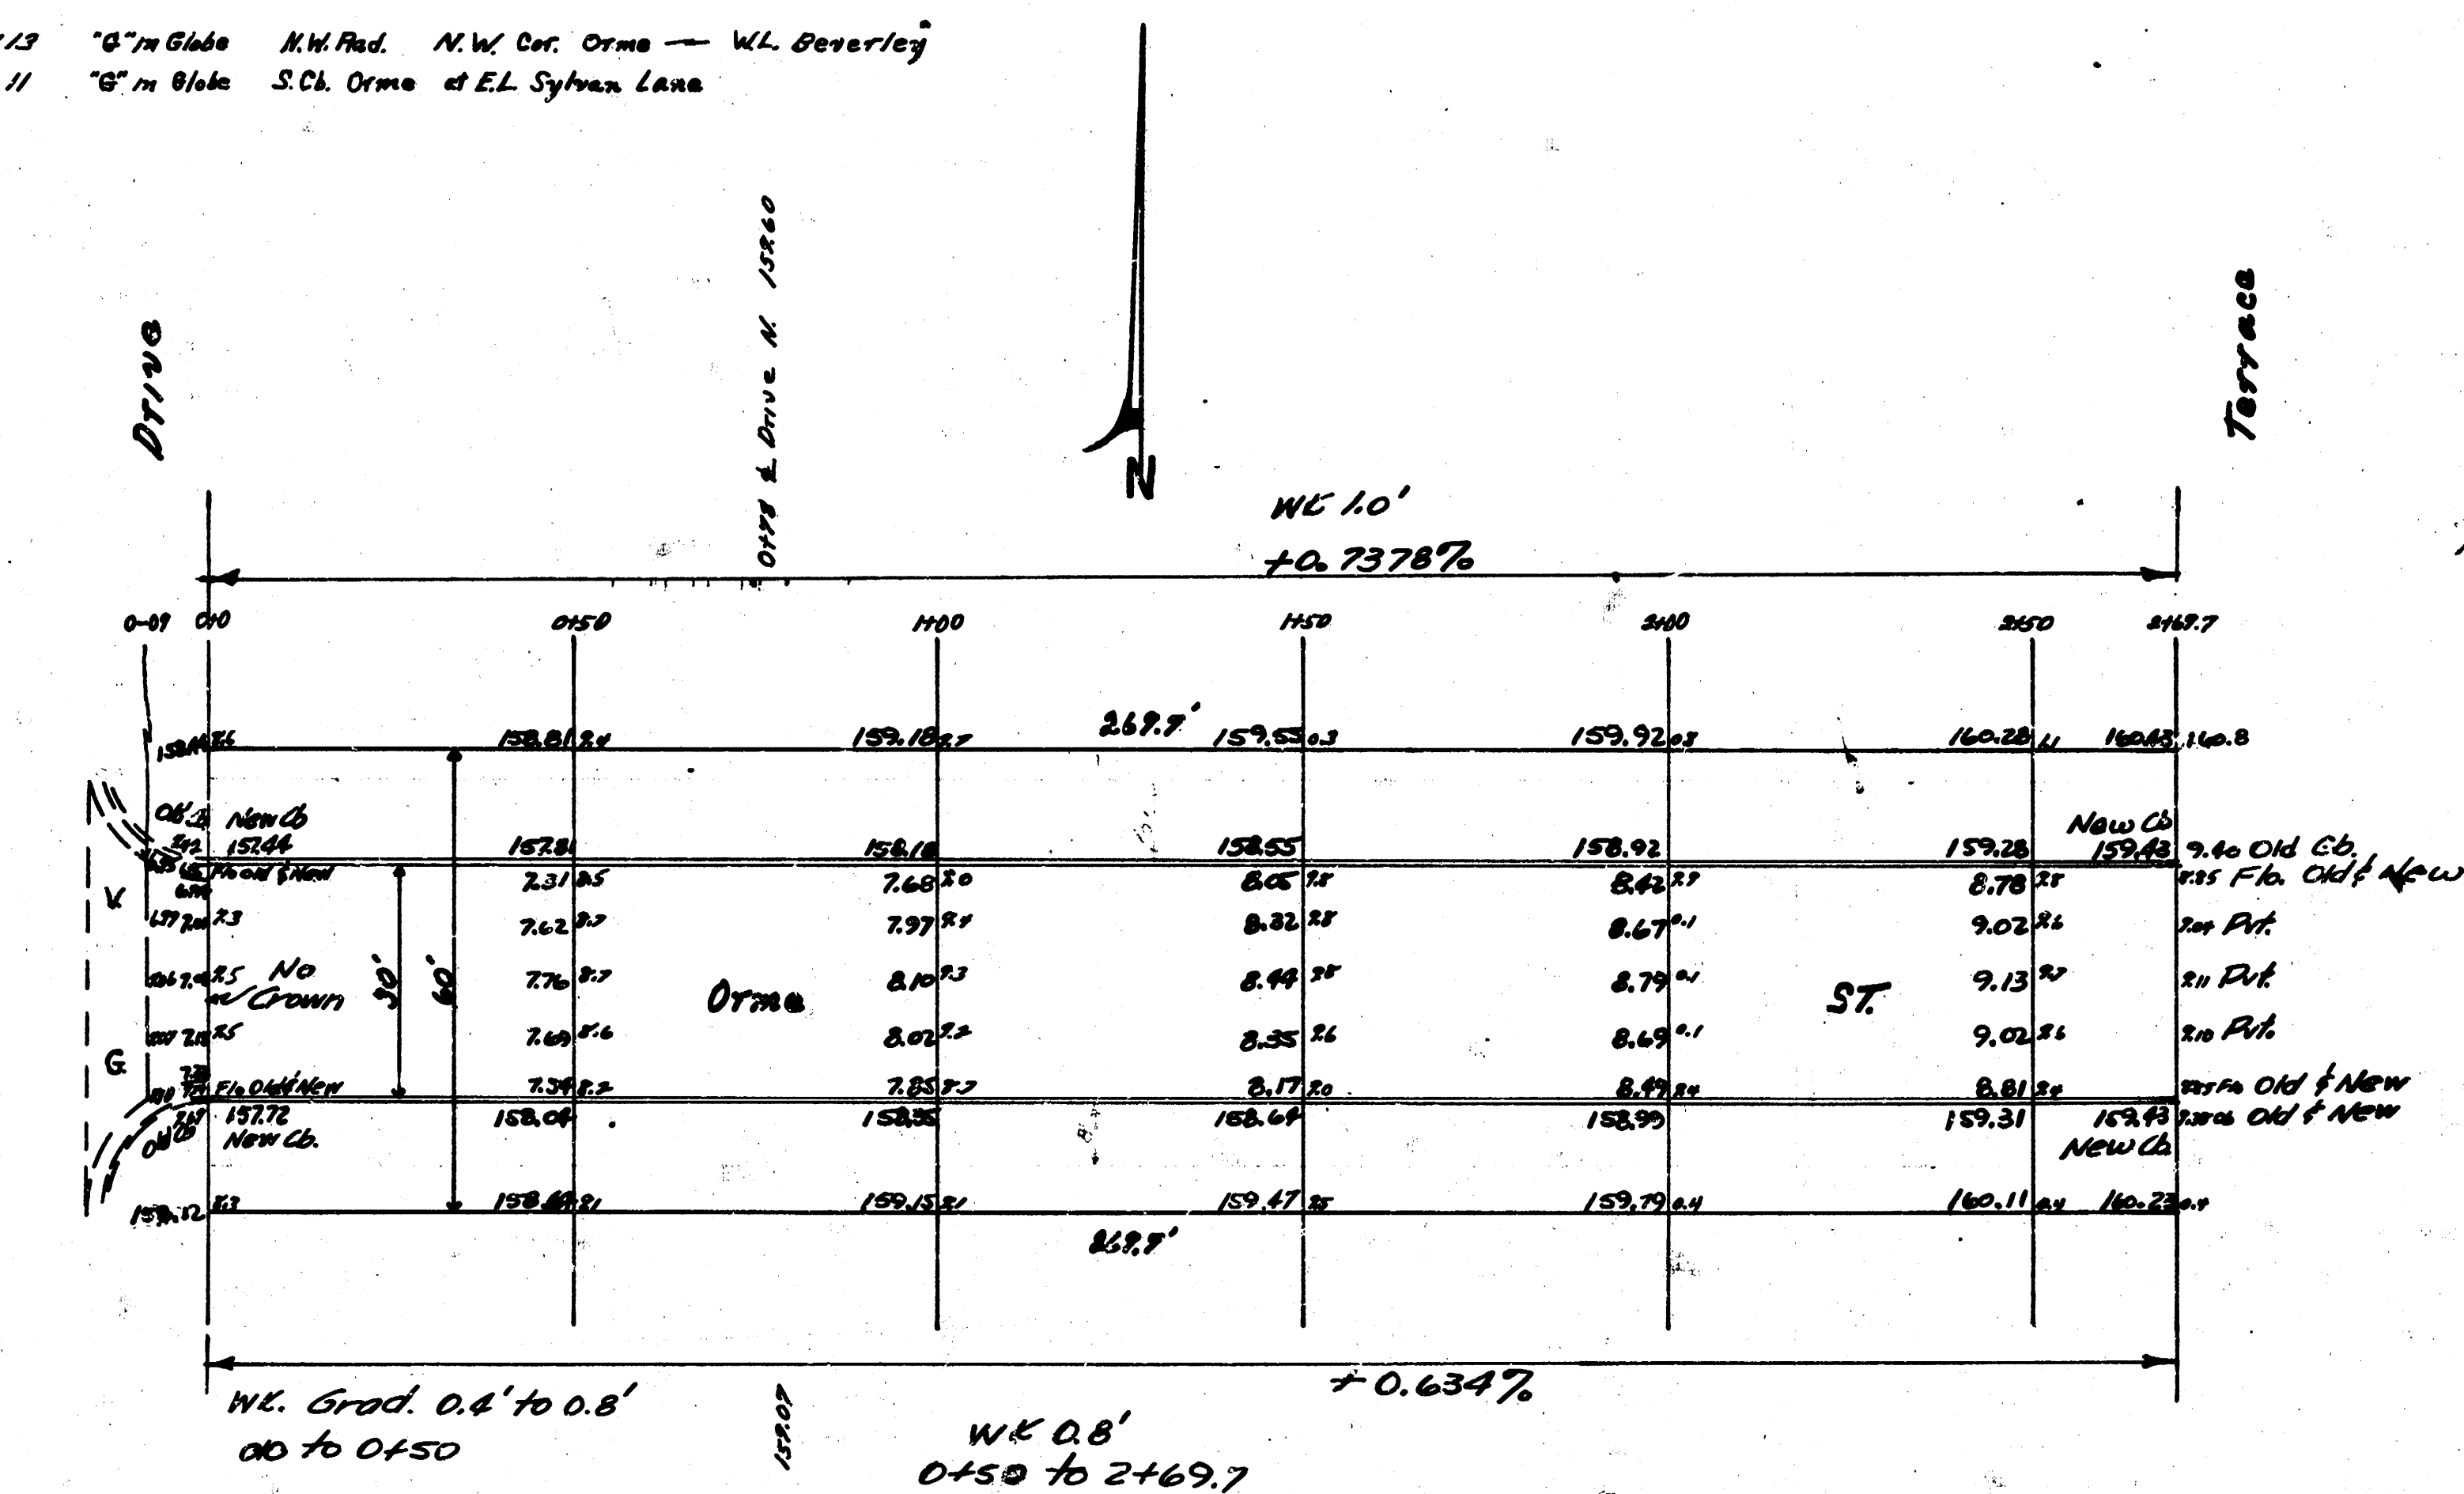

Prop
6.8
80.7
92.0
572.3
+10%
Total 629.5 cu yds.

City
0

400.0 cu yds. 70 cu yds.

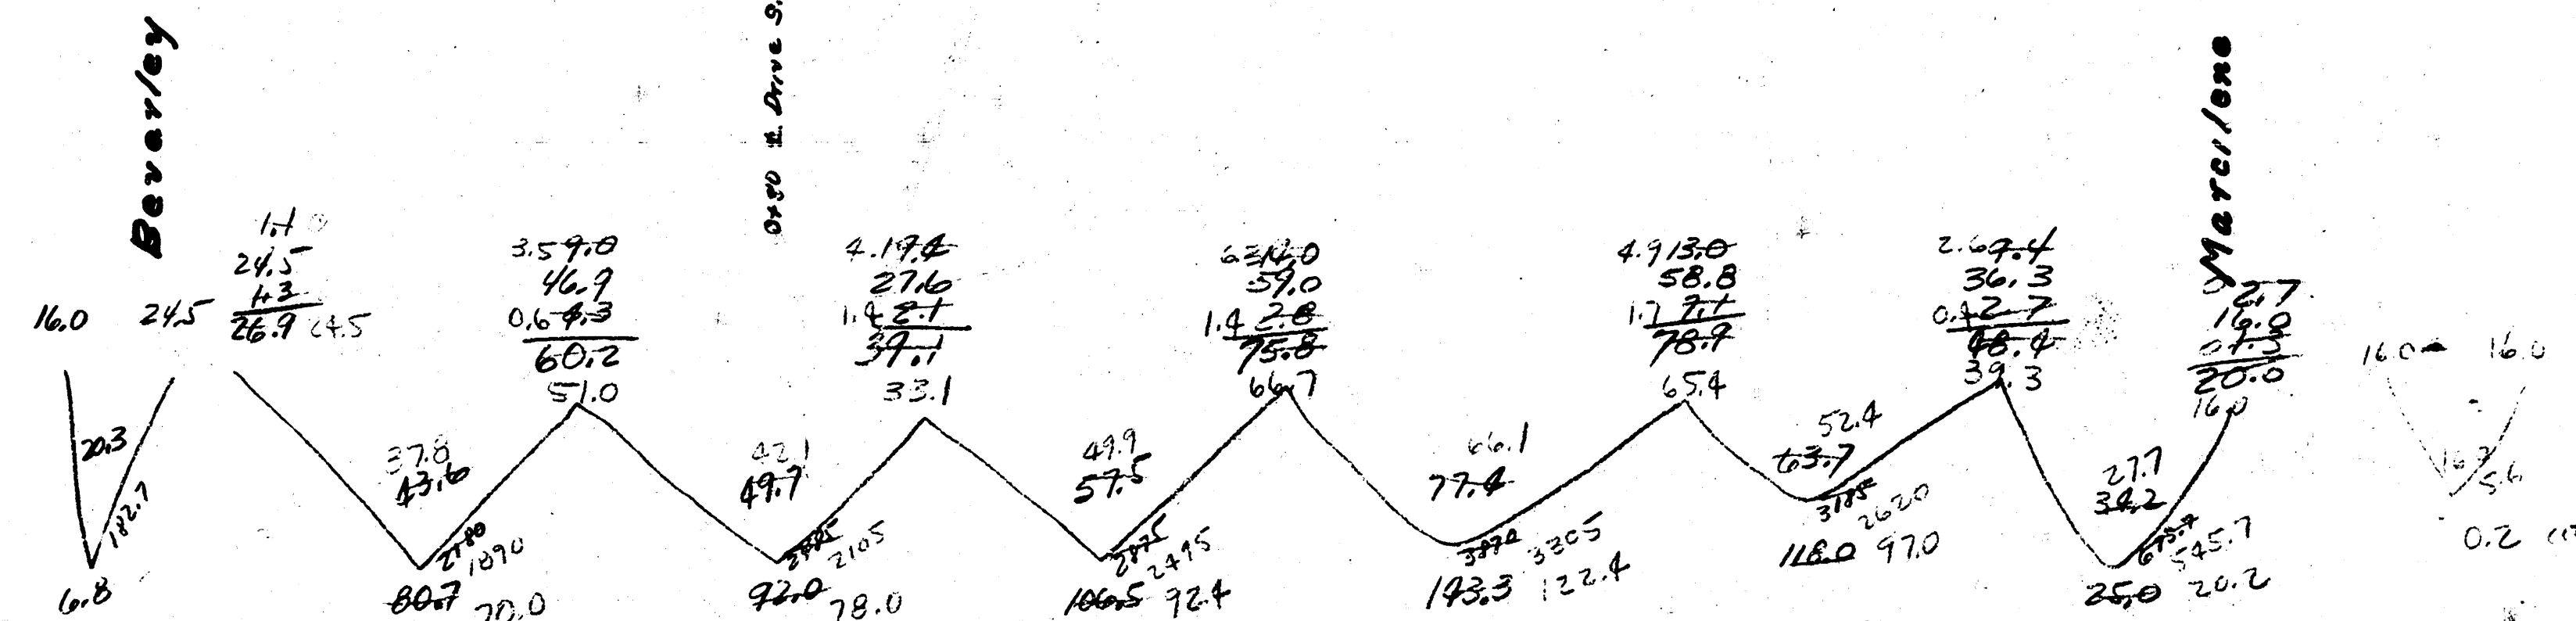

Orma St.
E.L. Beverly Dr. — W.L. Sylvan Lane
90' Cor. & Ch.
City of Wichita, Kansas
L.H. White City Engineer
July 1918
Project C-18-18