


Fannie (Greenwood) & Osie
 2 both Sts.
 4315 NE to 4th & Kendra dr NW
 4390 NW to 4th
 4405 SW to 4th

OSIE ST. W.L. GREENWOOD to W.L. HYDRAULIC 30' CONCRETE

B.M. Elev. 99.75 Iron in Man. & Hydraulic

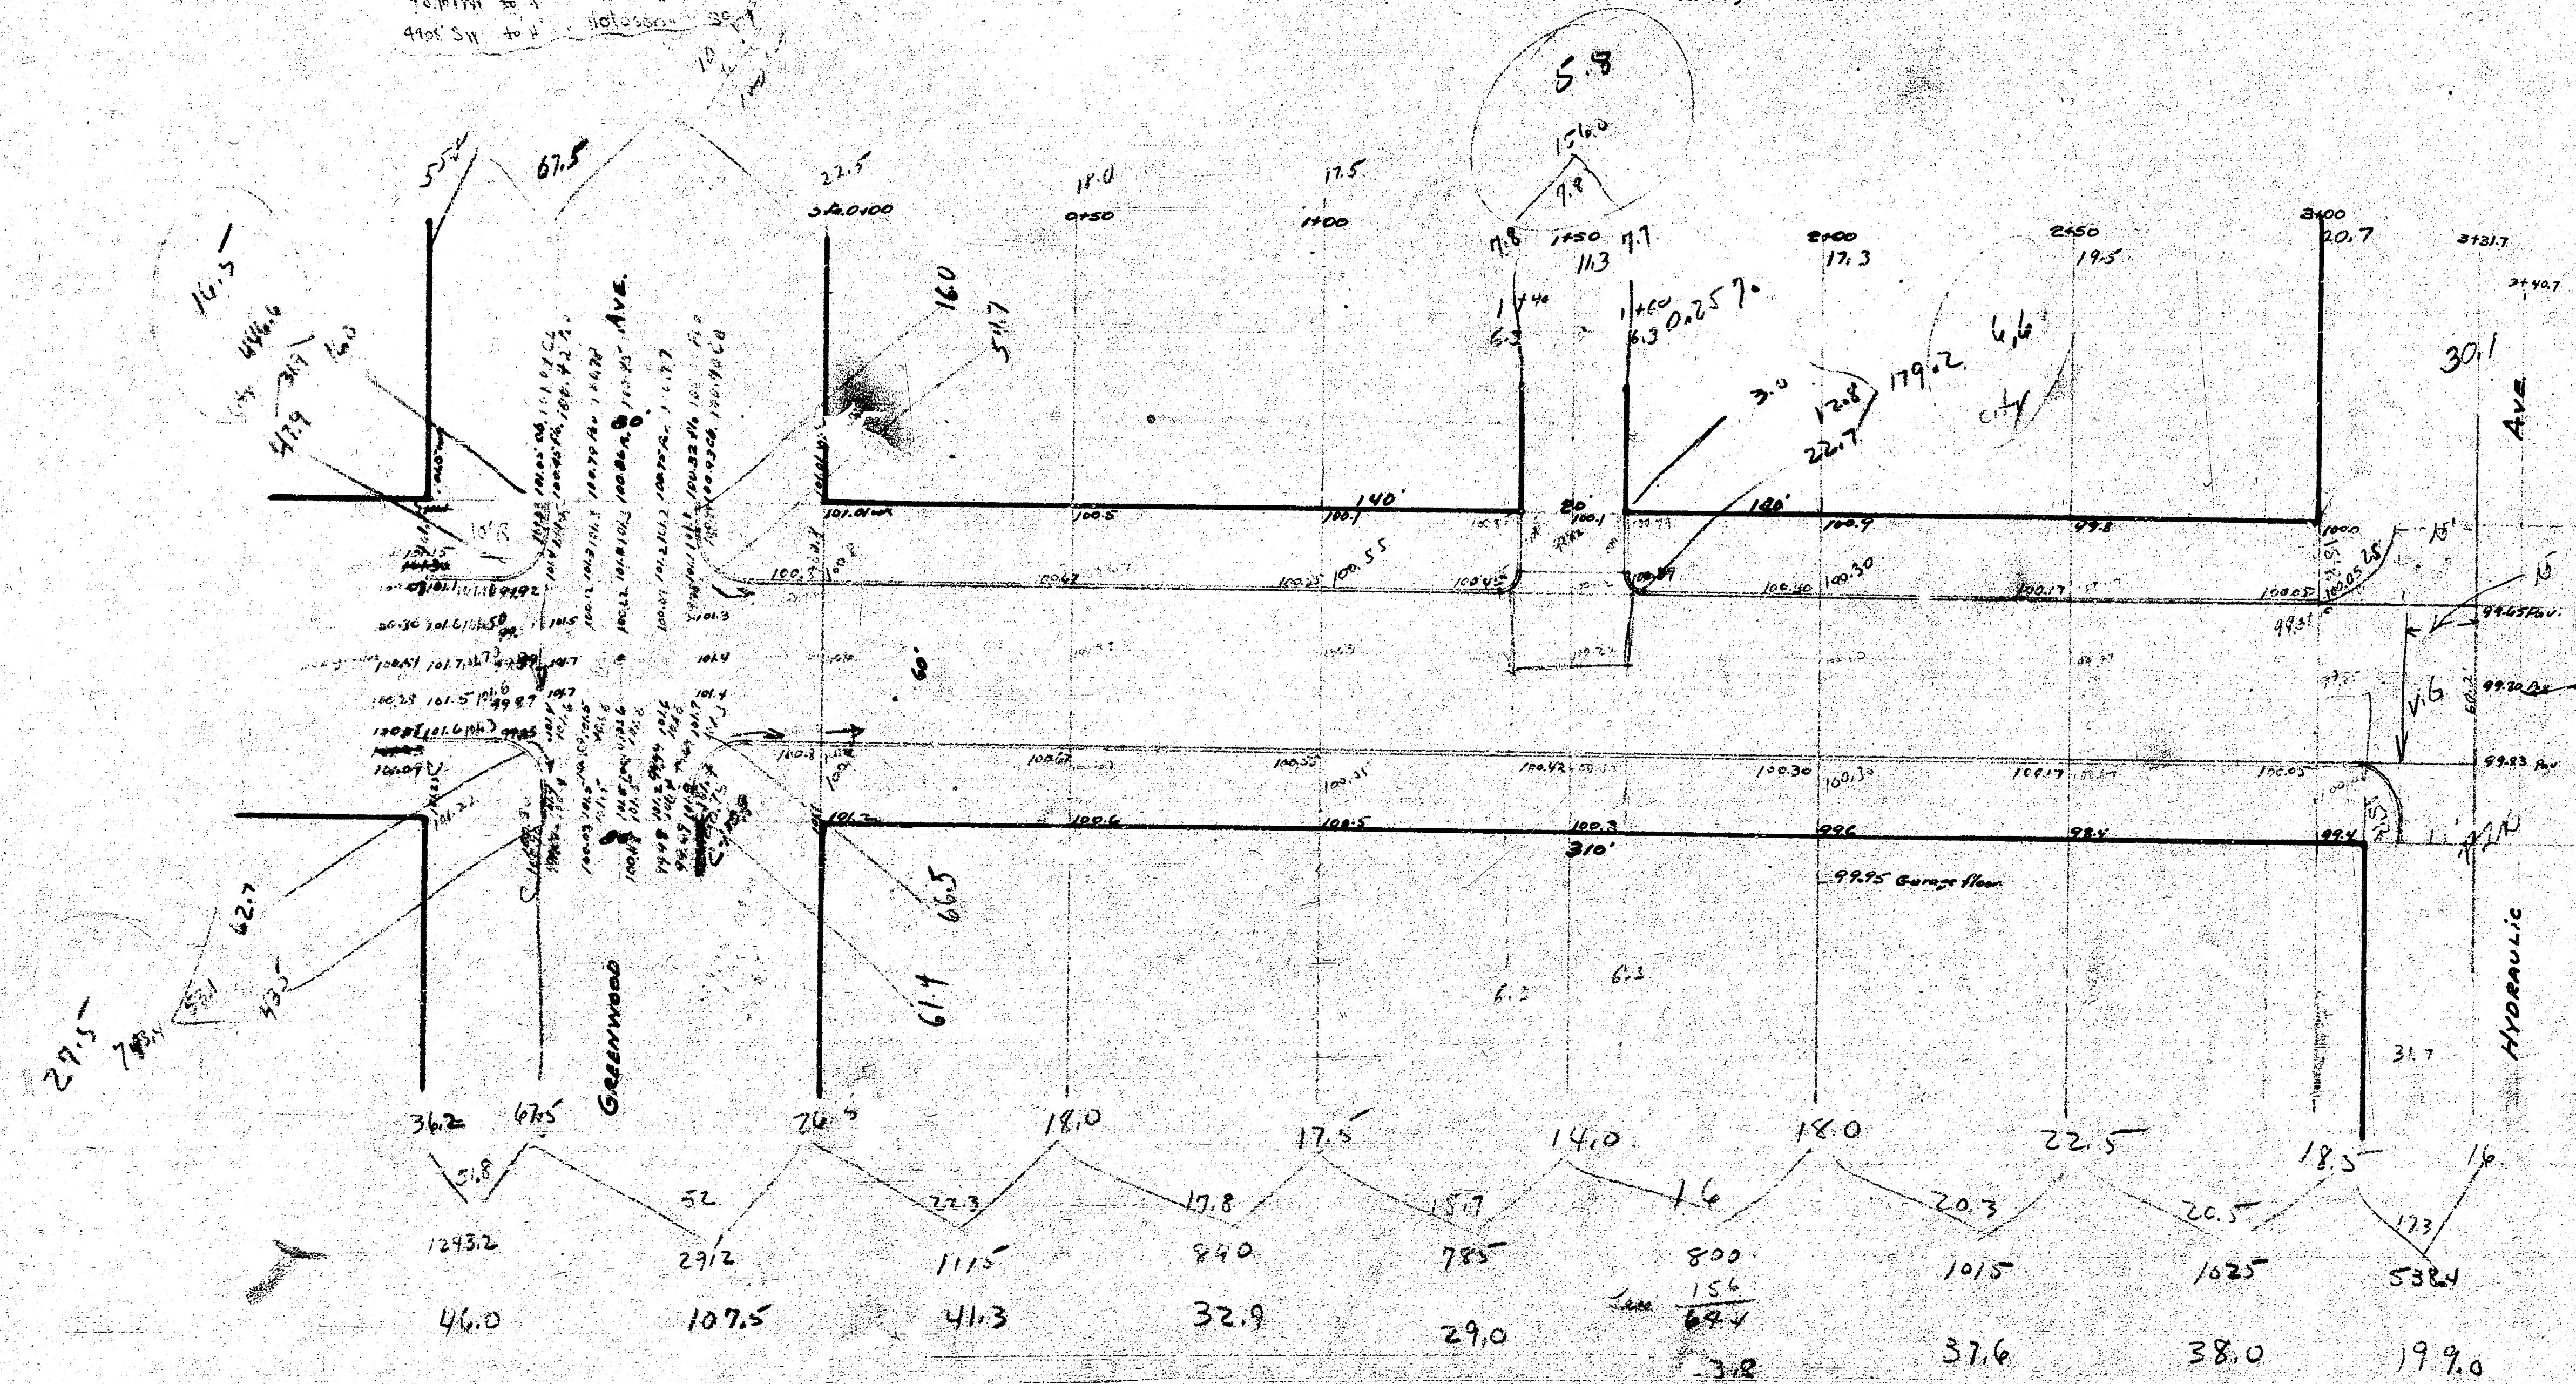

1090
 Prop. 401.6 + 401.7 - 441.7
 City 209.9 x 21 = 230.7
 672.6 CWT