


B.M. 146.89 STANDARD SW COR. EDGEWOOD & HARRY

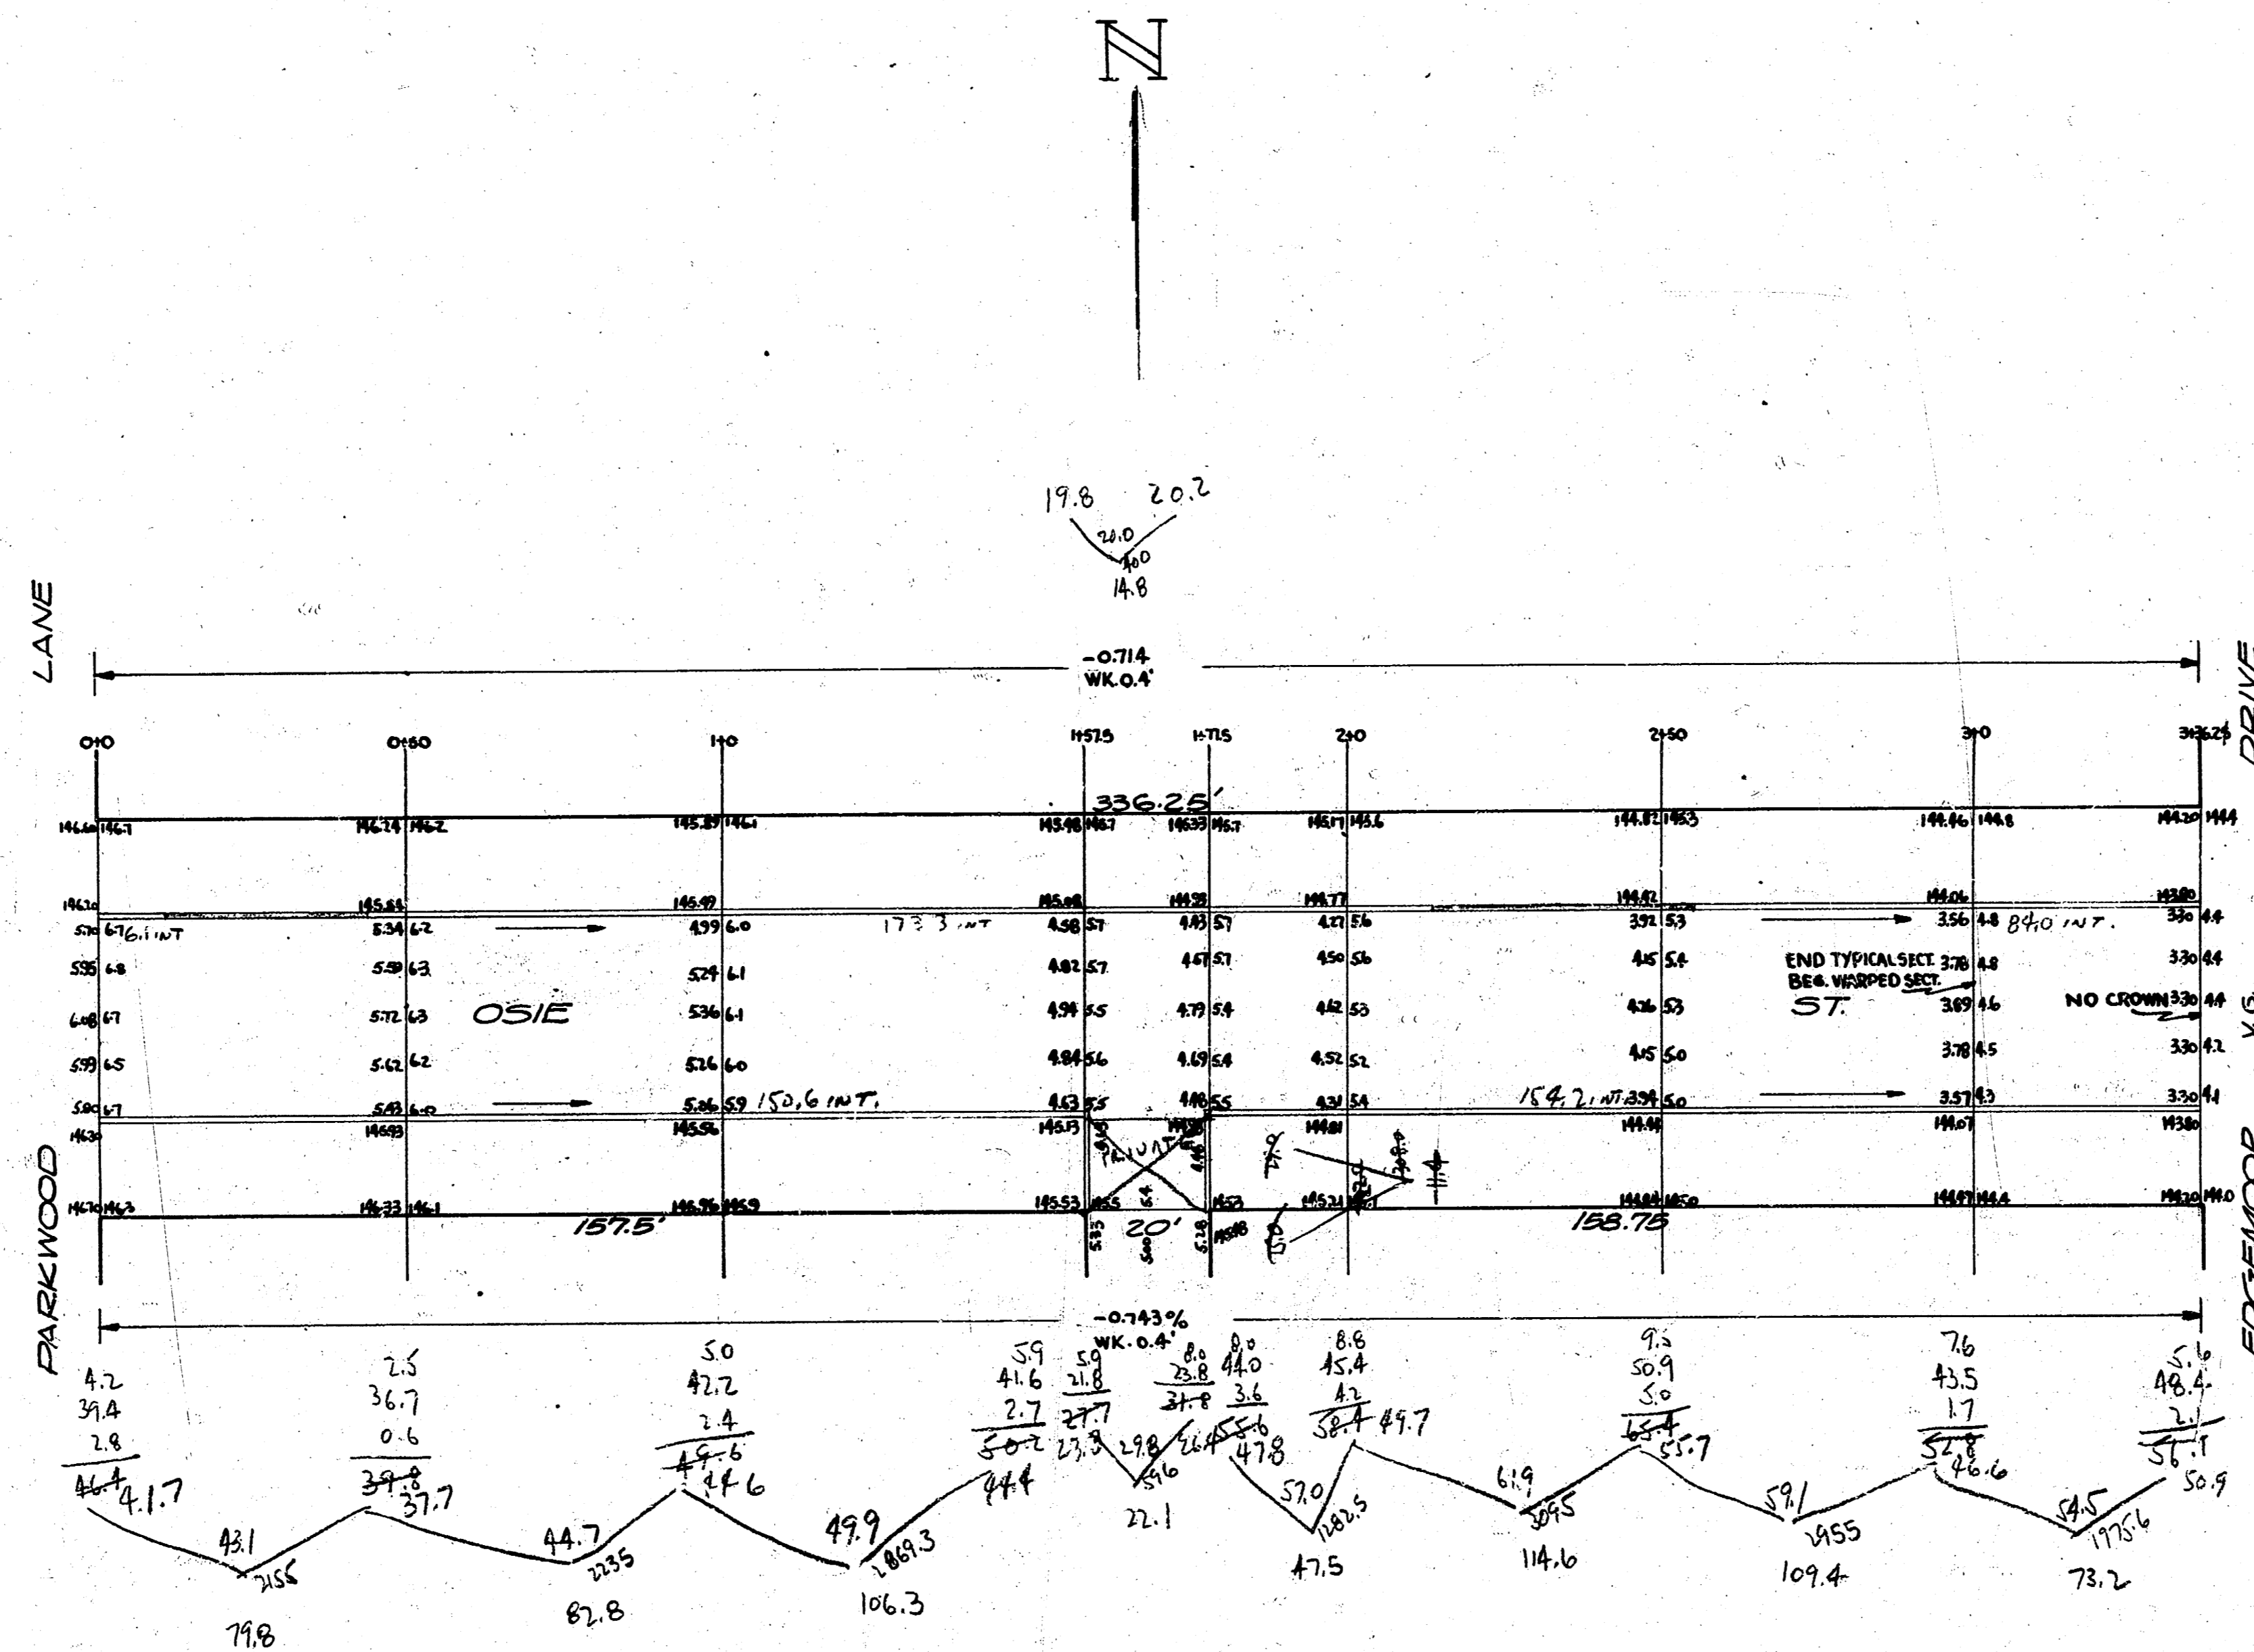

14.8
11.4
78.8
83.8
22.1
47.5
114.6
109.4
73.2
661.9 cu yds.

Pay only 1/3 of
Paving Estimate.

12013
OSIE ST.
E.L. PARKWOOD TO W.L. EDGEWOOD
CITY OF WICHITA, KANSAS
30' CONC & CB.
BUILDER'S INC. MARCH 1950

