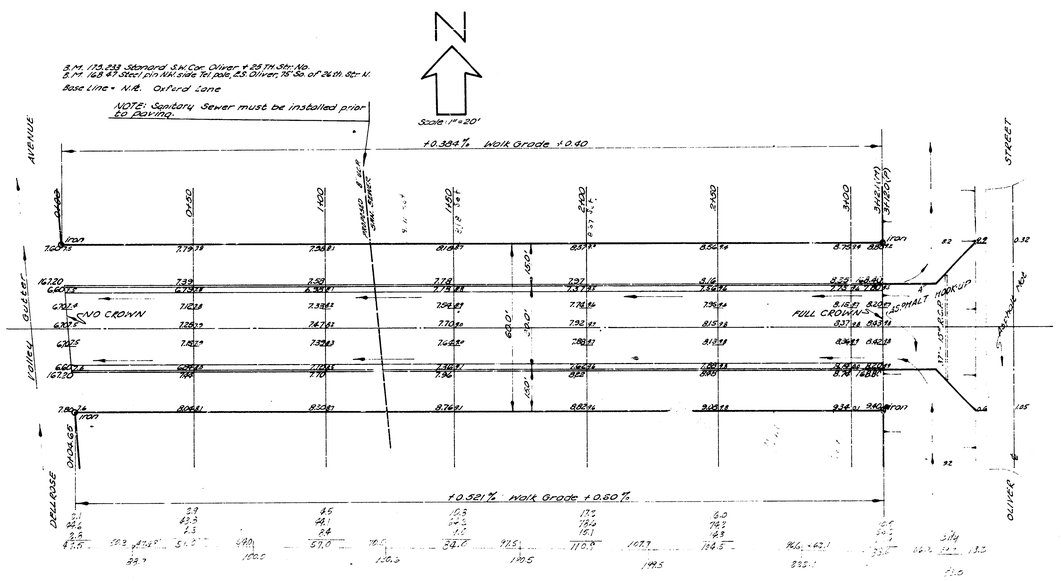


Plan & Profile
Sht. # of
Checked

OXFORD LANE

E.L. Dellrose Ave. to W.L. Oliver Str.

26'-2'-30' Asphaltic Conc.

City of Wichita, Kansas

B.E. Smith City Engineer

Date: Proj. No. C 10-17