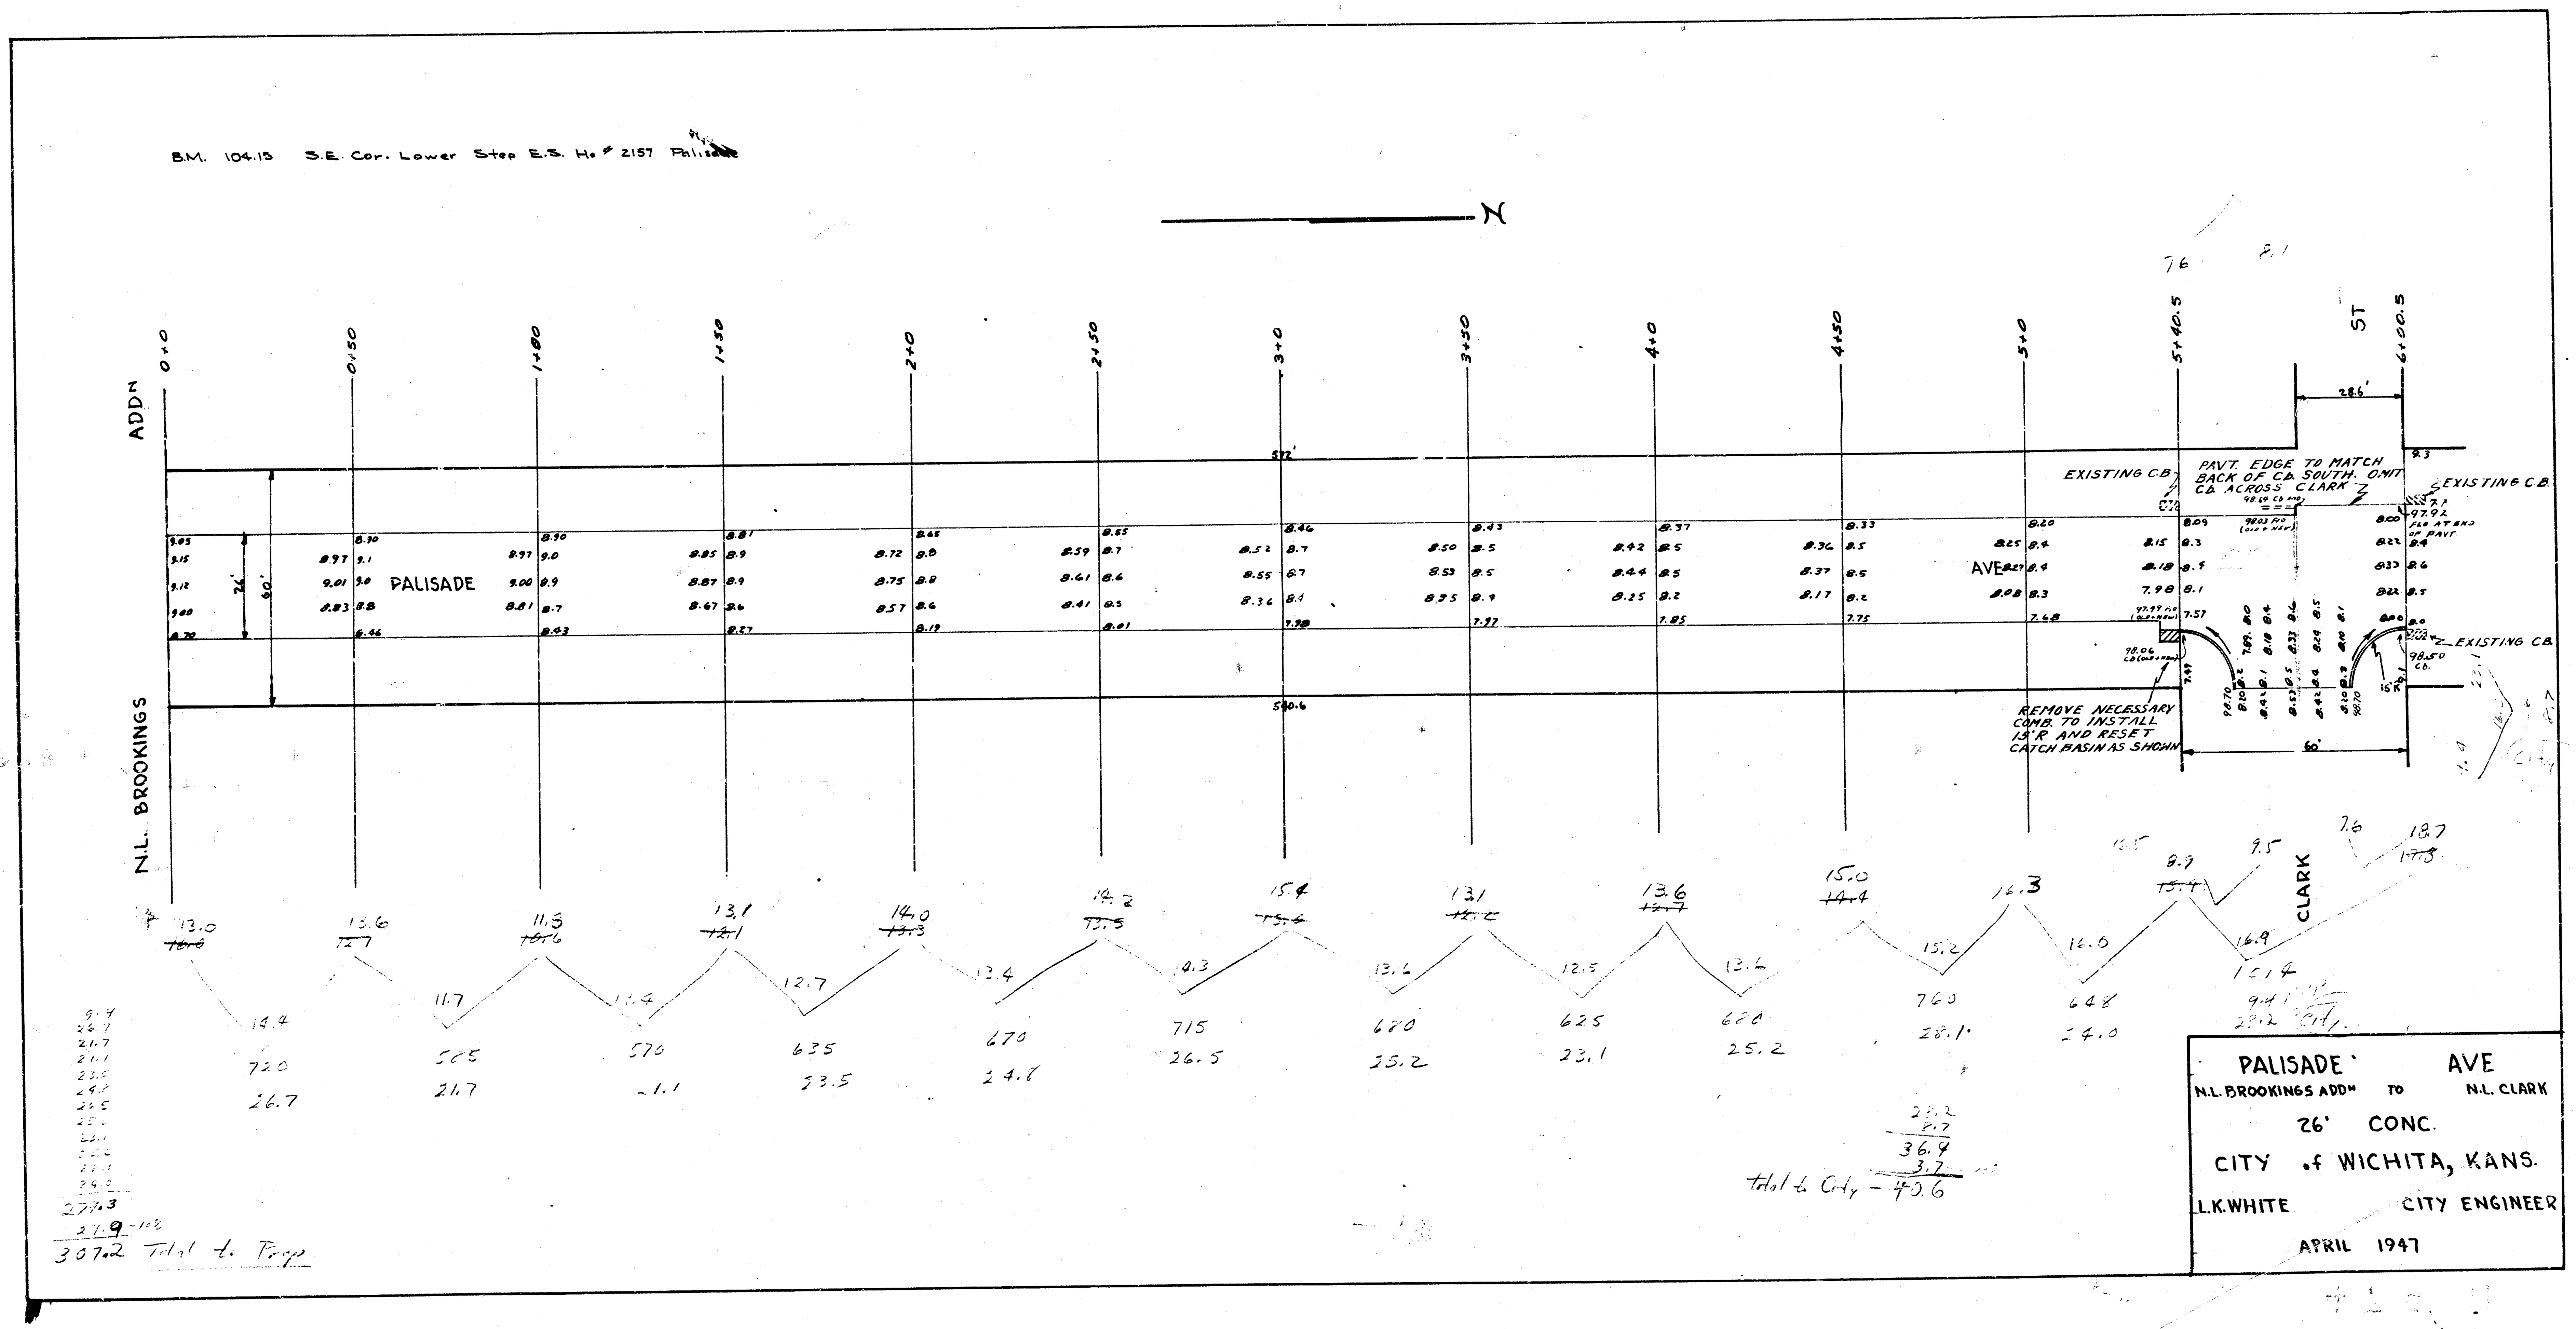


PALISADE AVE

N.L. BROOKINGS ADDN TO N.L. CLARK

26' CONC.

CITY of WICHITA, KANS.

L.K. WHITE CITY ENGINEER

APRIL 1947