


1942
 PALISADE AVE. — N.L. BROOK'S ADD. TO S.L. BROOK'S ADD.
 CONC. I.

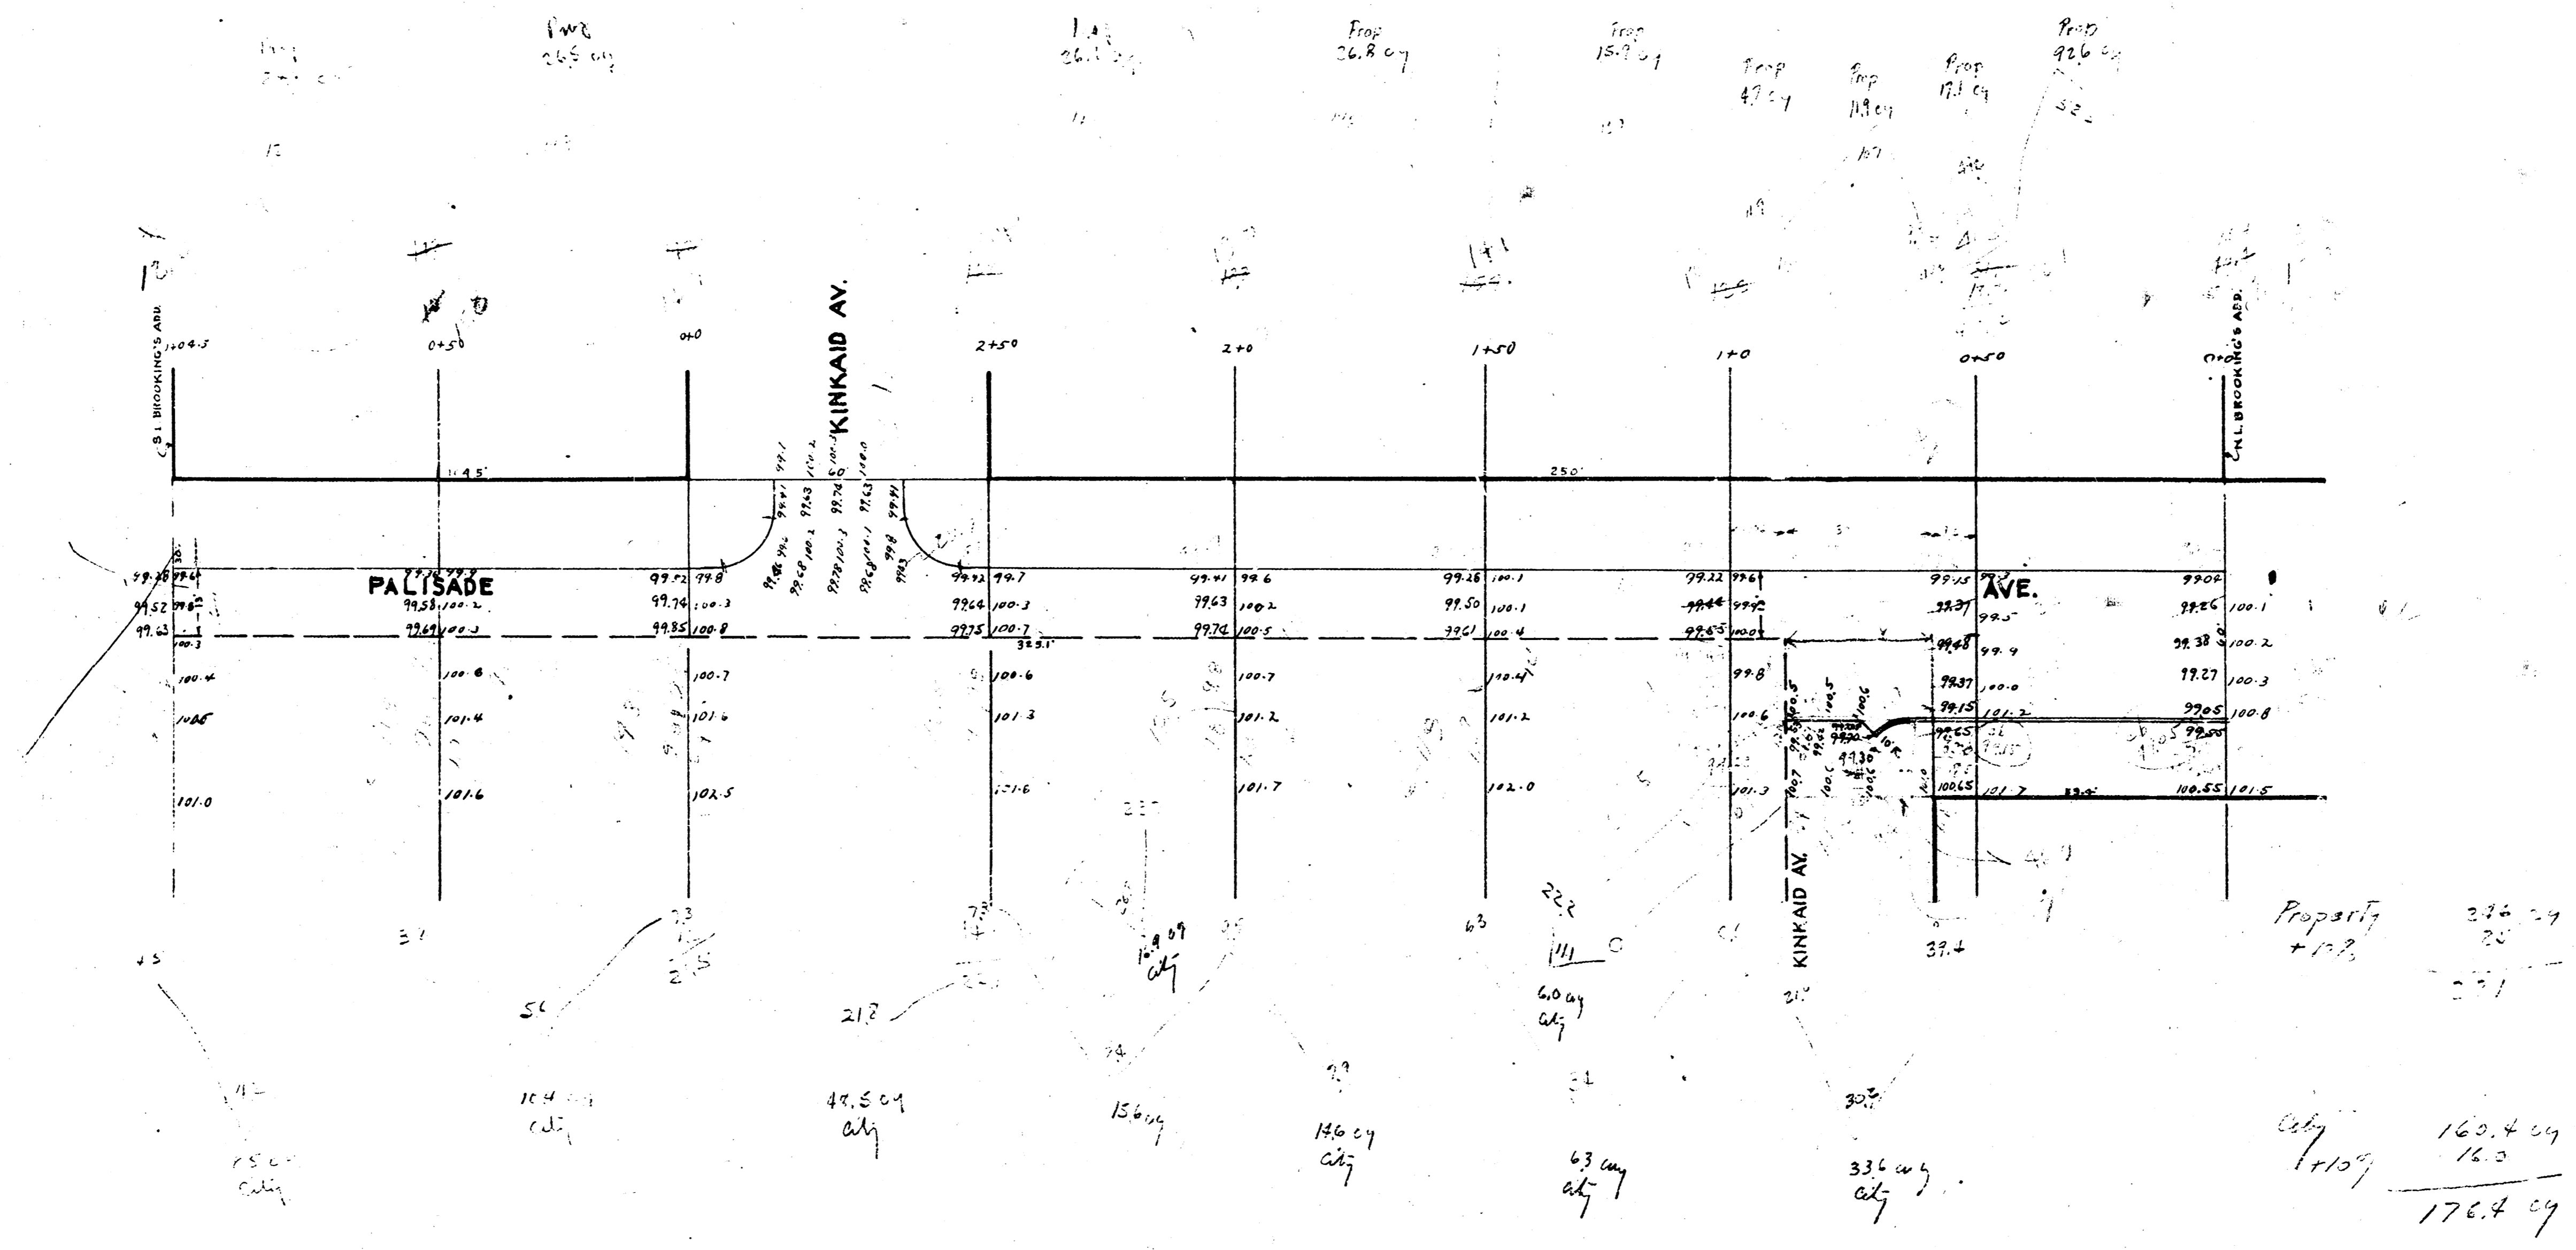

B.M. 10415 S.E. COR. LOWER STEP, E.S. No. 2157 PALISADE

PAVING PLAN
 1942
 PALISADE AVE.
 N.L. BROOK'S ADD
 TO S.L. BROOK'S ADD.