




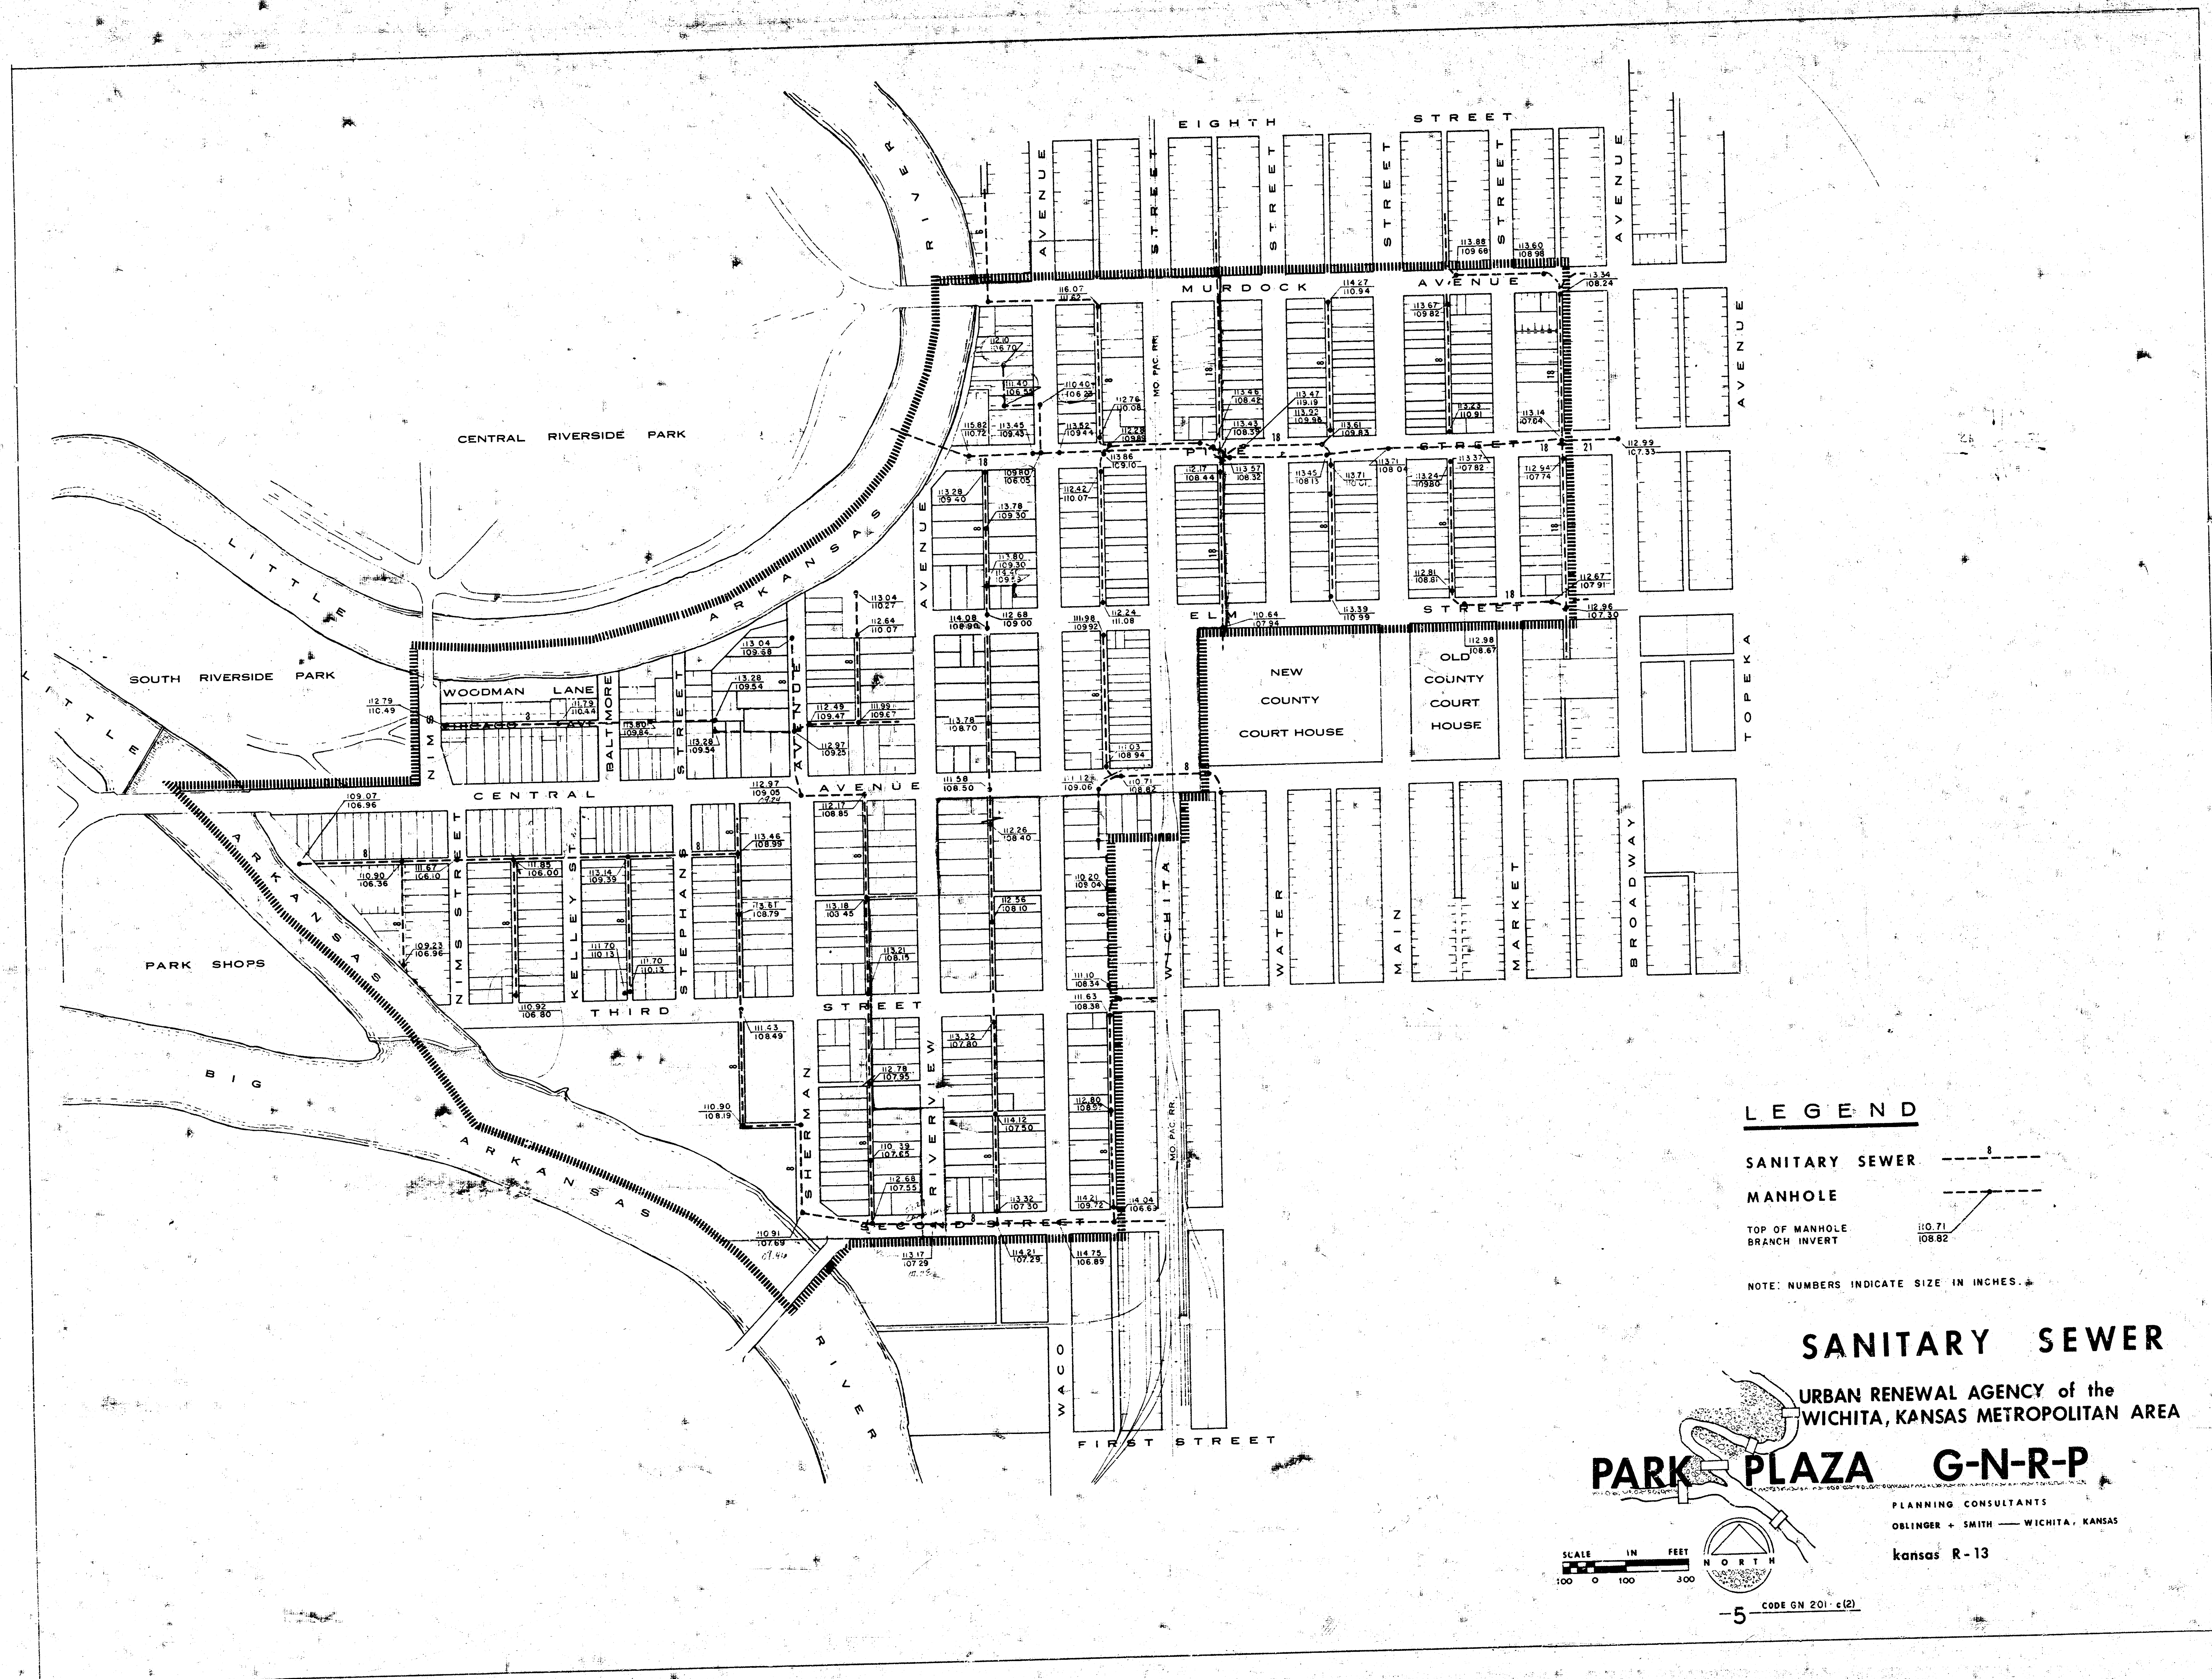

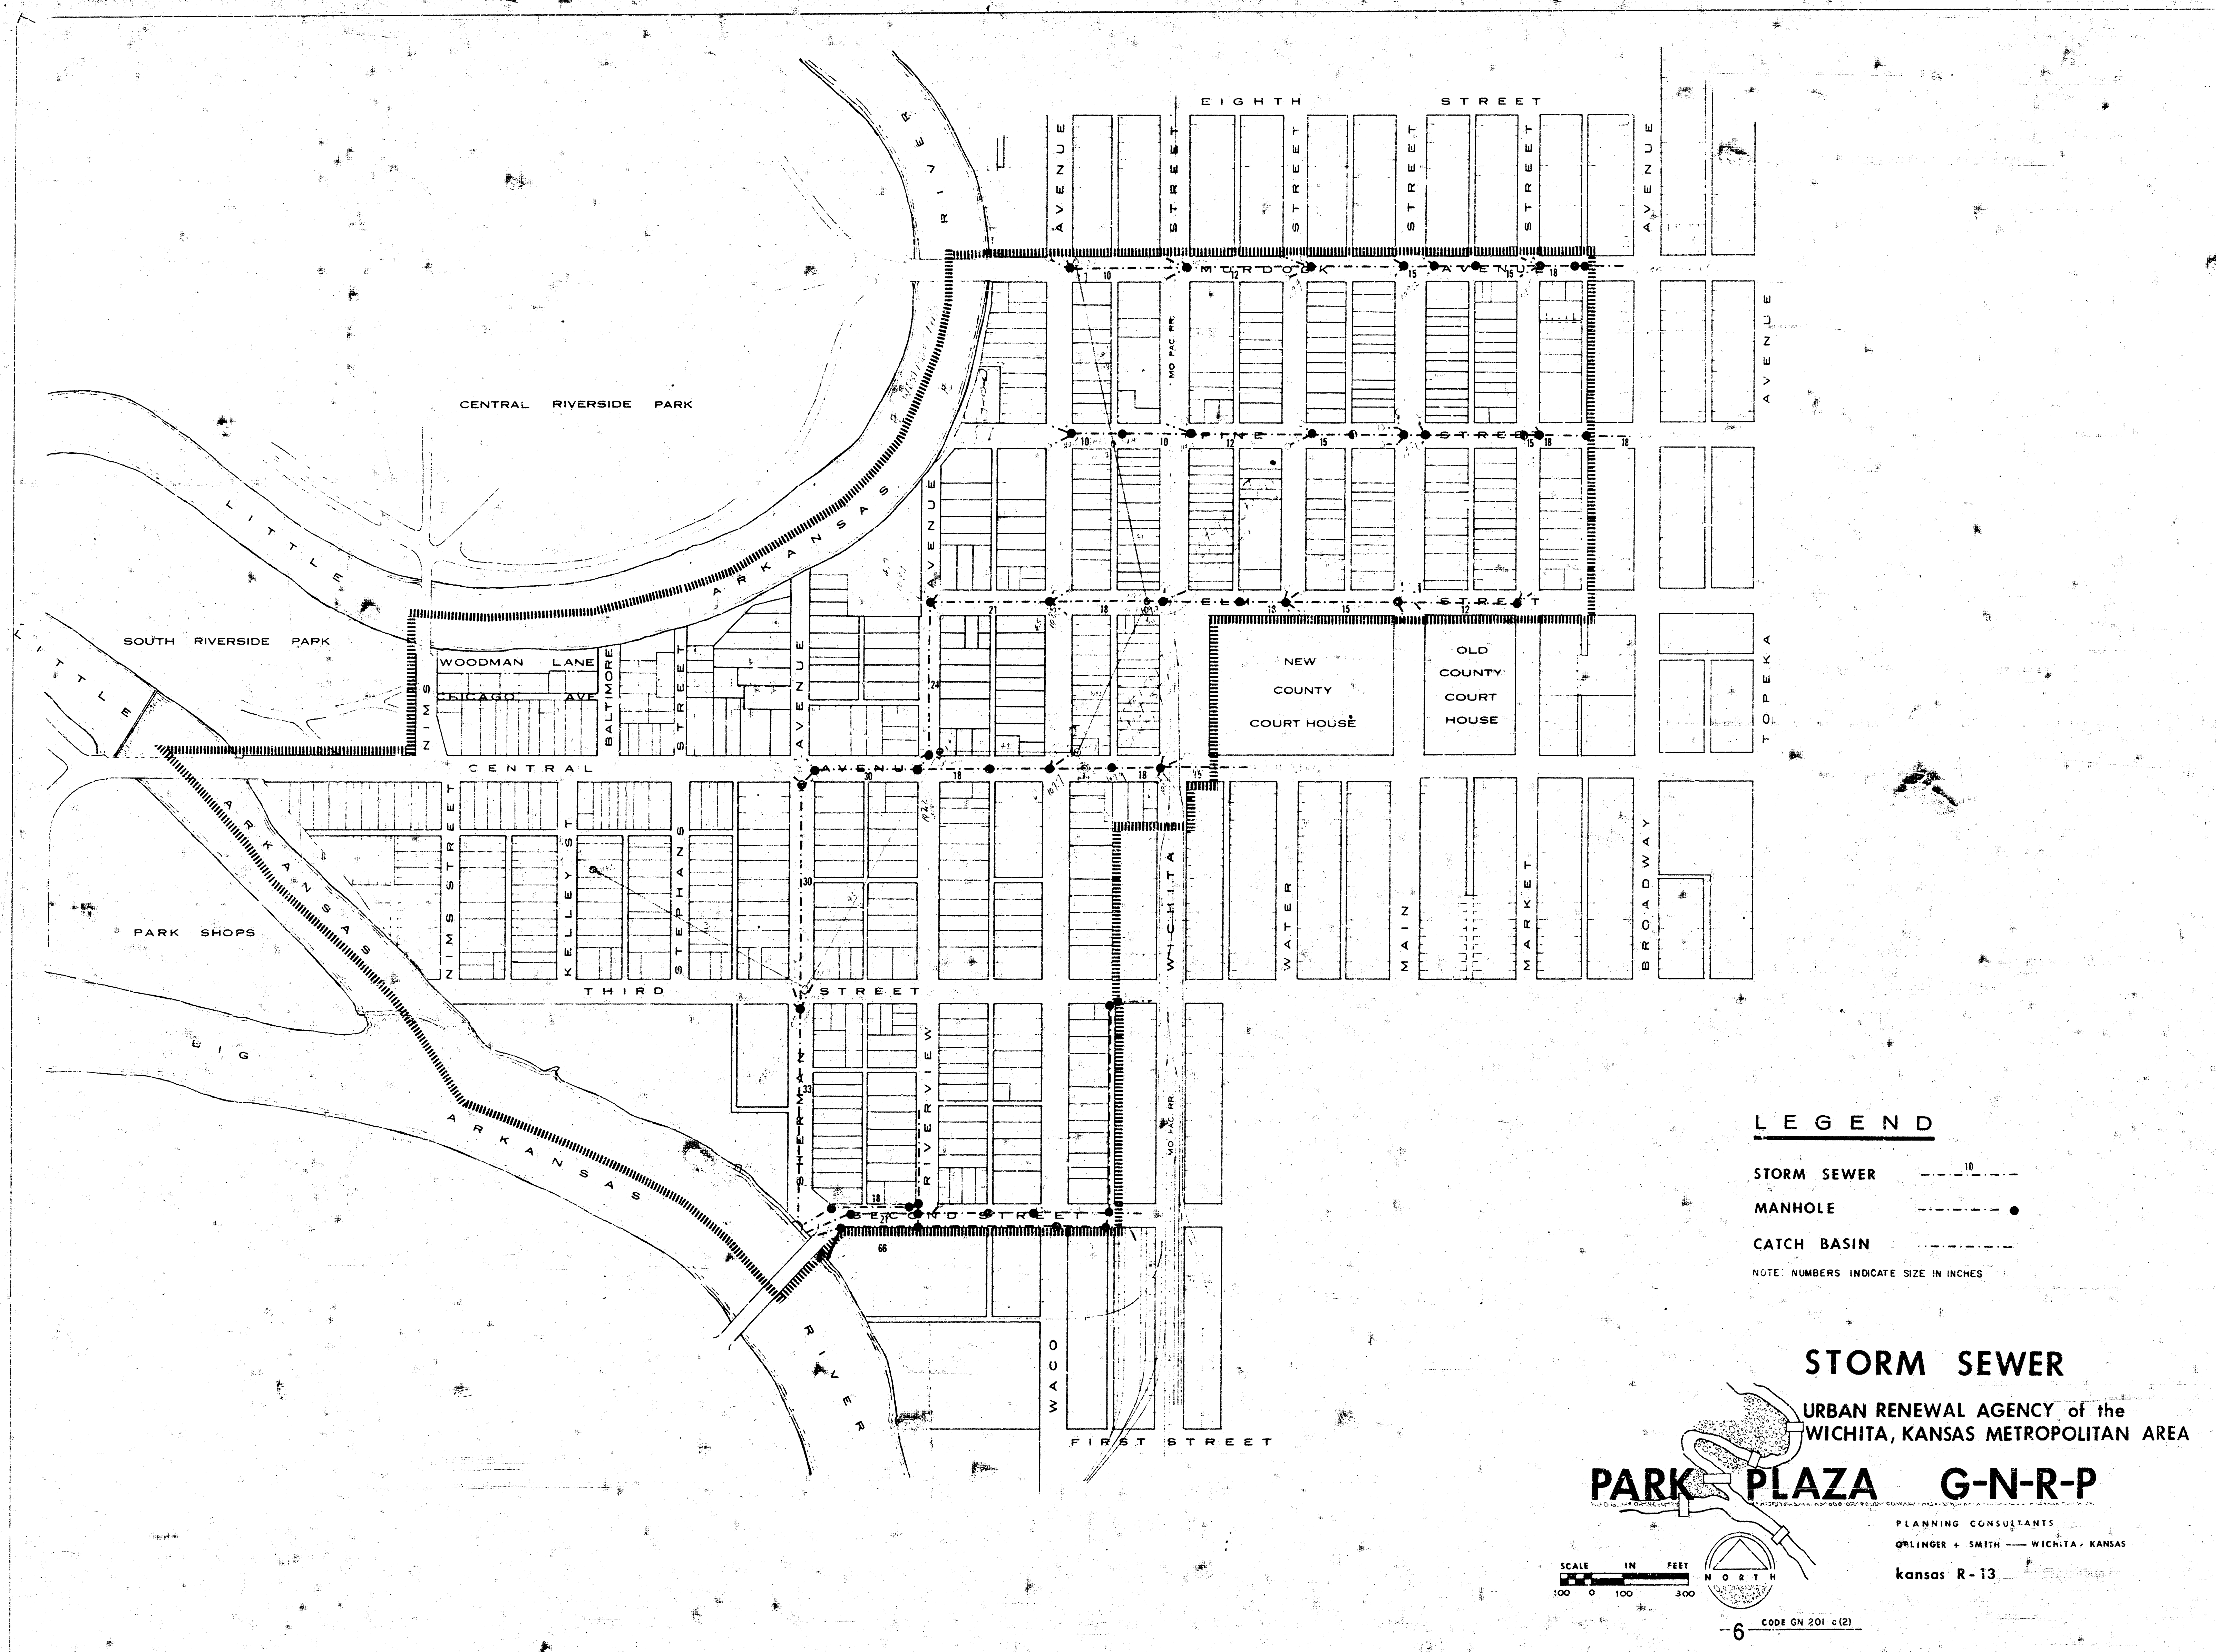

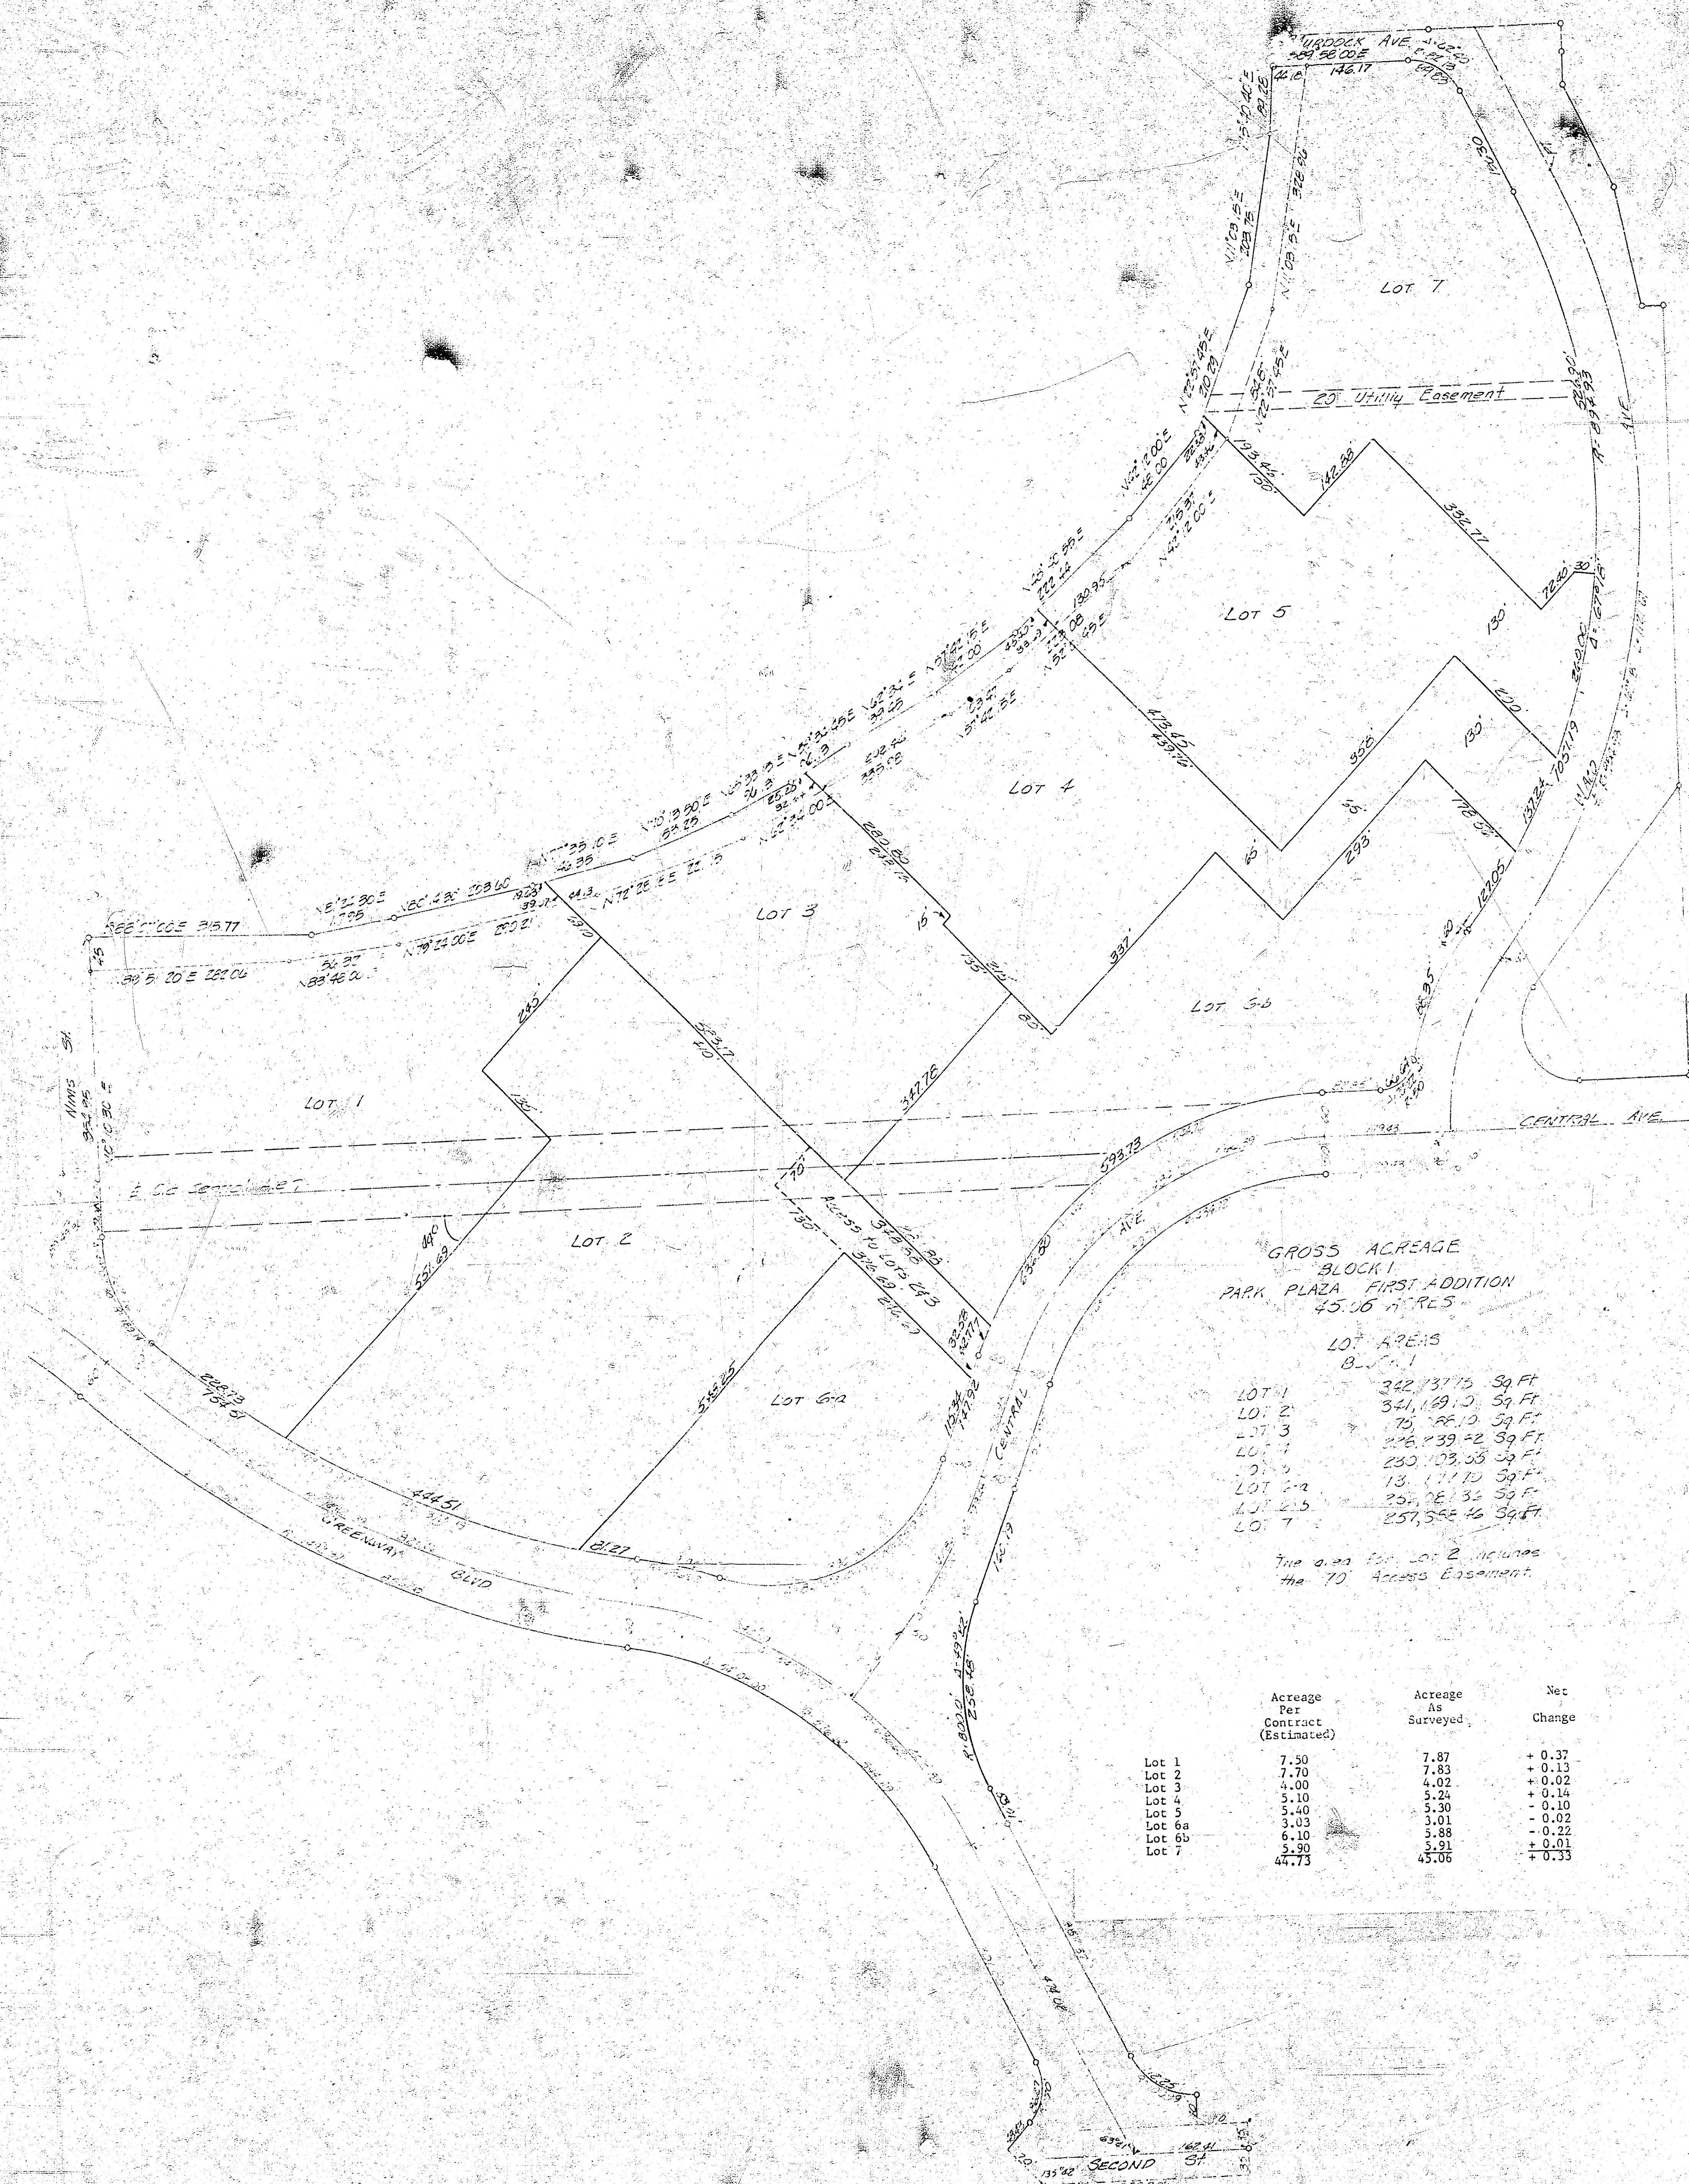

GROSS ACREAGE
BLOCK 1
PARK PLAZA FIRST ADDITION
45.06 ACRES

LOT AREAS
B.F.

LOT 1	342,737.75 Sq. Ft.
LOT 2	321,129.10 Sq. Ft.
LOT 3	70,266.10 Sq. Ft.
LOT 4	226,739.42 Sq. Ft.
LOT 5	230,103.00 Sq. Ft.
LOT 6	13,171.70 Sq. Ft.
LOT 7	257,565.46 Sq. Ft.

The area for Lot 2 includes
the 10' Access Easement.

	Area Per Contract (Estimated)	Area As Surveyed	Net Change
Lot 1	7.50	7.87	+ 0.37
Lot 2	7.70	7.83	+ 0.13
Lot 3	4.00	4.02	+ 0.02
Lot 4	5.10	5.24	+ 0.14
Lot 5	5.40	5.30	- 0.10
Lot 6	1.03	1.01	- 0.02
Lot 7	6.10	5.88	- 0.22
	44.73	45.06	+ 0.33