



Prop. is base for 1/2 of
 Parking area only

Stationing is on Center-Line Distances

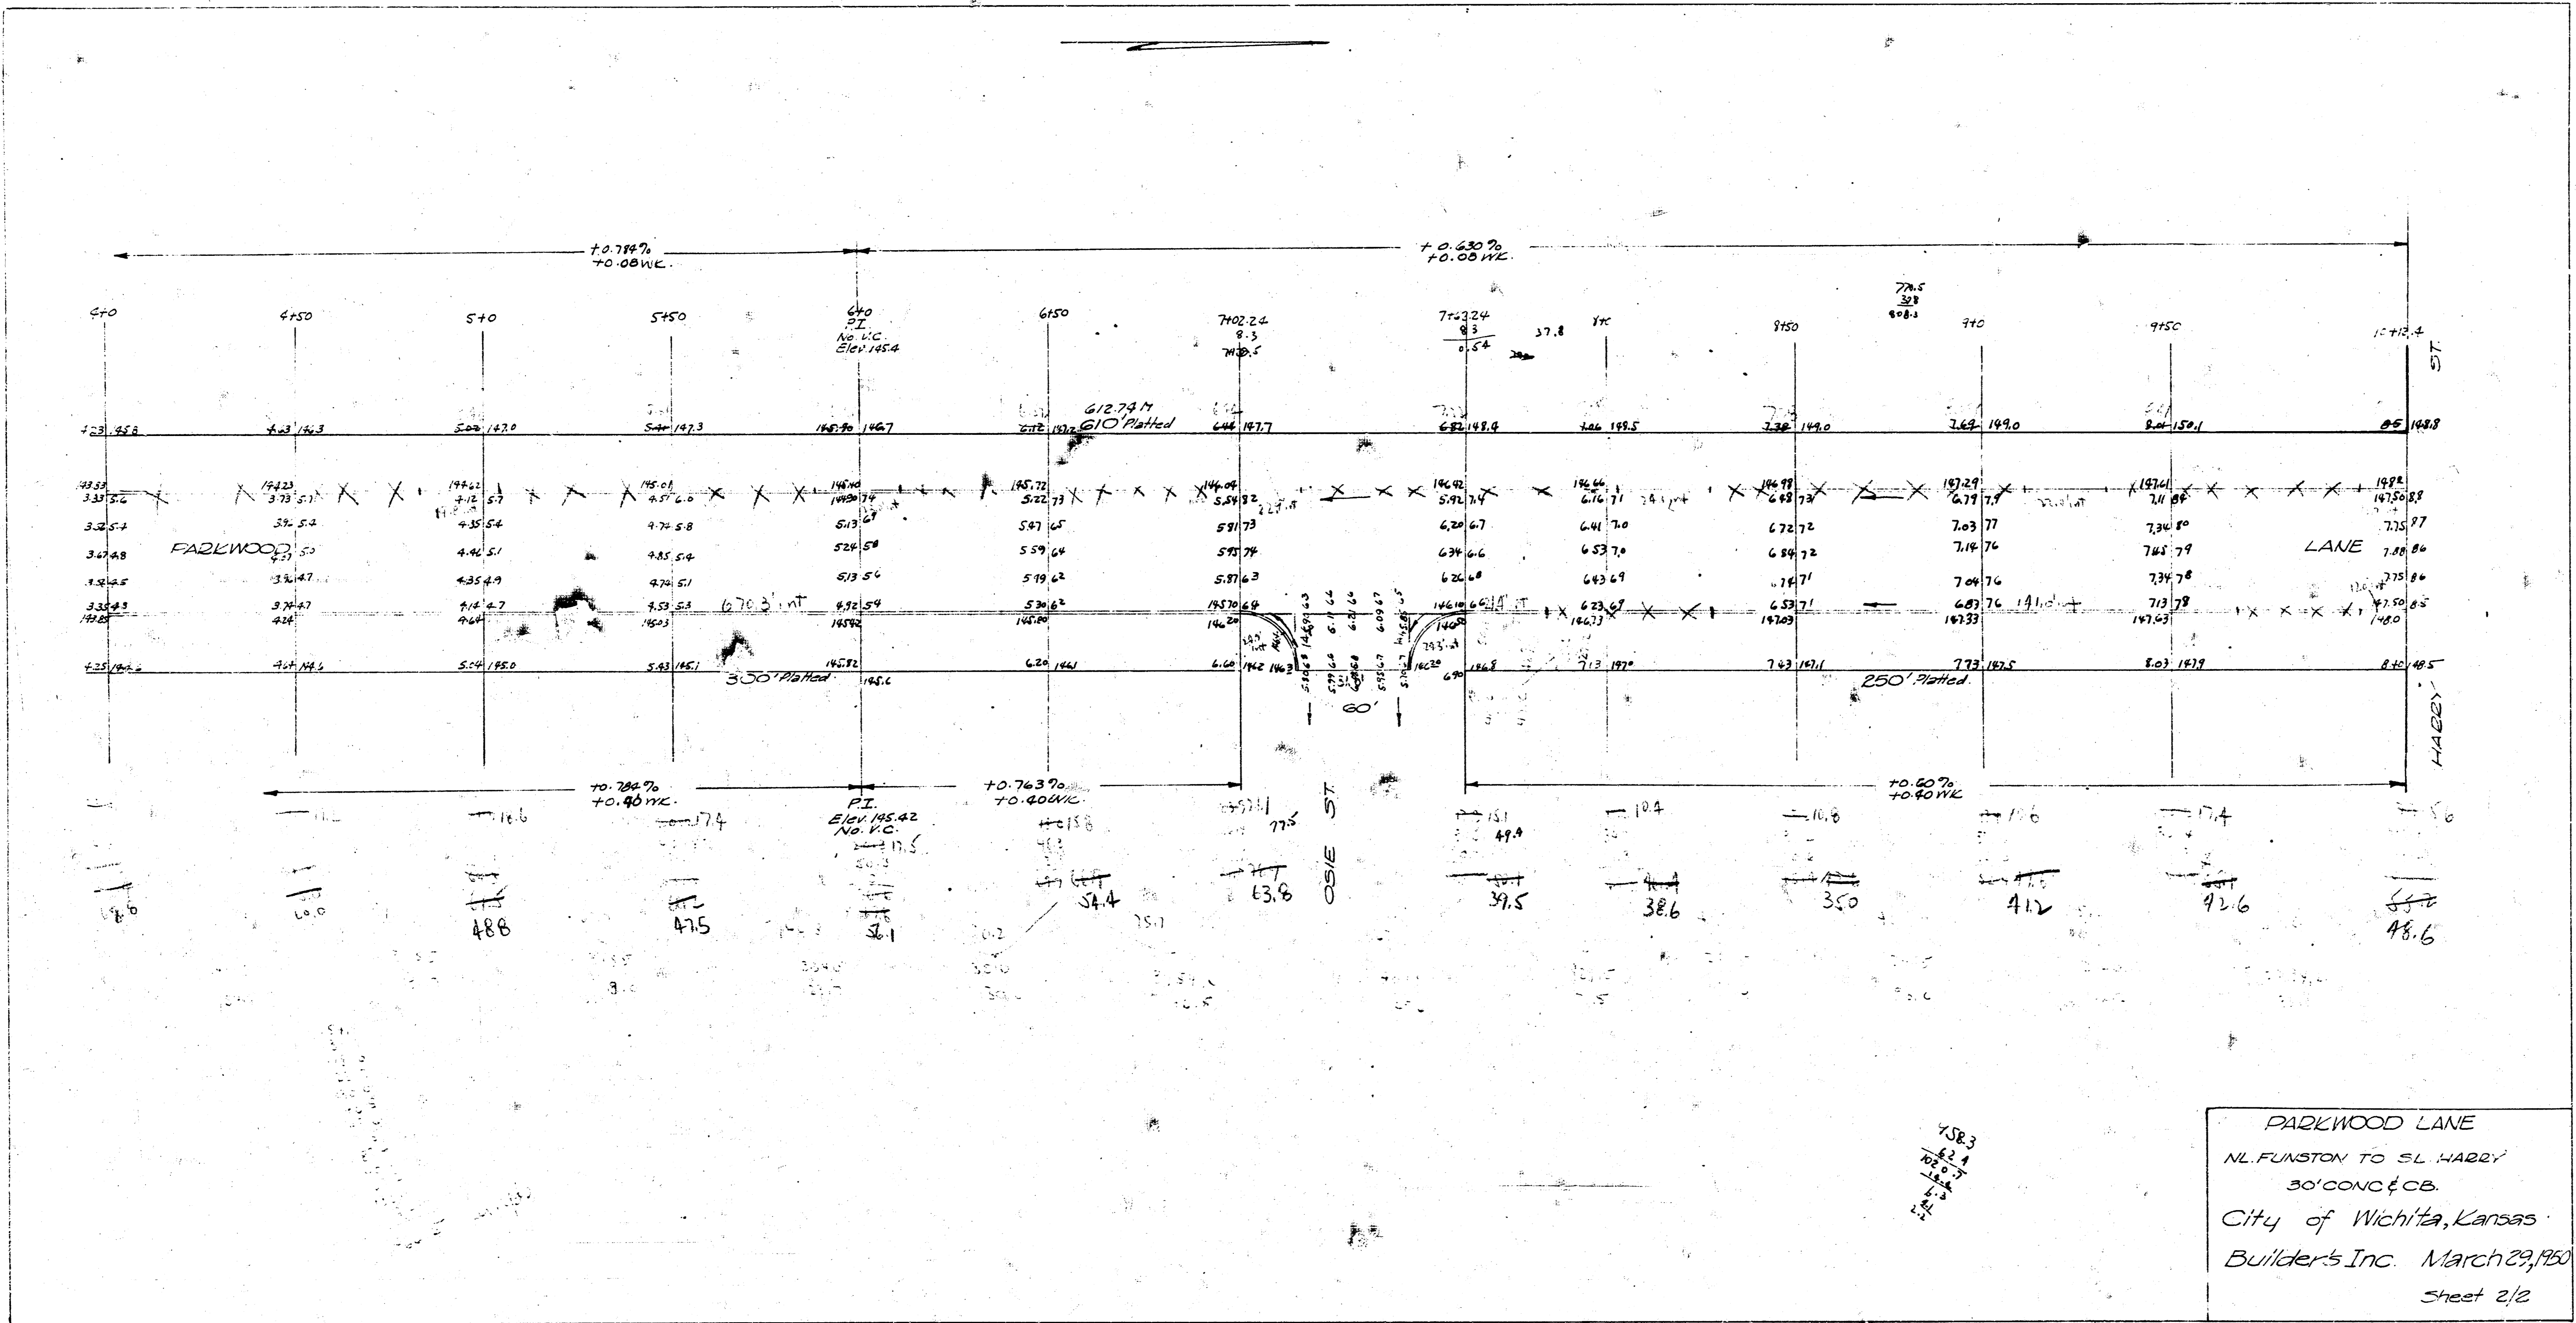

PARKWOOD LANE
 N.L. FUNSTON TO S.L. HARRY
 30' CONC & CB.
 City of Wichita, Kansas
 Builder's Inc. March 29, 1950
 Sheet 2/2

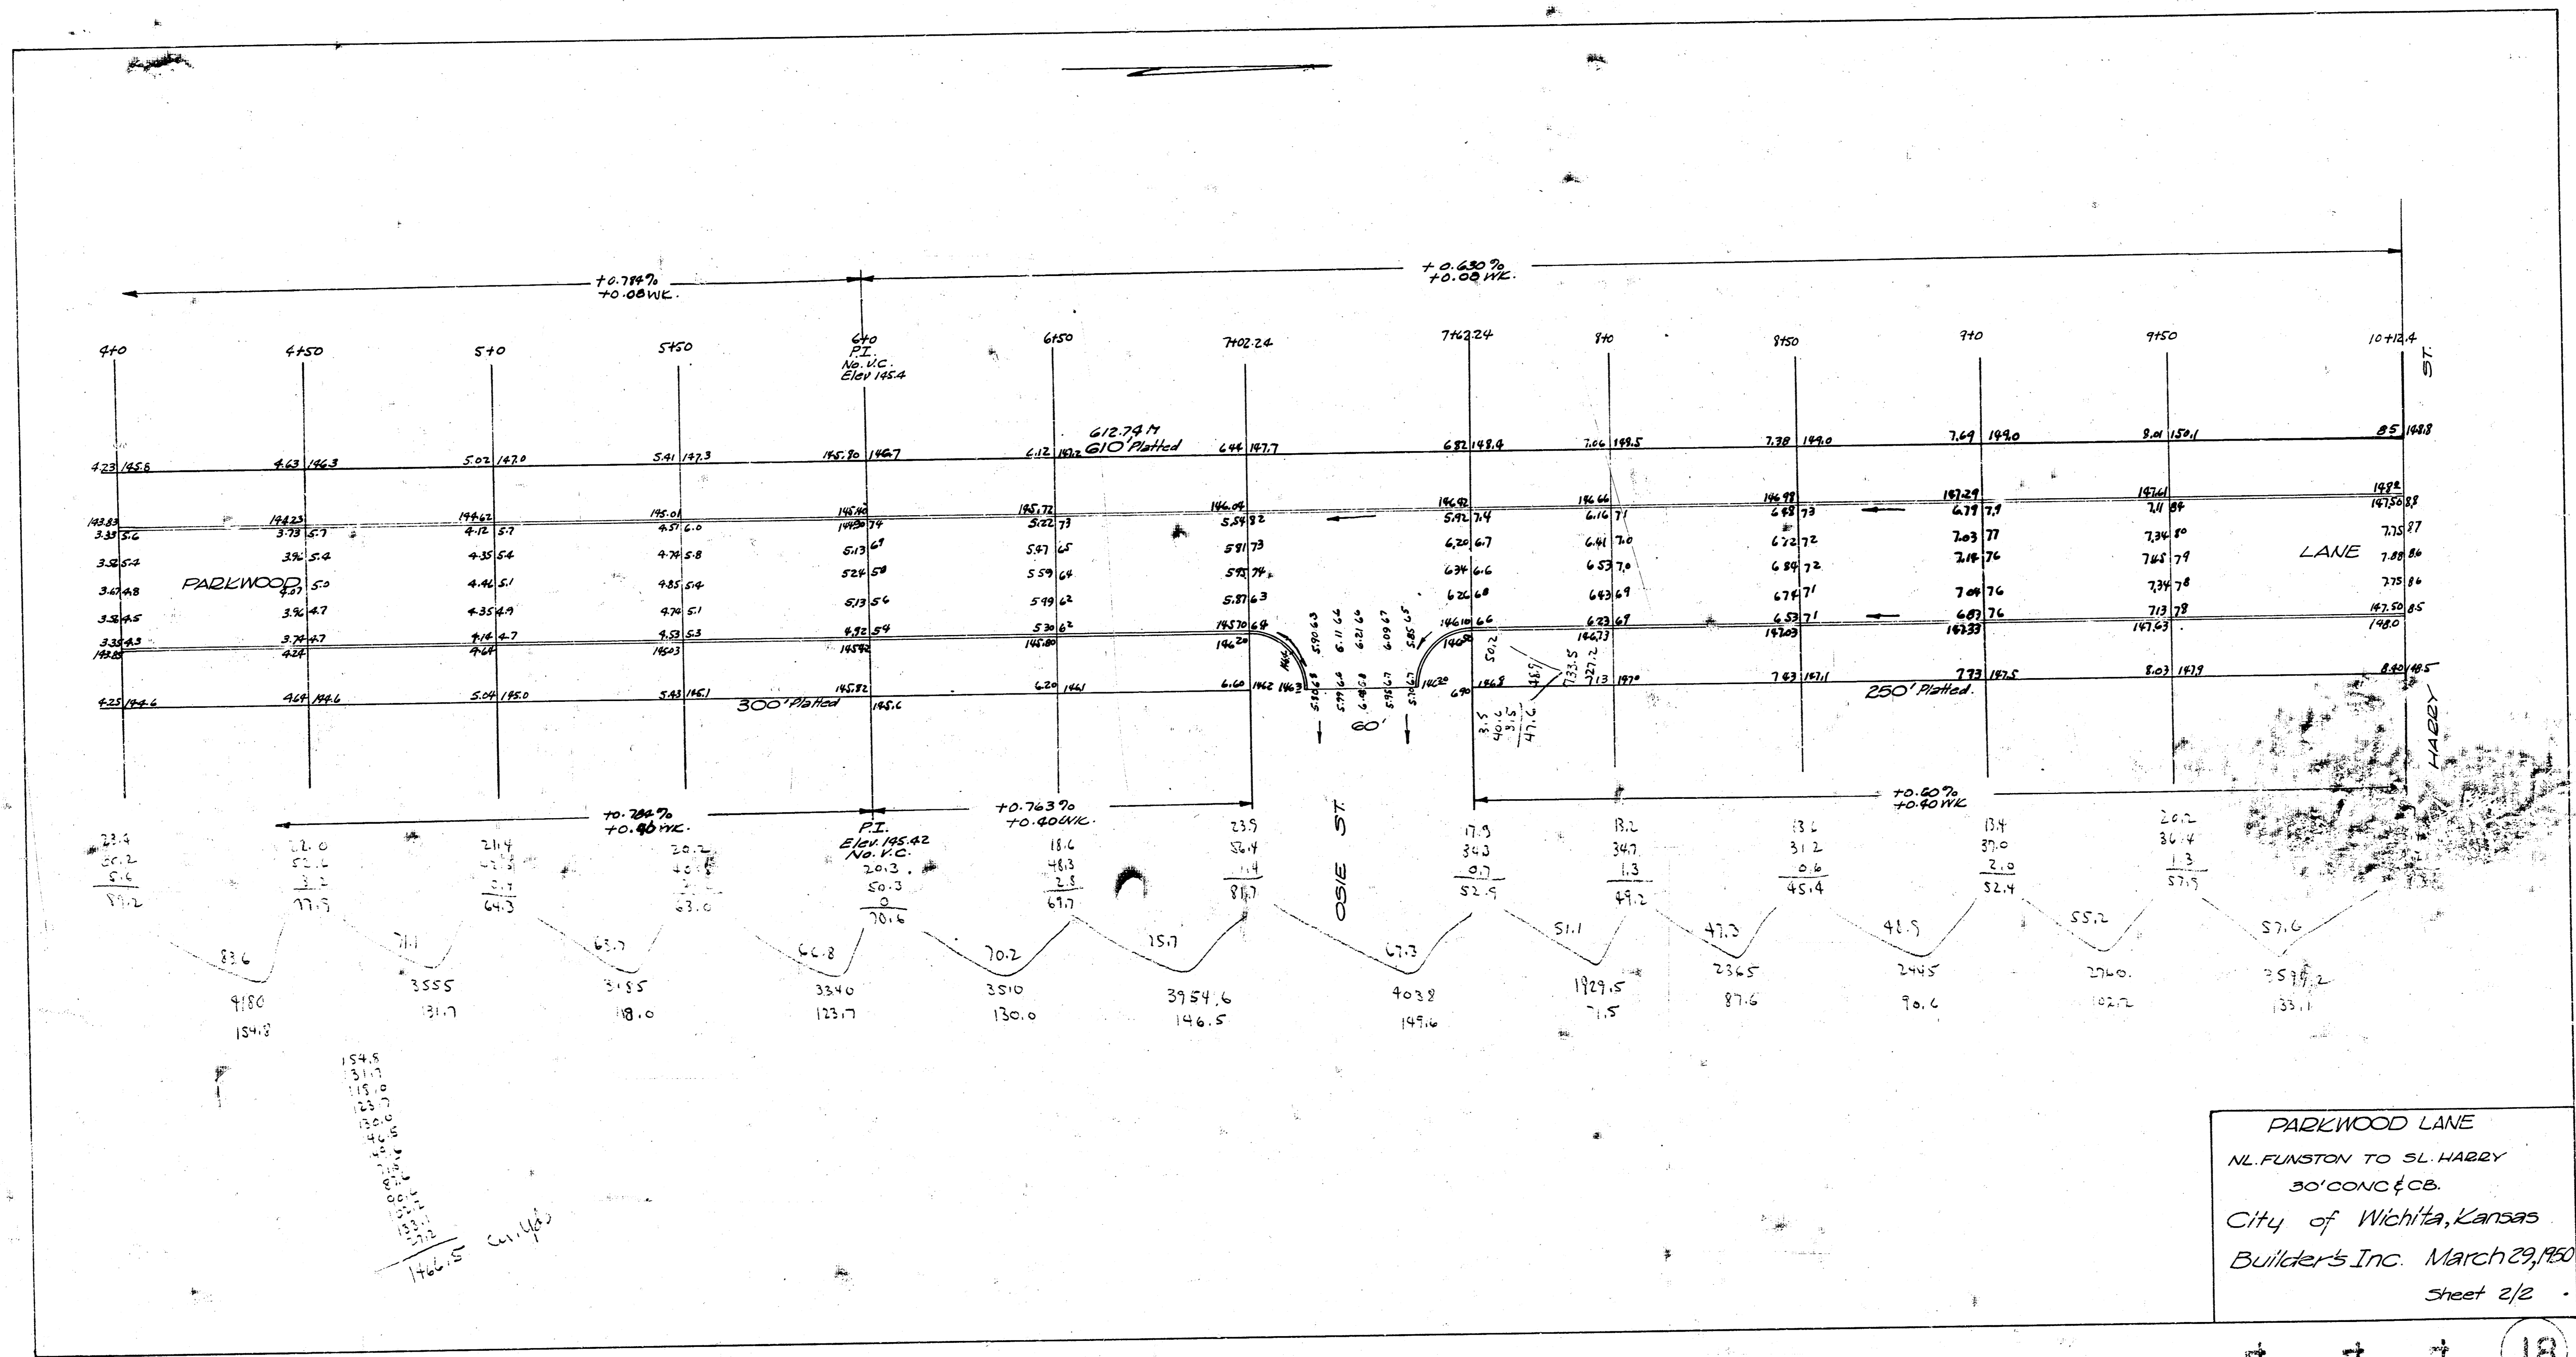




949.5
+ 1070
1029.5



SCALE 1"=20'

CHAINING N. ON E. R.
BM 130.61 "B" IN BUILDING E. W. NE CORNER MT. VERNON & OLD MANOR
BM 131.51 "M" IN MUELLER FIRE HYD. NW CORNER PARKWOOD & MT. VERNON

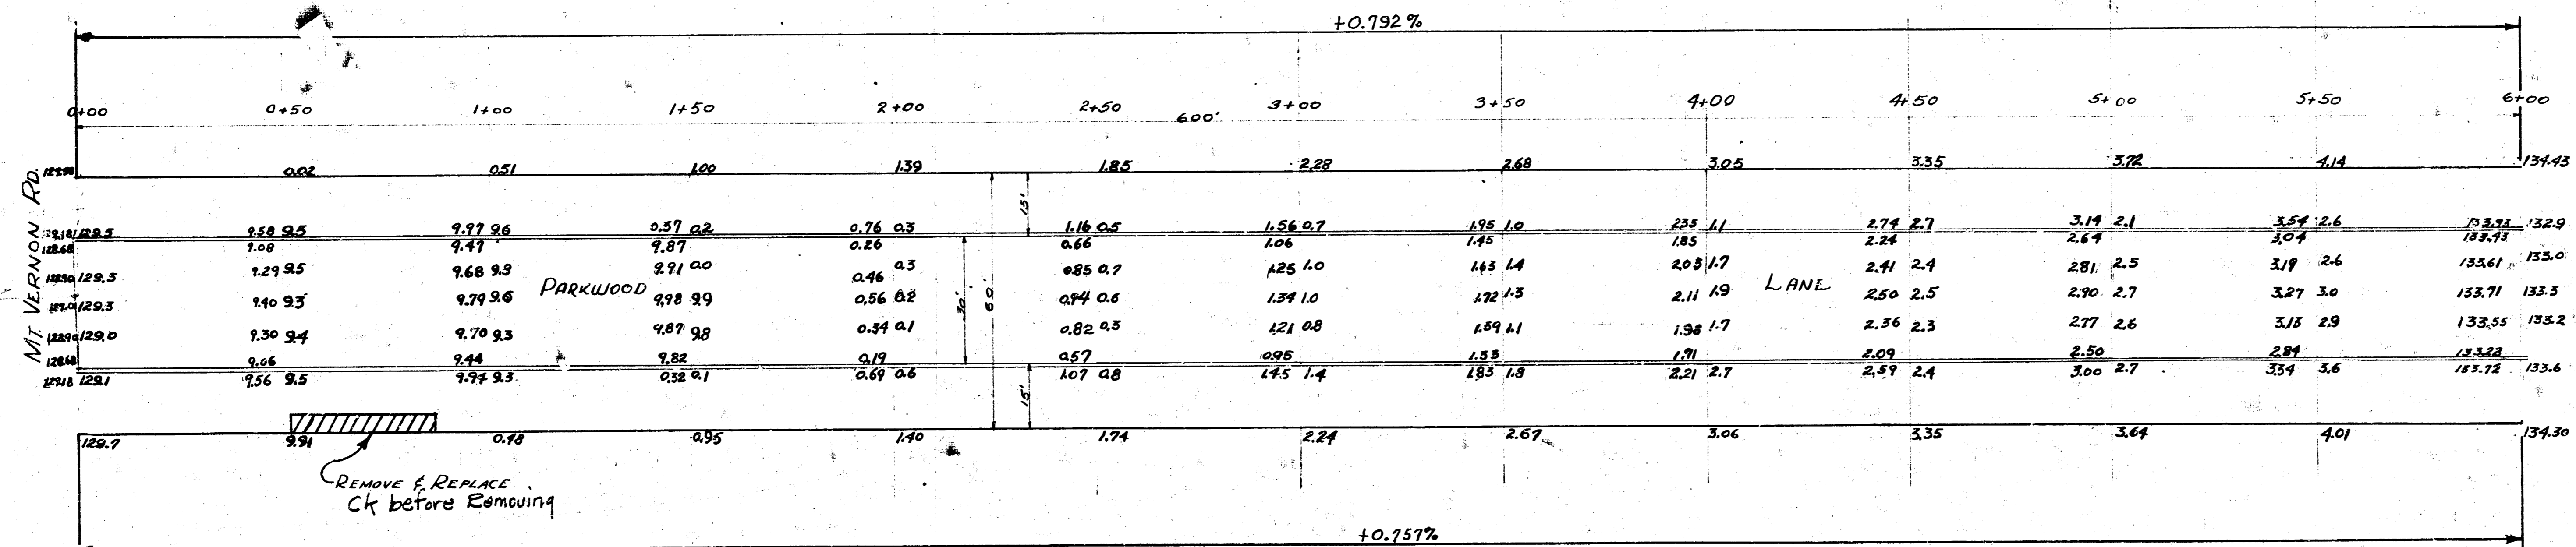

MT VERNON RD

PARKWOOD LANE

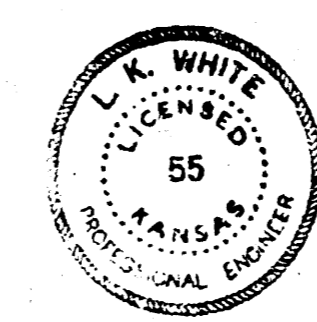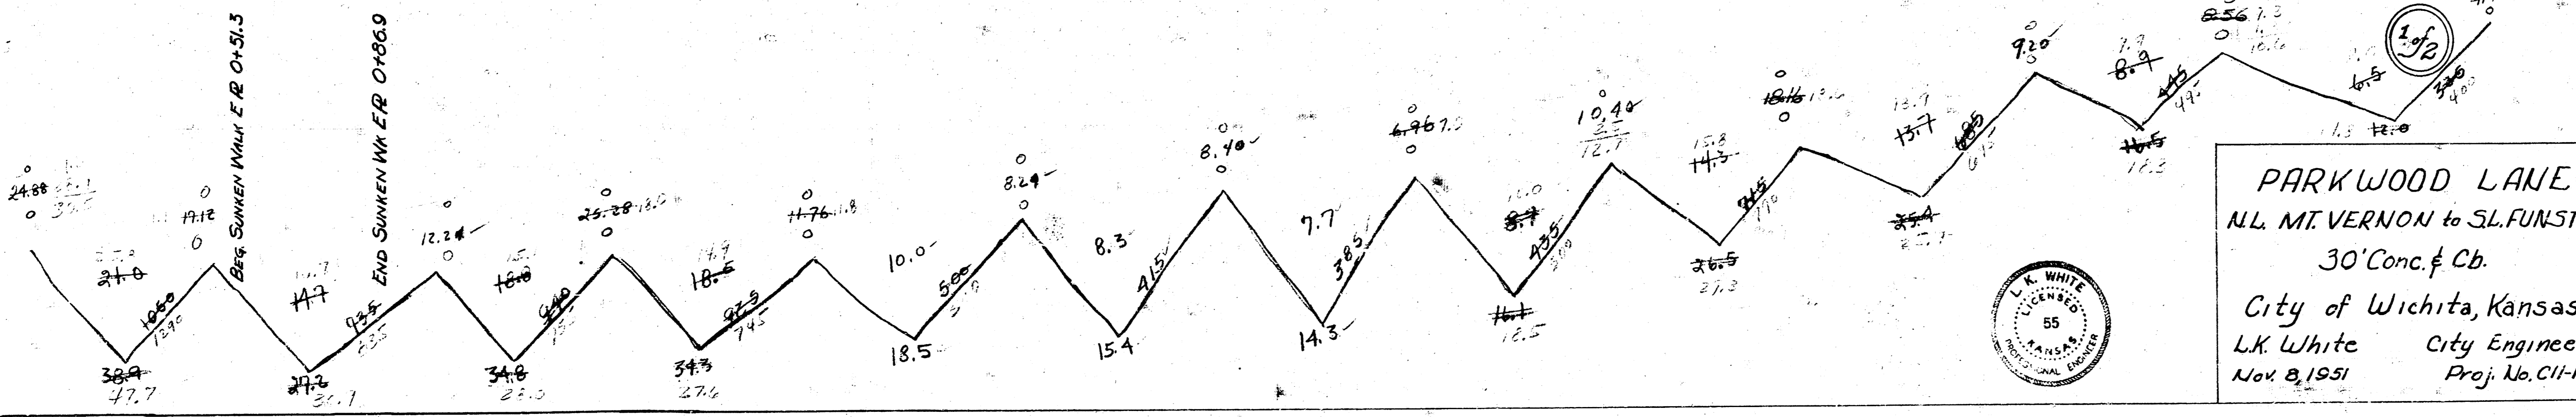

PARKWOOD LANE
N.W. MT. VERNON to S.W. FUNSTON
30' Conc. & Cb.
City of Wichita, Kansas
L.K. White City Engineer
Nov. 8, 1951 Proj. No. C11-118

