

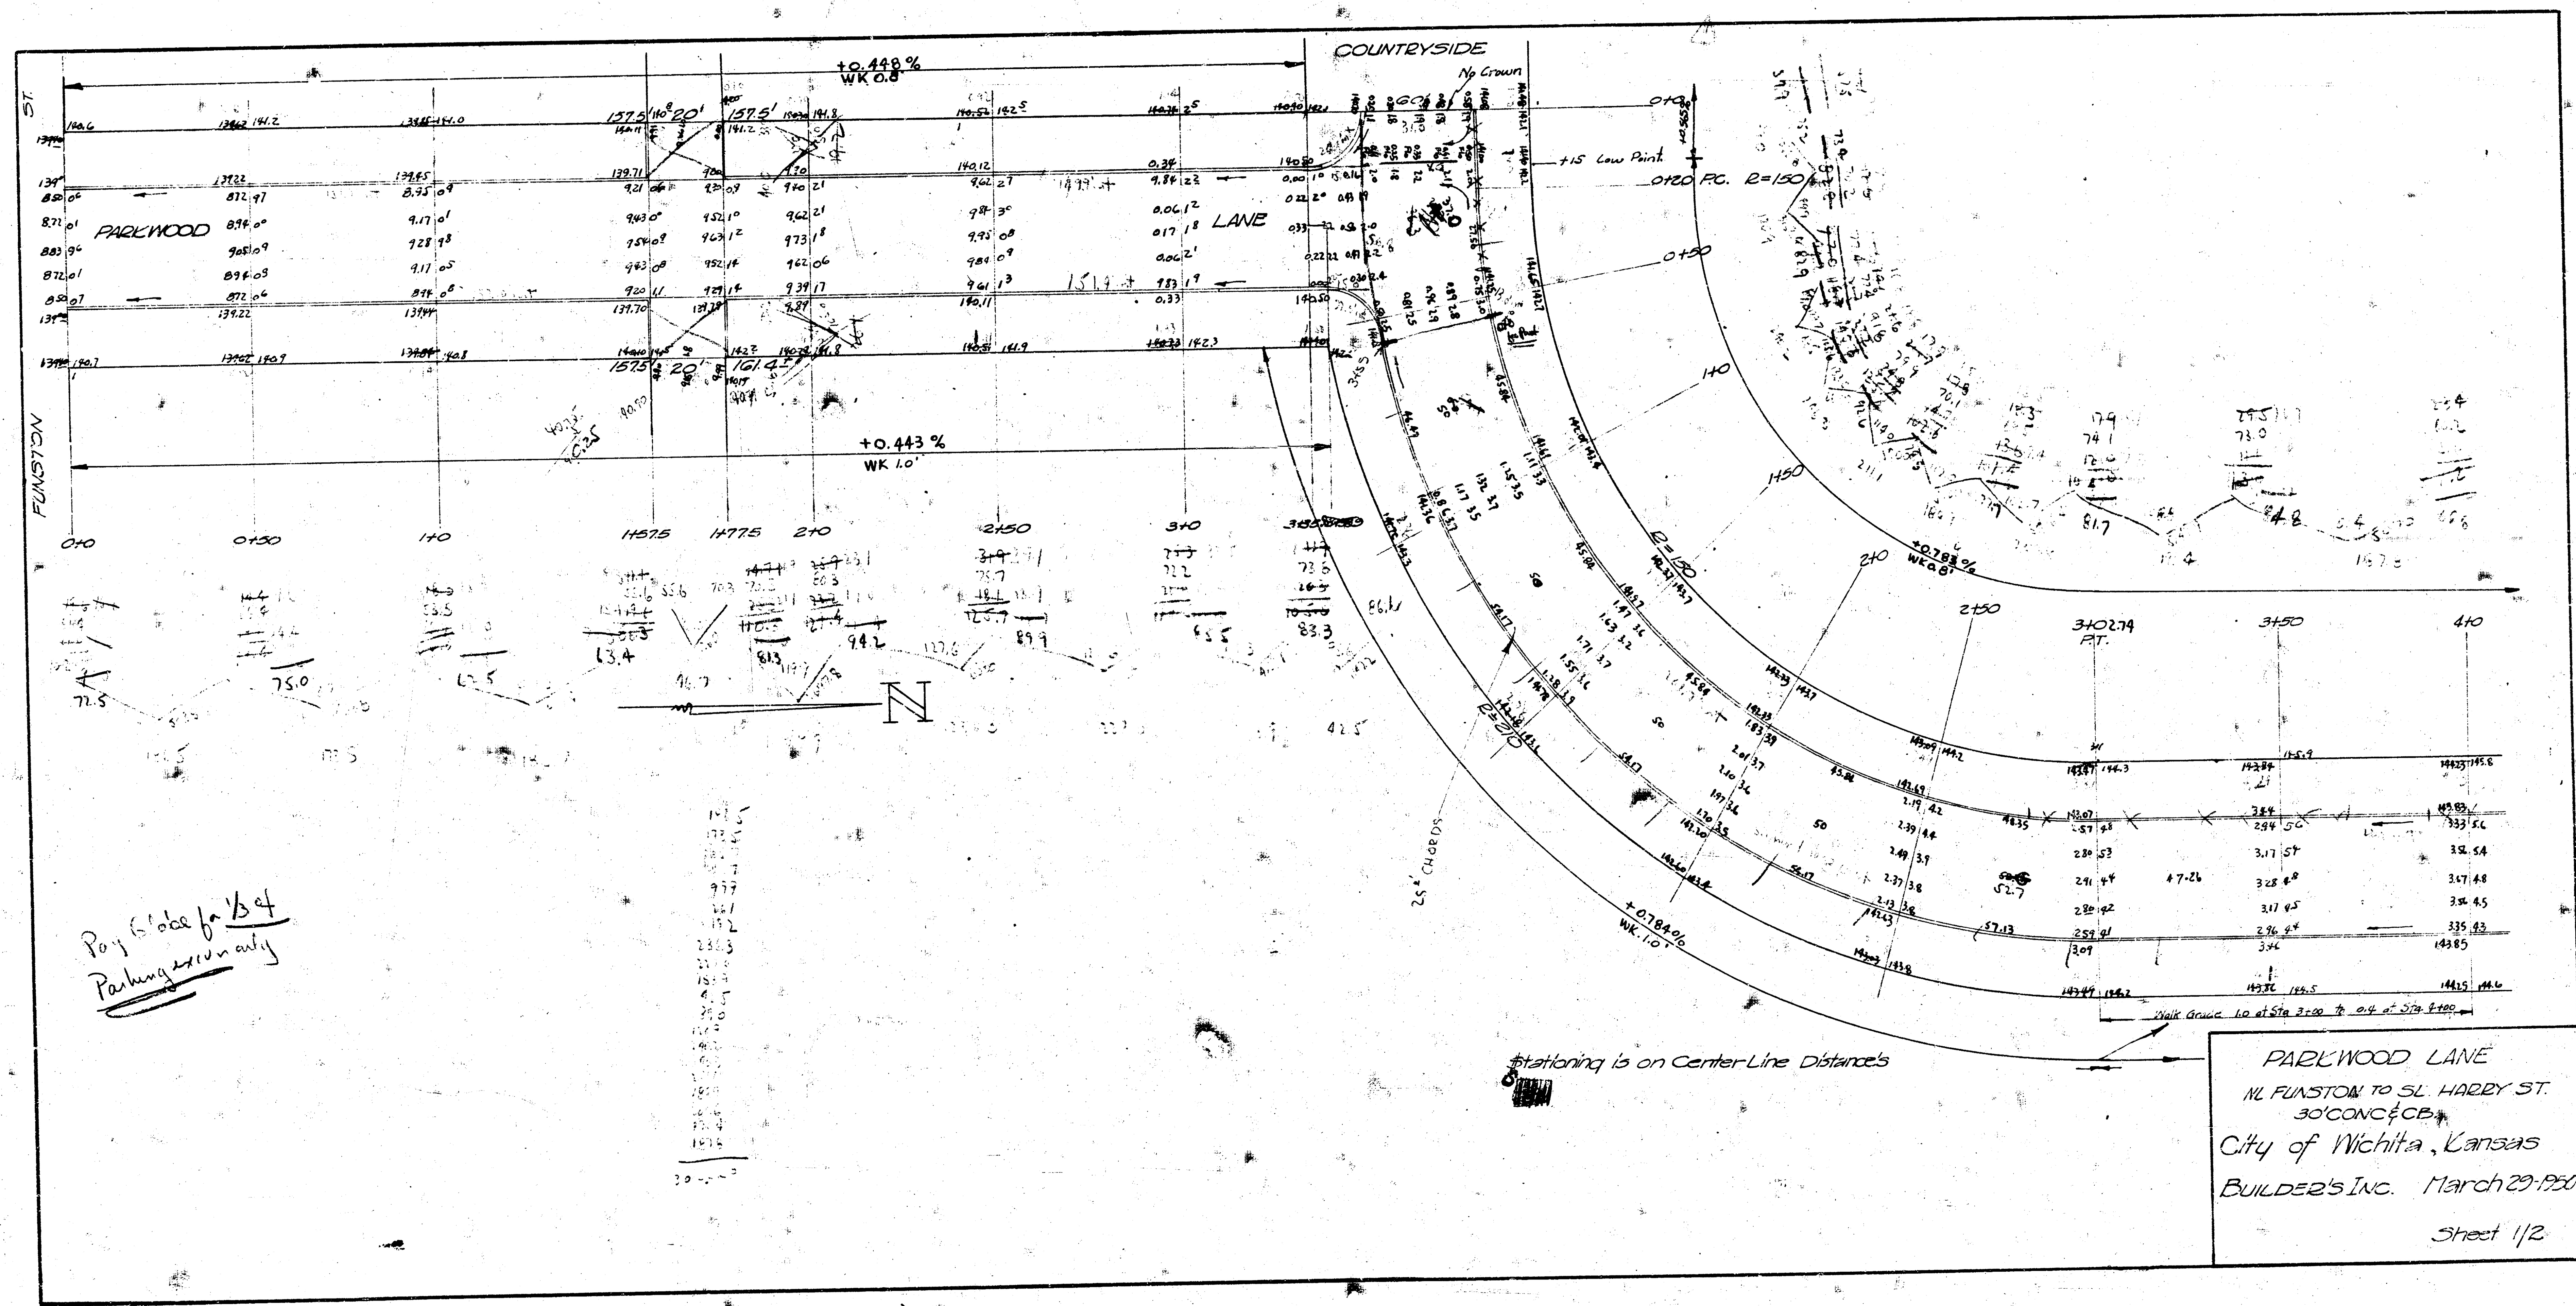
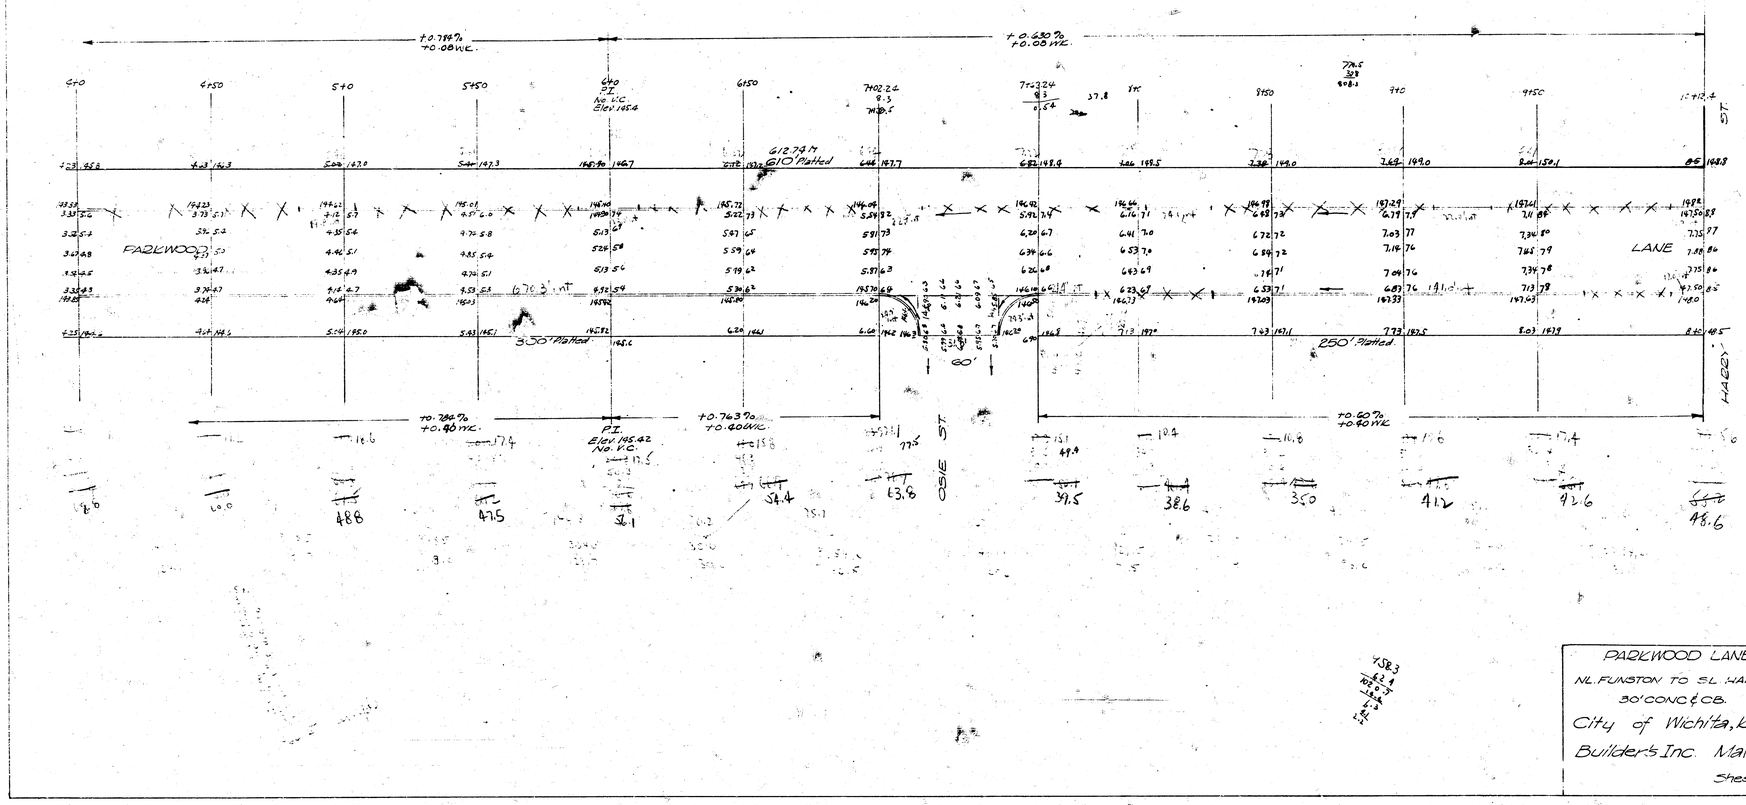


COUNTRYSIDE
No Crown
+15 Low Point
0+20 P.C. R=150
PARKWOOD
LANE
FUNSTON
ST.
+0.448 %
WK 0.8'
+0.443 %
WK 1.0'
0+0
0+50
1+0
1+57.5
1+77.5
2+0
2+50
3+0
+0.783 %
WK 0.8'
+0.784%
WK. 1.0'
R=150
R=210
25' CHORDS
3+02.74
P.T.
3+50
4+0
Walk Grade 1.0 at Sta 3+00 to 0.4 at Sta 4+00
Stationing is on Center-Line Distance's
Pay Grade for 1/3 of Parking extension only
PARKWOOD LANE
NL FUNSTON TO SL HARRY ST.
30'CONC&CB.
City of Wichita, Kansas
BUILDER'S INC. March 29-1950
Sheet 1/2

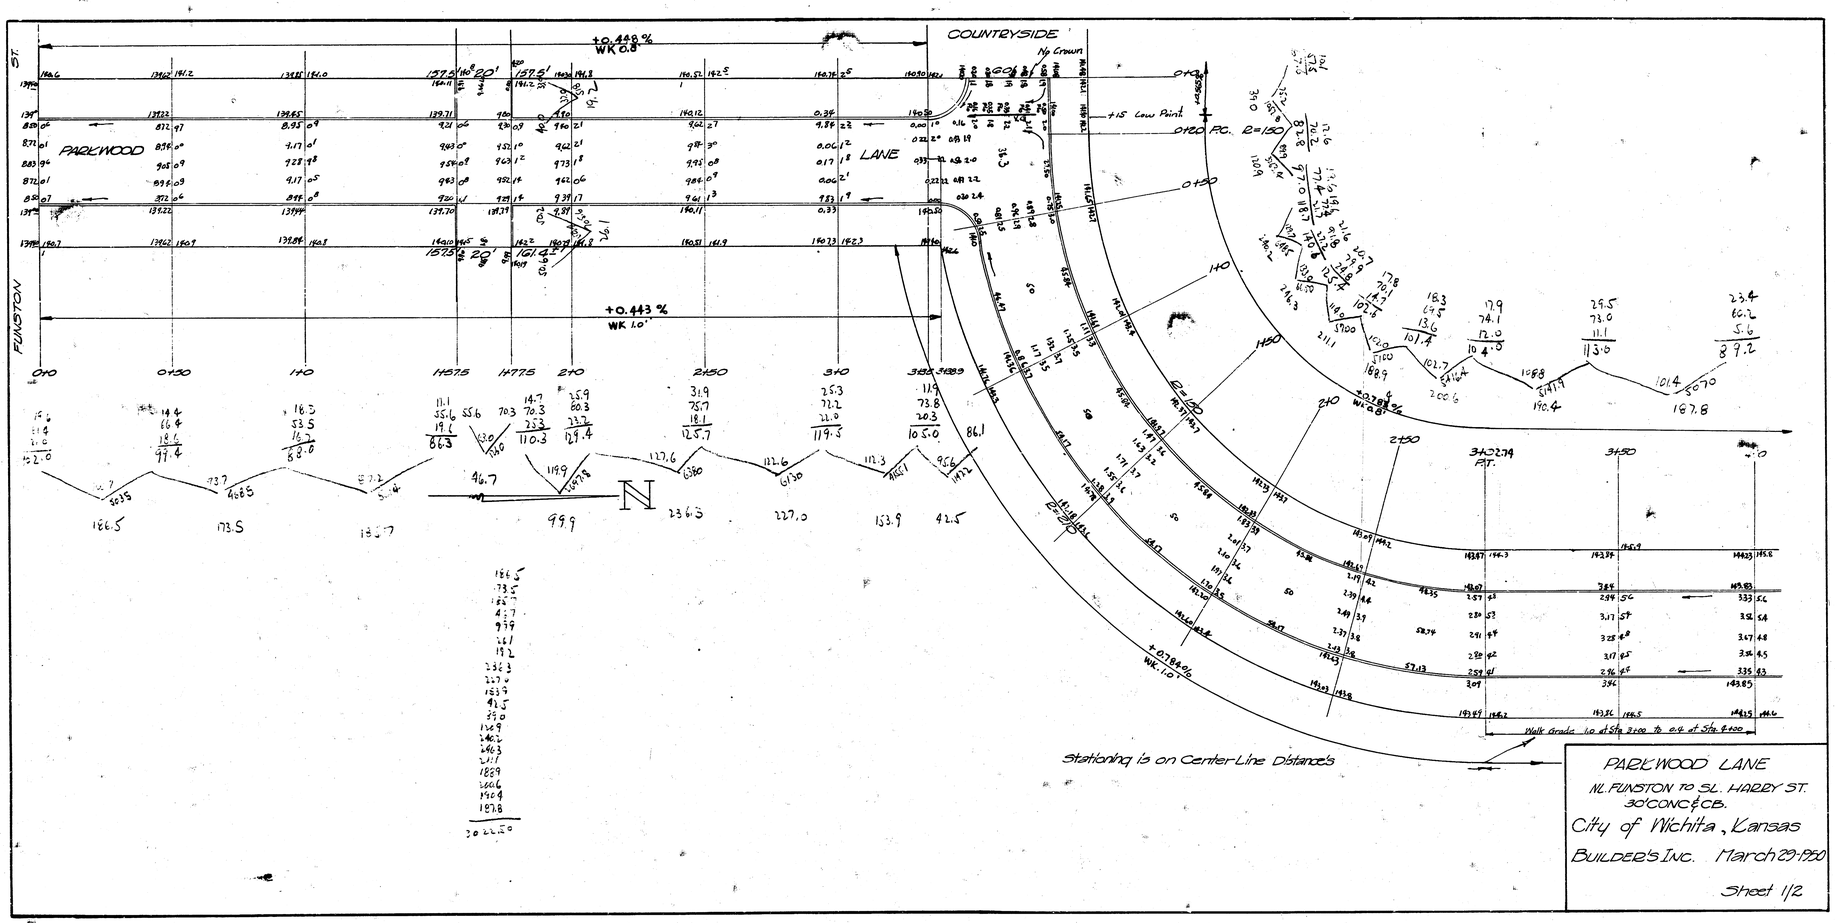

PARKWOOD LANE
NL FUNSTON TO SL HARRY
30' CONC & CB.
City of Wichita, Kansas
Builder's Inc. March 29, 1950
Sheet 2/2


COUNTRYSIDE
PARKWOOD
LANE
FUNSTON
ST.
+0.448%
WK 0.8
+0.443%
WK 1.0'
+0.078 4%
WK 1.0'
+15 Low Point
0+20 P.C. R=150
Walk Grade 1.0 at Sta 2+00 To 0% at Sta 4+00
Stationing is on Center Line Distance's
PARKWOOD LANE
NL FUNSTON TO SL. HARRY ST.
30' CONC & CB.
City of Wichita, Kansas
BUILDER'S INC. March 29, 1950
Sheet 1/2

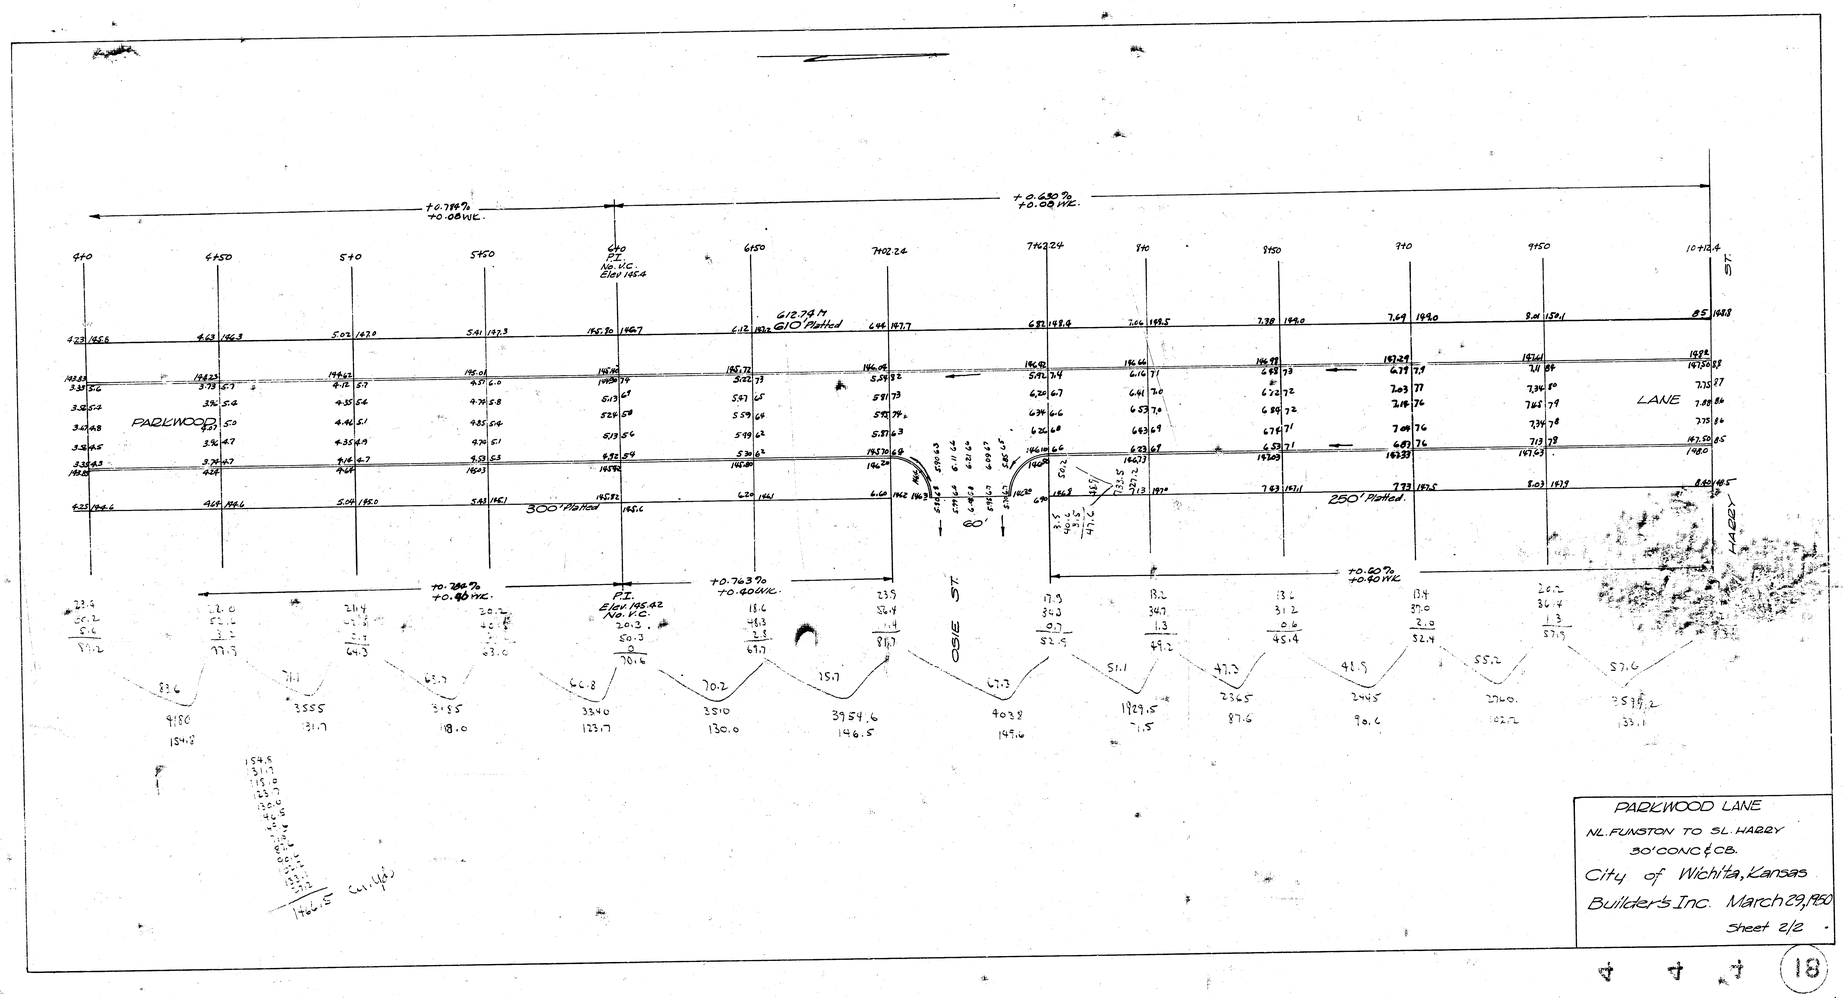



PARKWOOD LANE
NL. FUNSTON TO SL. HARRY
30' CONC & CB.
City of Wichita, Kansas
Builders Inc. March 29, 1950
Sheet 2/2

18

SCALE 1"=20'

Chaining N. on E. R.
BM 130.61 "B" in Builders F. Wk. N.E. Corner Mt. Vernon & Old Manor
BM 131.31 "M" in Mueller Fire Hyd. N.W. Corner Parkwood & Mt. Vernon

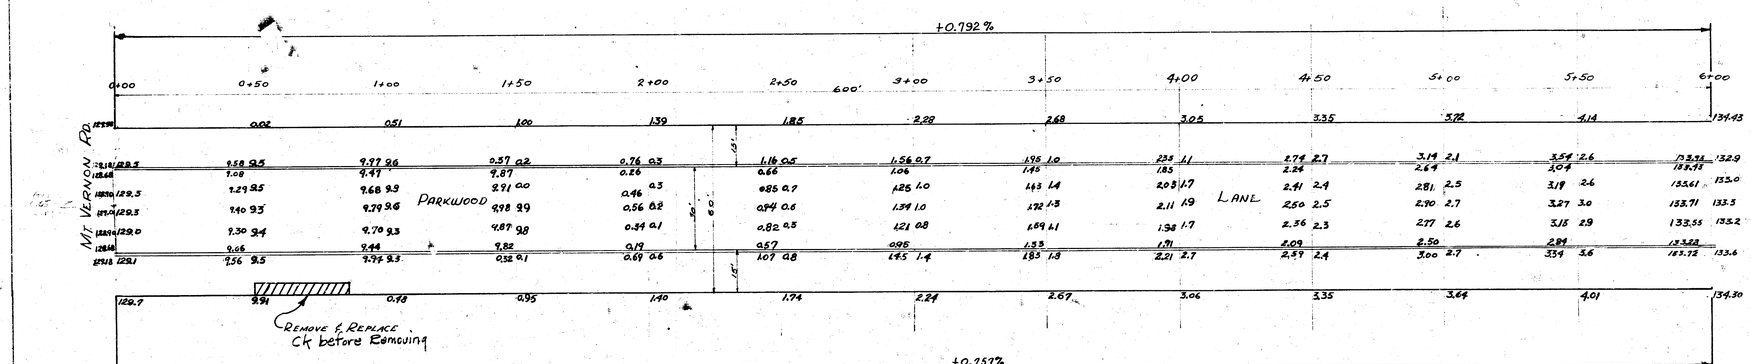

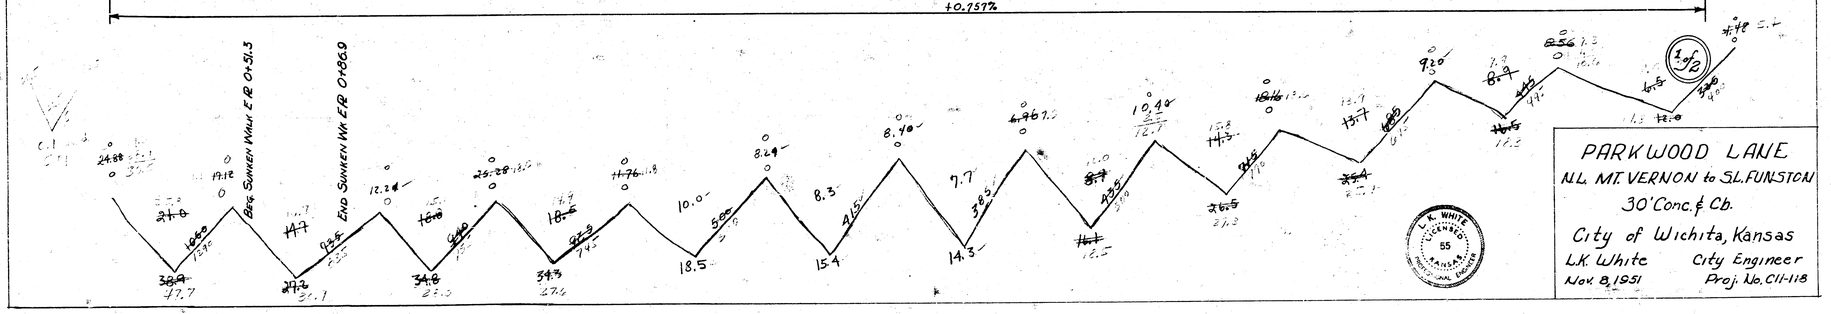

PARKWOOD LANE
N.L. MT. VERNON to S.L. FUNSTON
30' Conc. & Cb.
City of Wichita, Kansas
L.K. White City Engineer
Nov. 8, 1951 Proj. No. C11-118

SCALE 1"=20'

+0.792%

6+00 6+50 7+00 7+50 8+00 8+50 9+00 9+50 10+00 10+50 11+00 11+50 12+00 12+46.84

446.84'

PARKWOOD LANE

646.97'

+0.757%

PARKWOOD LANE

L. K. WHITE LICENSED 55 KANSAS PROFESSIONAL ENGINEER

2 of 2