


Parkwood Lane - N.L. DOUGLASS to S.L. FIRST

N.H. Elev. 115.20 @ in. plate on W. of Parkwood @ S.L. 1st

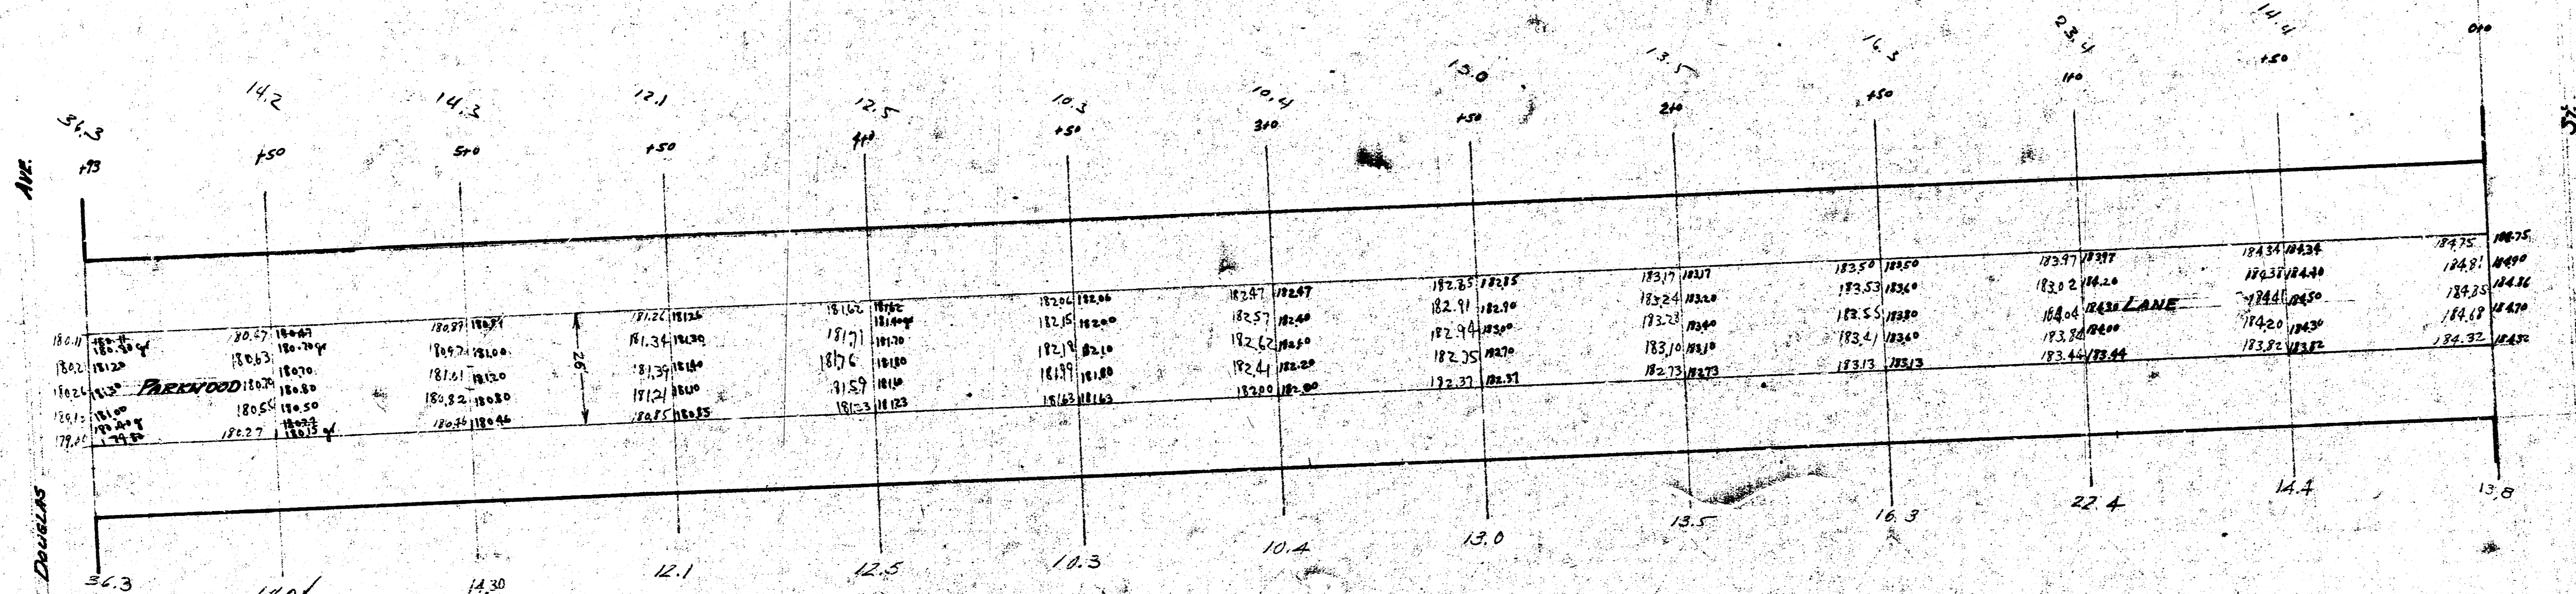

25.2  
 40.1 cyp  
 14.2  
 26.7 cyp  
 13.2  
 25.4 cyp  
 12.3  
 22.8 cyp  
 11.7  
 21.1 cyp  
 10.4  
 19.3 cyp  
 11.7  
 21.7 cyp  
 13.3  
 24.6 cyp  
 14.9  
 27.5 cyp  
 17.4  
 25.9 cyp  
 10.8  
 34.1 cyp  
 14.1  
 26.1 cyp

$$\frac{324.0}{374} = 3.584$$

