


Parkwood Lane 1942
~~BLECKLEY CT~~ - NL. ELM TO S.L. PINE
 CB + GTR ONLY
 24 ADJUST

*2 made 200.00
 16.00 277 and 281.00*

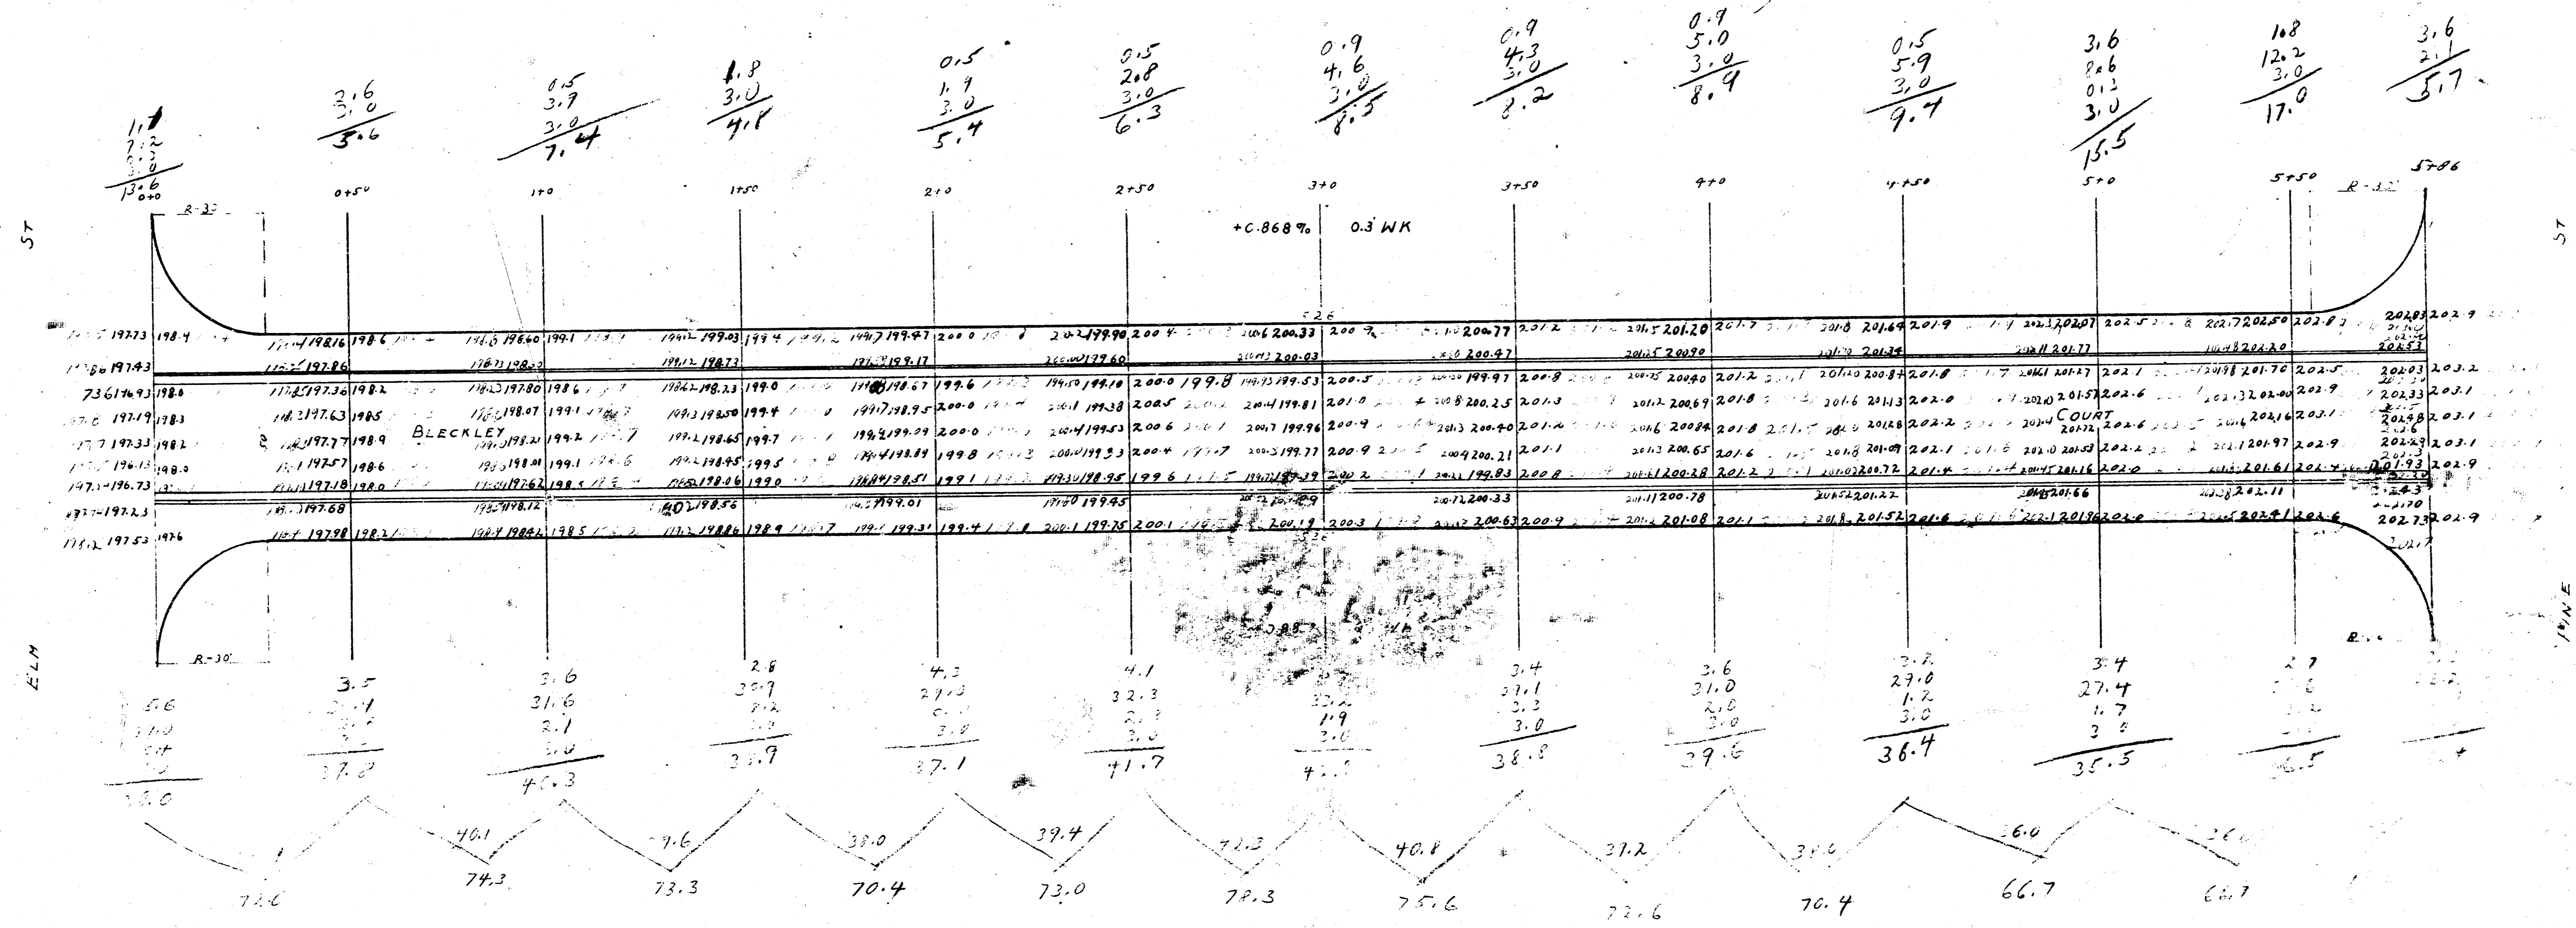


B.M. 200 23 NAIL IN PH. POLE S.S. ELM 150' EOP REAR

1-57

B.M. 19788 6" in Globe W.G. N.W. Ret. Parkwood & Elm

N

21.1
21.2
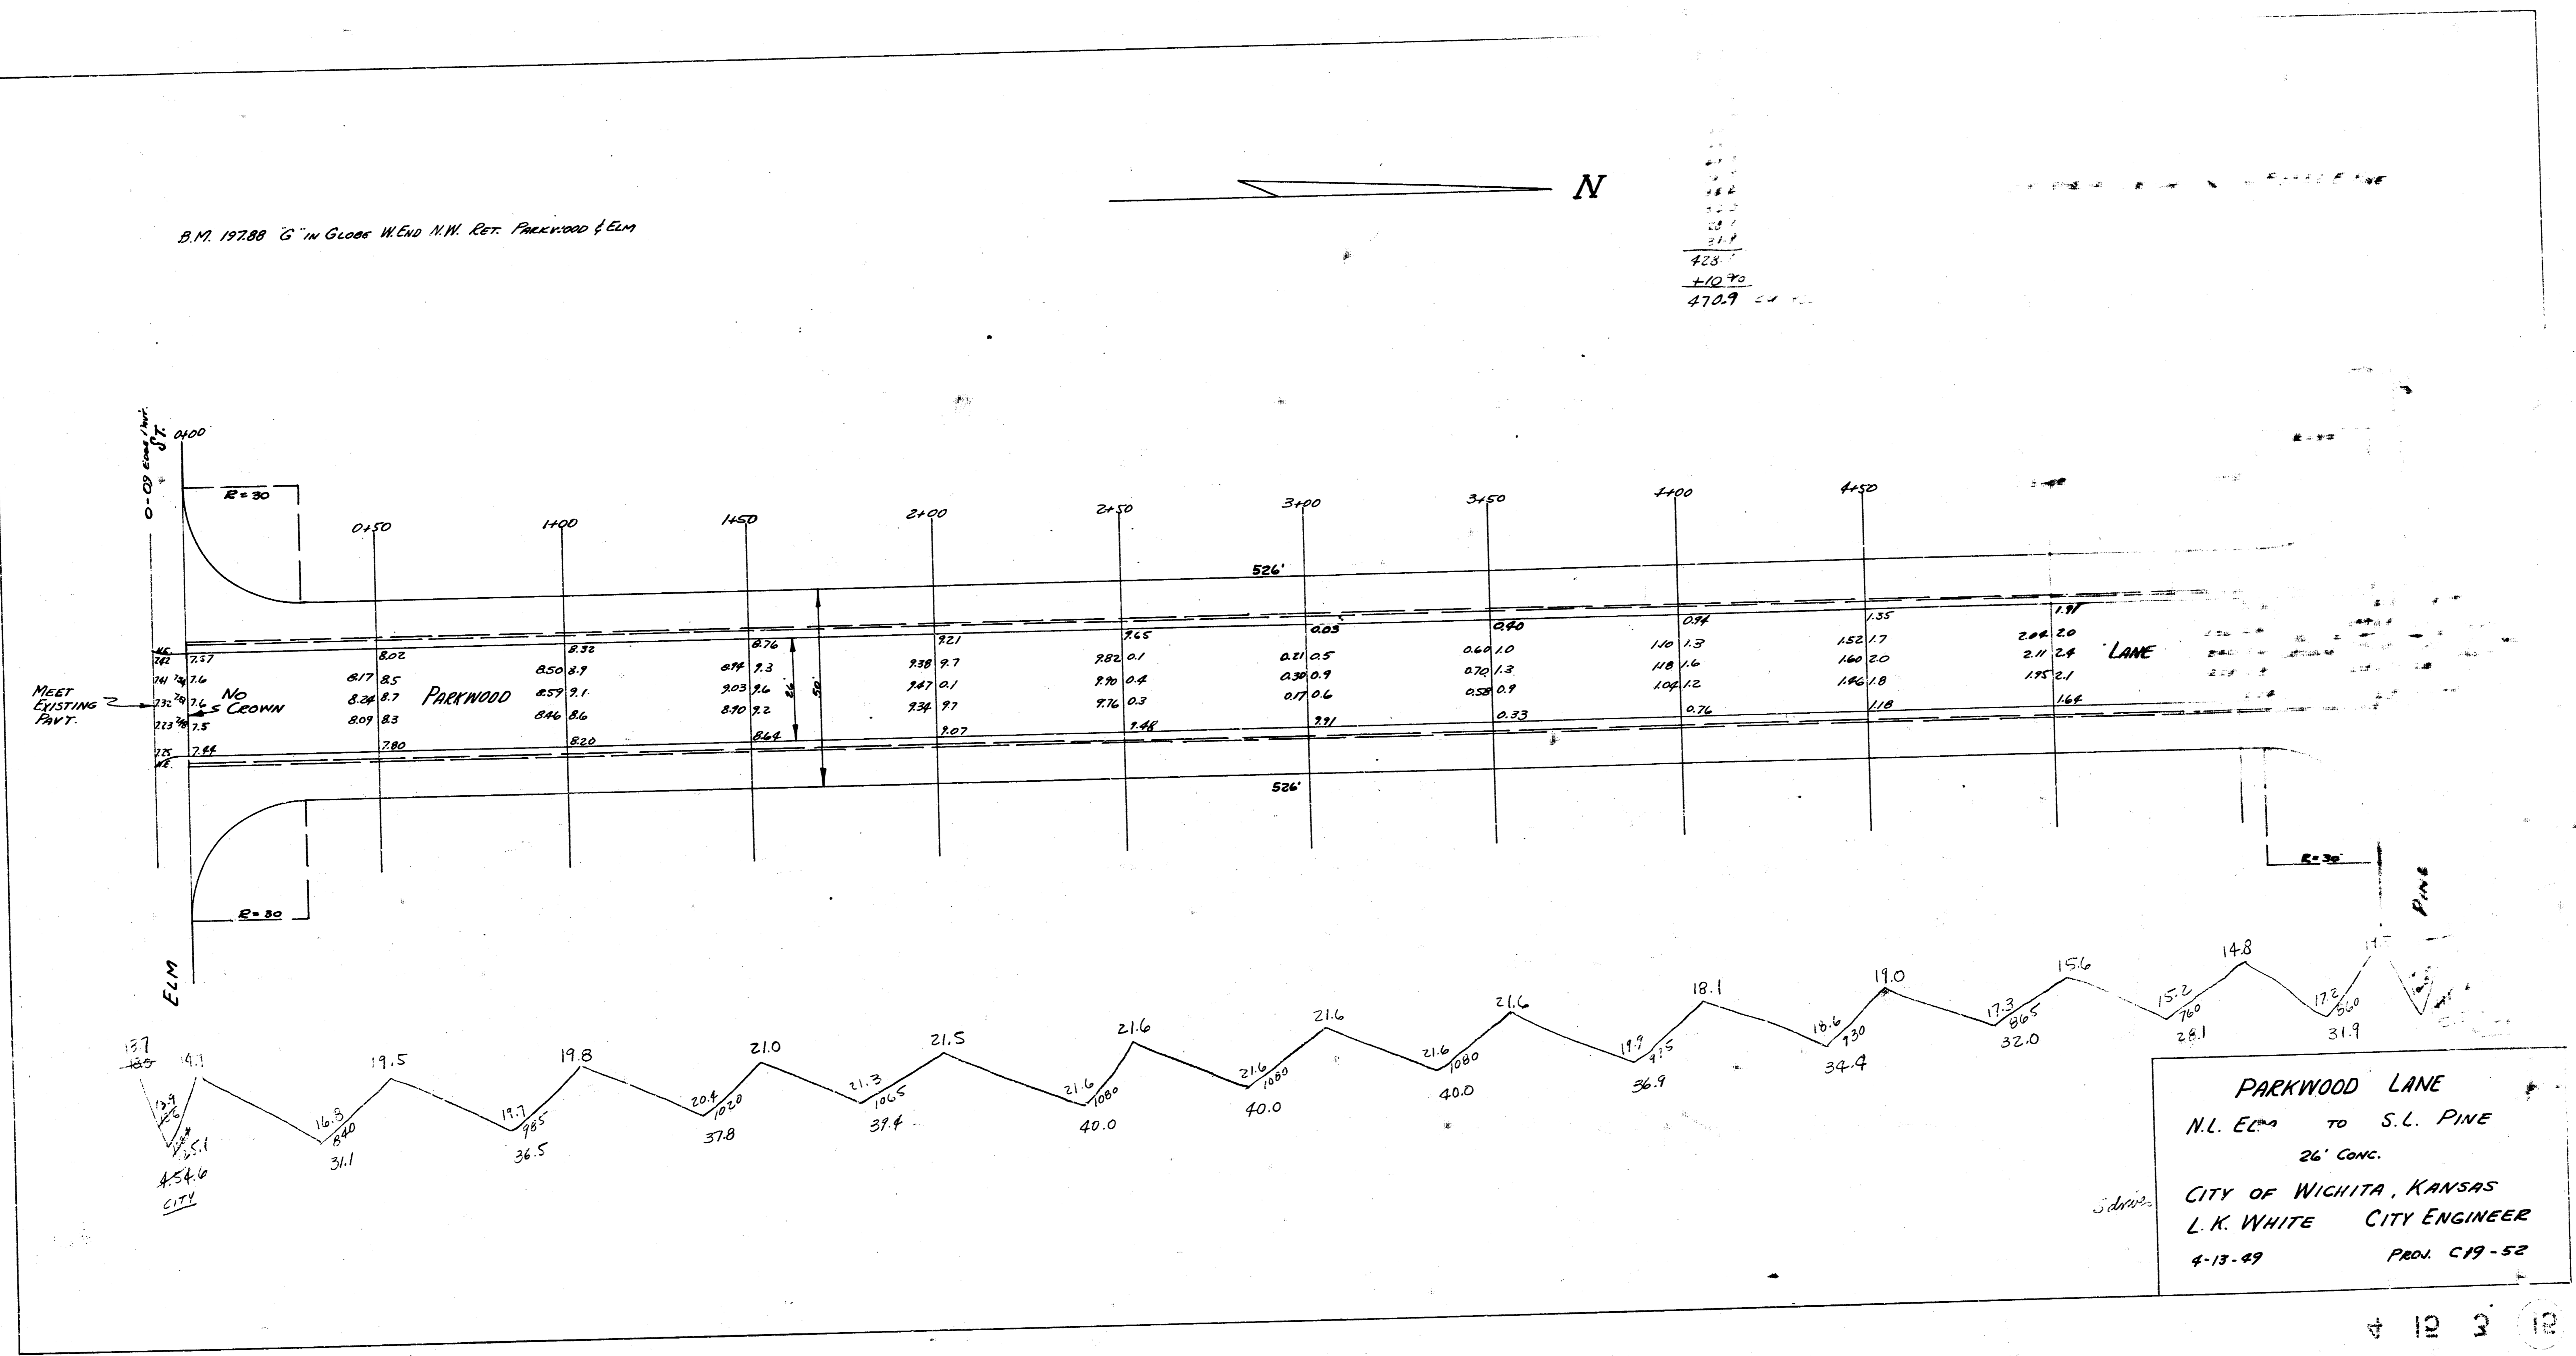

PARKWOOD LANE
 N.L. Elm TO S.L. PINE
 26' CONC.
 CITY OF WICHITA, KANSAS
 L.K. WHITE CITY ENGINEER
 4-13-49 PROJ. C19-52