


Survey City Bk 54
Plan 10
Exc 10
Checked 37

B.M. TOP OF COLLAR ON SILL COCK, PK. 1 OF NO. 1308 E. ALTURA ELEV. 92.68
B.M. "P" IN P.K.S. W.C.B. PATTIE & N.L. DEL MAR ELEV. 90.60

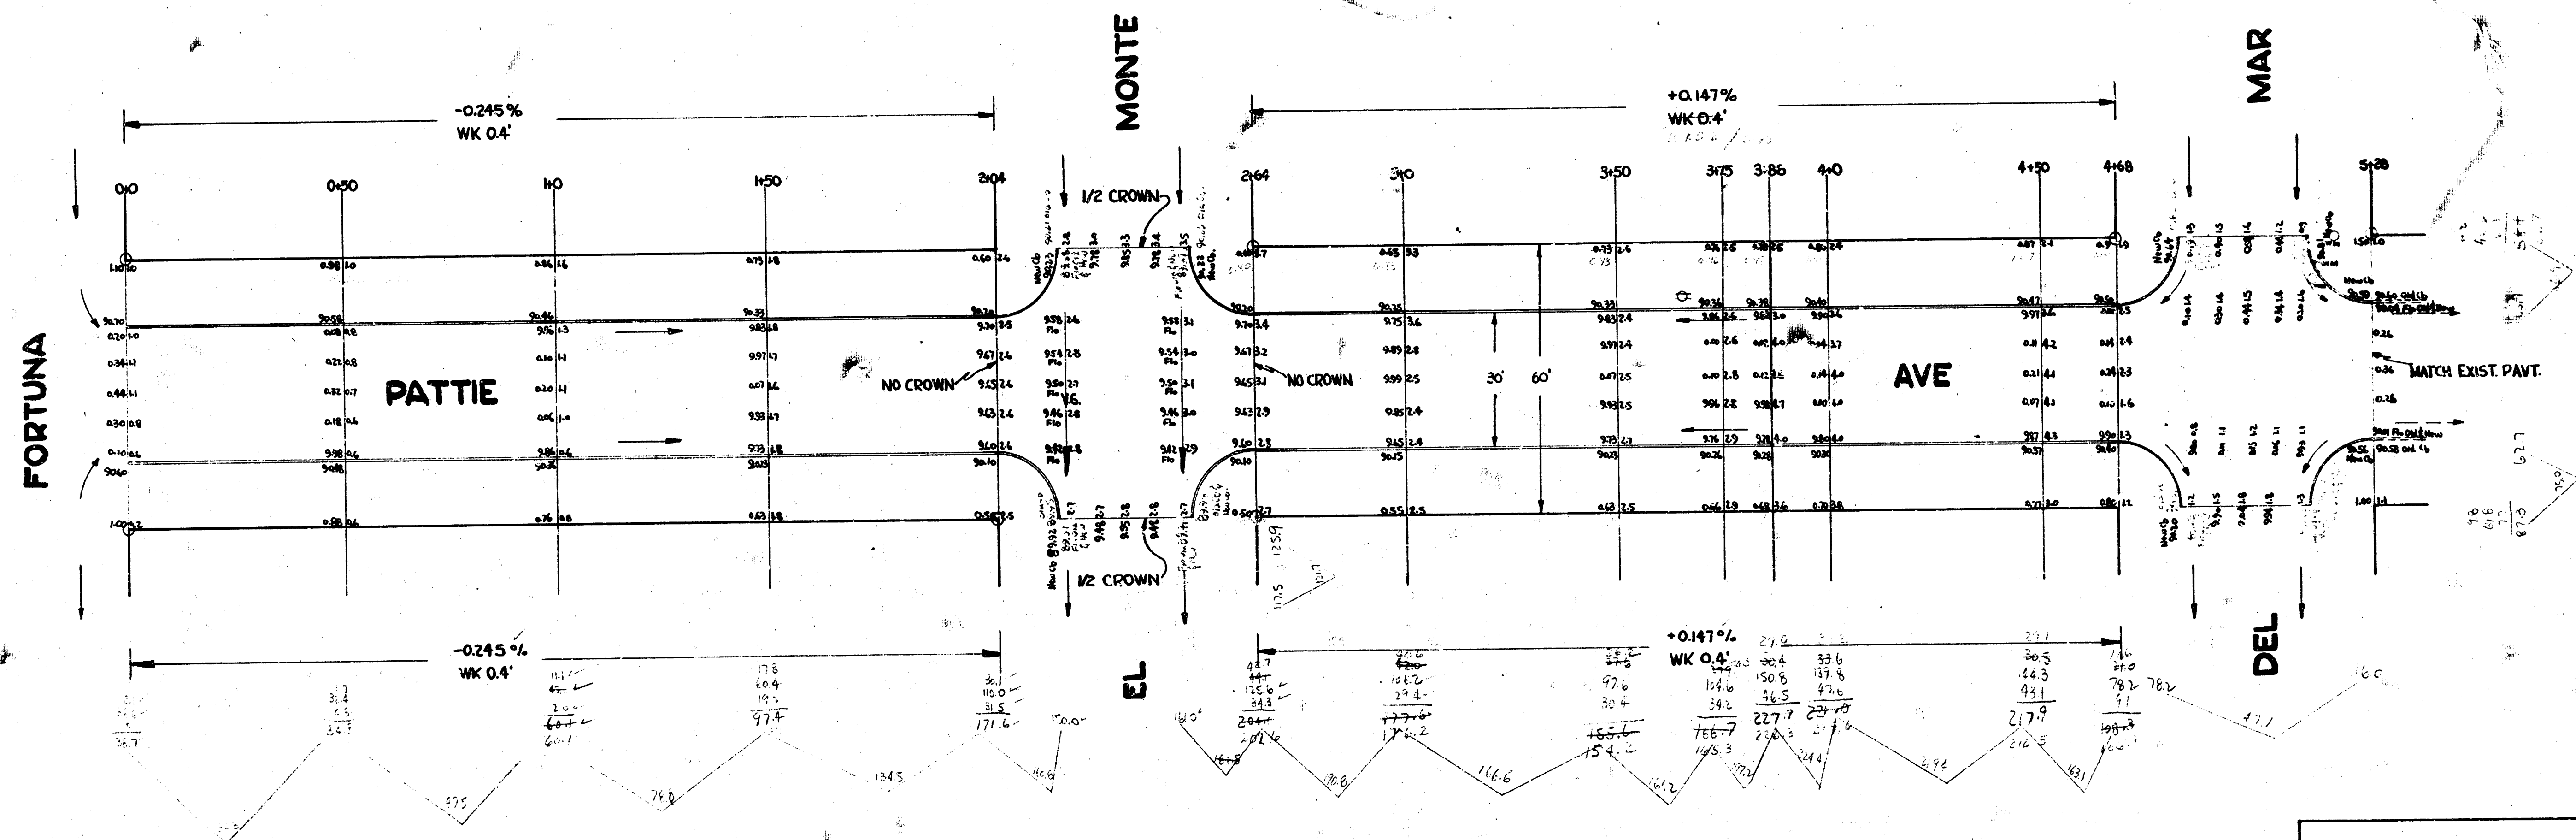

City
1974.9
+10.76
2194.9 36.3

PATTIE AVE
N.L. FORTUNA TO N.L. DEL MAR
30' CONC. & CURB
CITY OF WICHITA, KANSAS
B.E. SMITH CITY ENGINEER
AUG 1955 PROJ. NO. CH-154

