

B.M. 1707.0 "M" in Meuller Top F.H. on S.E. Cor. Peach Tree Lane & Rock Road
B.M. 1711.29 "M" in Meuller Top F.H. on S.E. Cor. Rock Road & Willow Brook
Base Line & Stationing along ℄ of Peach Tree Lane

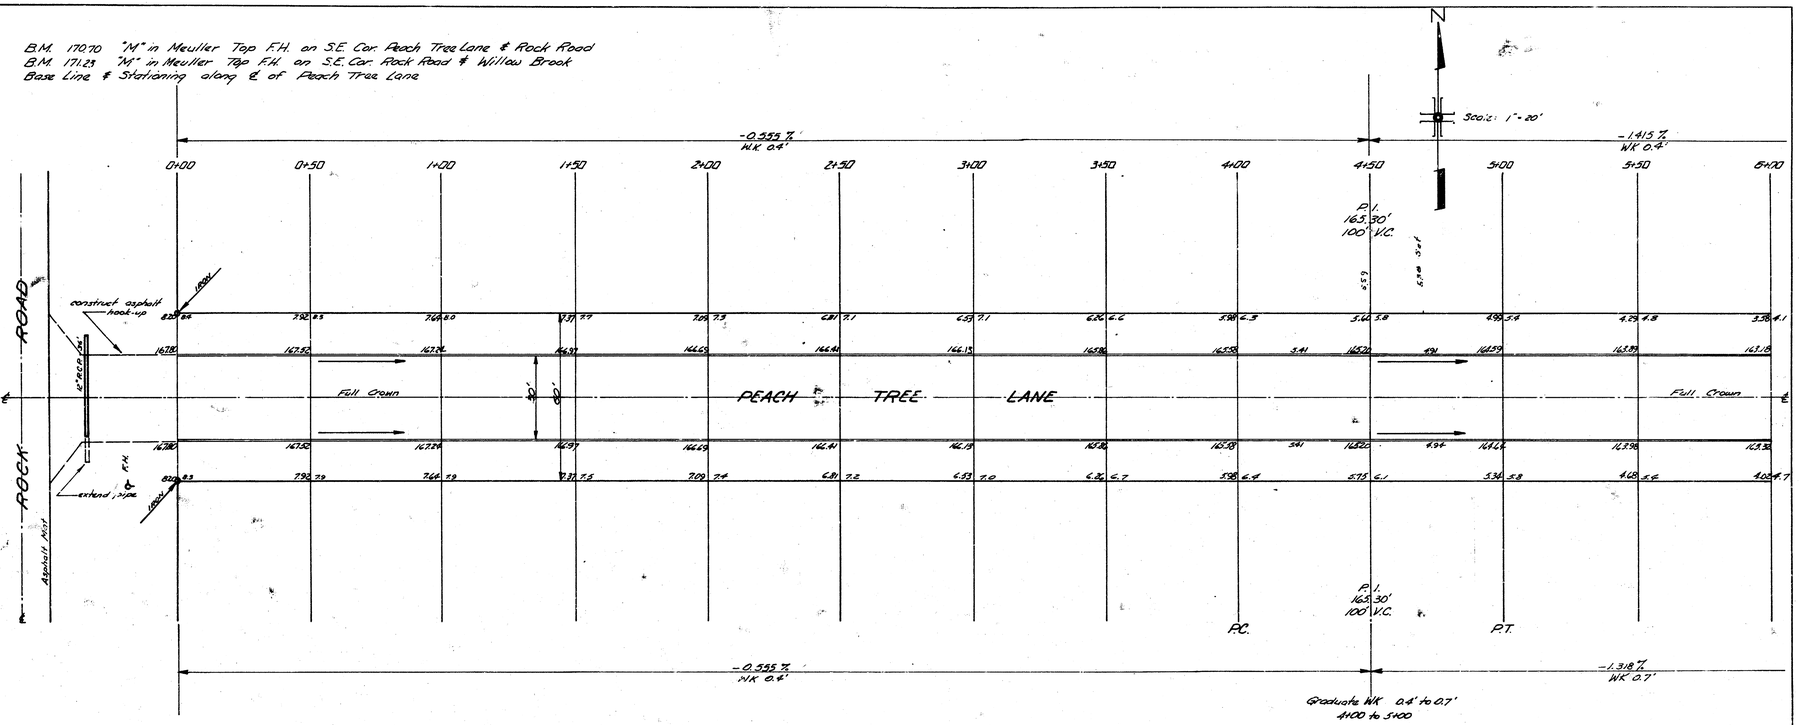

Grade: 1.65%
Cross Slope: 6.25%
Jones
City Nat. Eng.

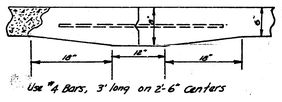

Use #4 Bars, 3' long on 2'-6" centers
DETAIL OF MASTIC JOINT

JAMES H. TANDY
No. 20:2
KANSAS
REGISTERED PROFESSIONAL ENGINEER

Excavation

Property		City	
	1338.6		324.0
+10%	133.9	+10%	32.4
	1472.5 cu.yd.		356.4 cu.yd.

Compacted Fill

Property	
	38.4
+10%	3.9
	42.3 cu.yd.

B. E. SMITH
LICENSED
436
KANSAS
PROFESSIONAL ENGINEER

1/10

PEACH TREE LANE


E.L. ROCK ROAD TO E.L. BONNIE BRAE ADD.

30' CONCRETE & C.B.

CITY OF WICHITA, KANSAS

B. E. SMITH CITY ENGINEER

DATE: July 6, '23 PROJ. NO. C13-294

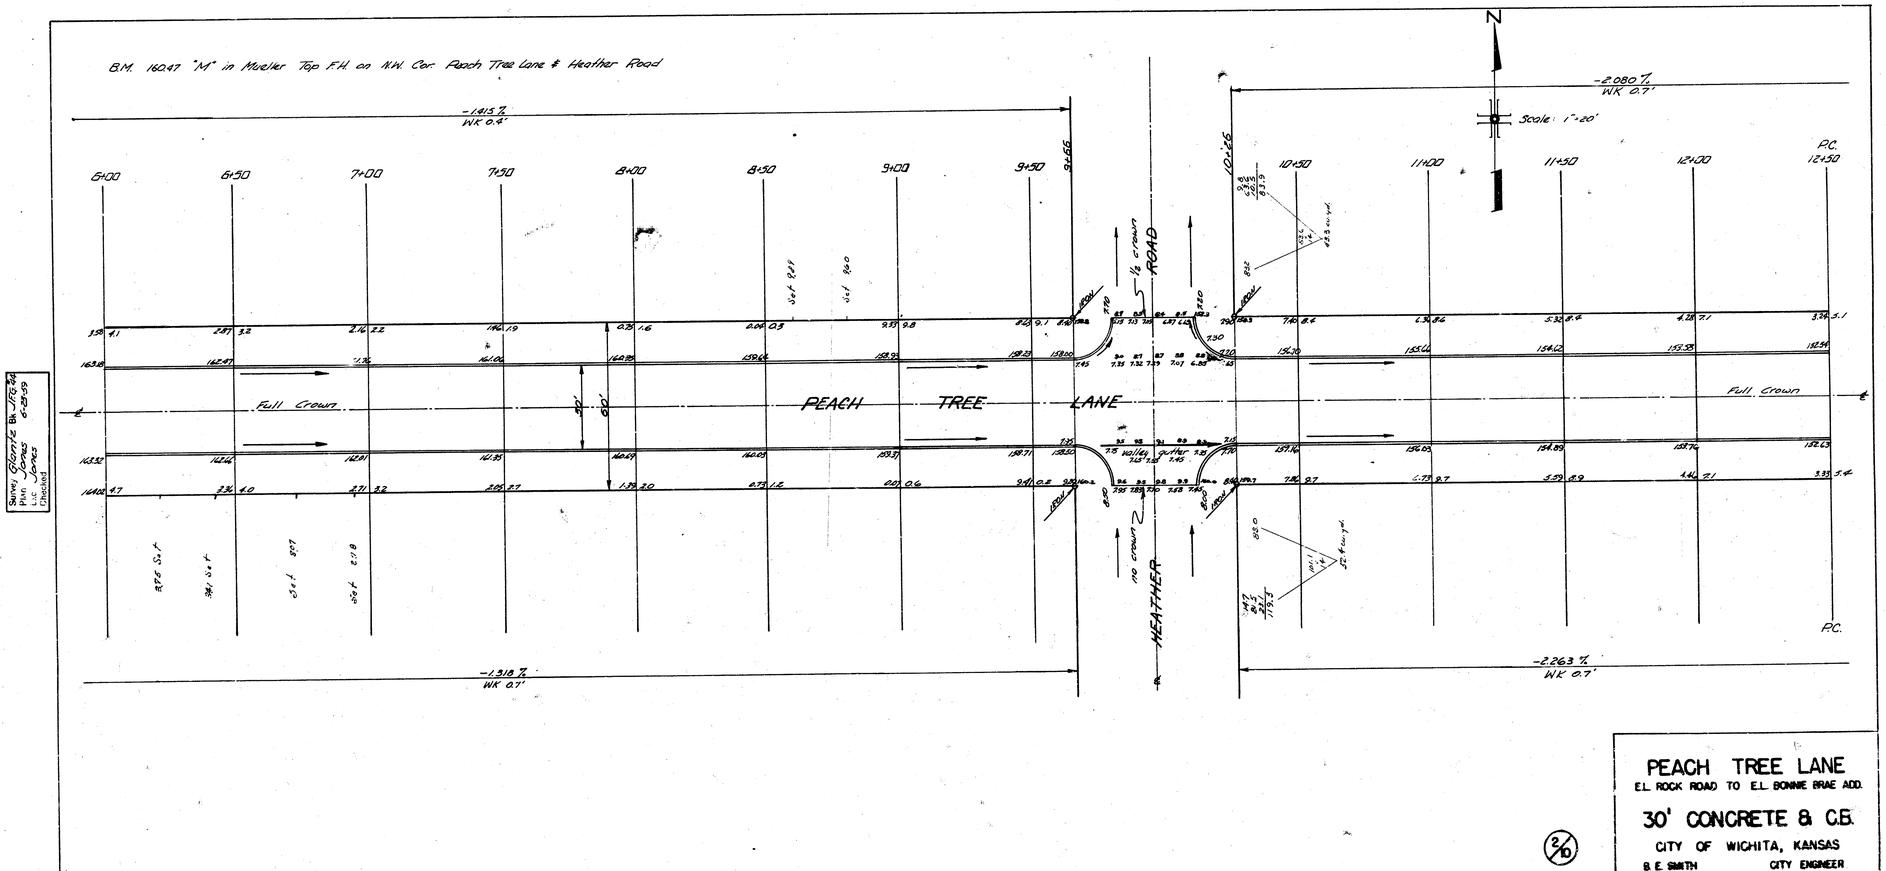

Survey Plotted Checked
Drawn
L.I.E.
Jones
4-8-59

PEACH TREE LANE

E.L. ROCK ROAD TO E.L. BONNIE BRAE ADD.

30' CONCRETE & C.B.

CITY OF WICHITA, KANSAS

B. E. SMITH CITY ENGINEER

DATE: May 6, 59 PROJ. NO. 013-284

2/10

Grades WK 0.7' to 0.4'
12+50 to 13+50

-2.080 %

P. I.
131.50'
100' V.C.

-0.843 %
WK 0.4'

N

Scale: 1"=20'

P.C.		P.T.												
12+50	13+00	13+50	14+00	14+50	15+00	15+50	16+00	16+50	17+00	17+50	18+00	18+50	19+00	
3.26	5.1	2.80	3.9	1.48	2.0	1.04	0.5	0.64	9.2	0.22	8.6	9.80	8.8	9.3
1.98	151.65	1.84	151.08	150.66		150.36		149.96		149.74		149.37		148.55
4.11	151.68	1.34	151.01	150.64		150.32		149.79		149.54		149.30		148.65
2.54	2.37	4.0	149.21	1.08	0.6	0.62	9.2	0.19	8.3	9.76	8.6	9.35	8.6	8.90

9.7	8.55	0.6	8.55	1.8	8.11	2.4	7.69	0.9	7.71	9.5	6.78	8.4		
148.53		148.18		147.71		147.29		146.97		146.44				
148.54		148.20		147.65		147.32		146.79		146.32				
9.3	8.90	9.2	8.55	1.6	7.66	0.4	7.19	9.1	6.76	8.1				

Full Crown

PEACH TREE LANE

30'

60'

Full Crown

P. I.
131.50'
100' V.C.

P.C.

P.T.

-2.263 %

-0.856 %
W.K. 0.4'

Graduate WK 0.7' to 0.4'
12+50 to 13+50

Grade Un. 1/15/68
Const. 6-13-69
Joint

3/10

PEACH TREE LANE


E.L. ROCK ROAD TO E.L. BONNIE BRAE ADD.

30' CONCRETE & C.B.

CITY OF WICHITA, KANSAS

B.E. SMITH CITY ENGINEER

DATE: July 6, 69 PROJ. NO. C13-294

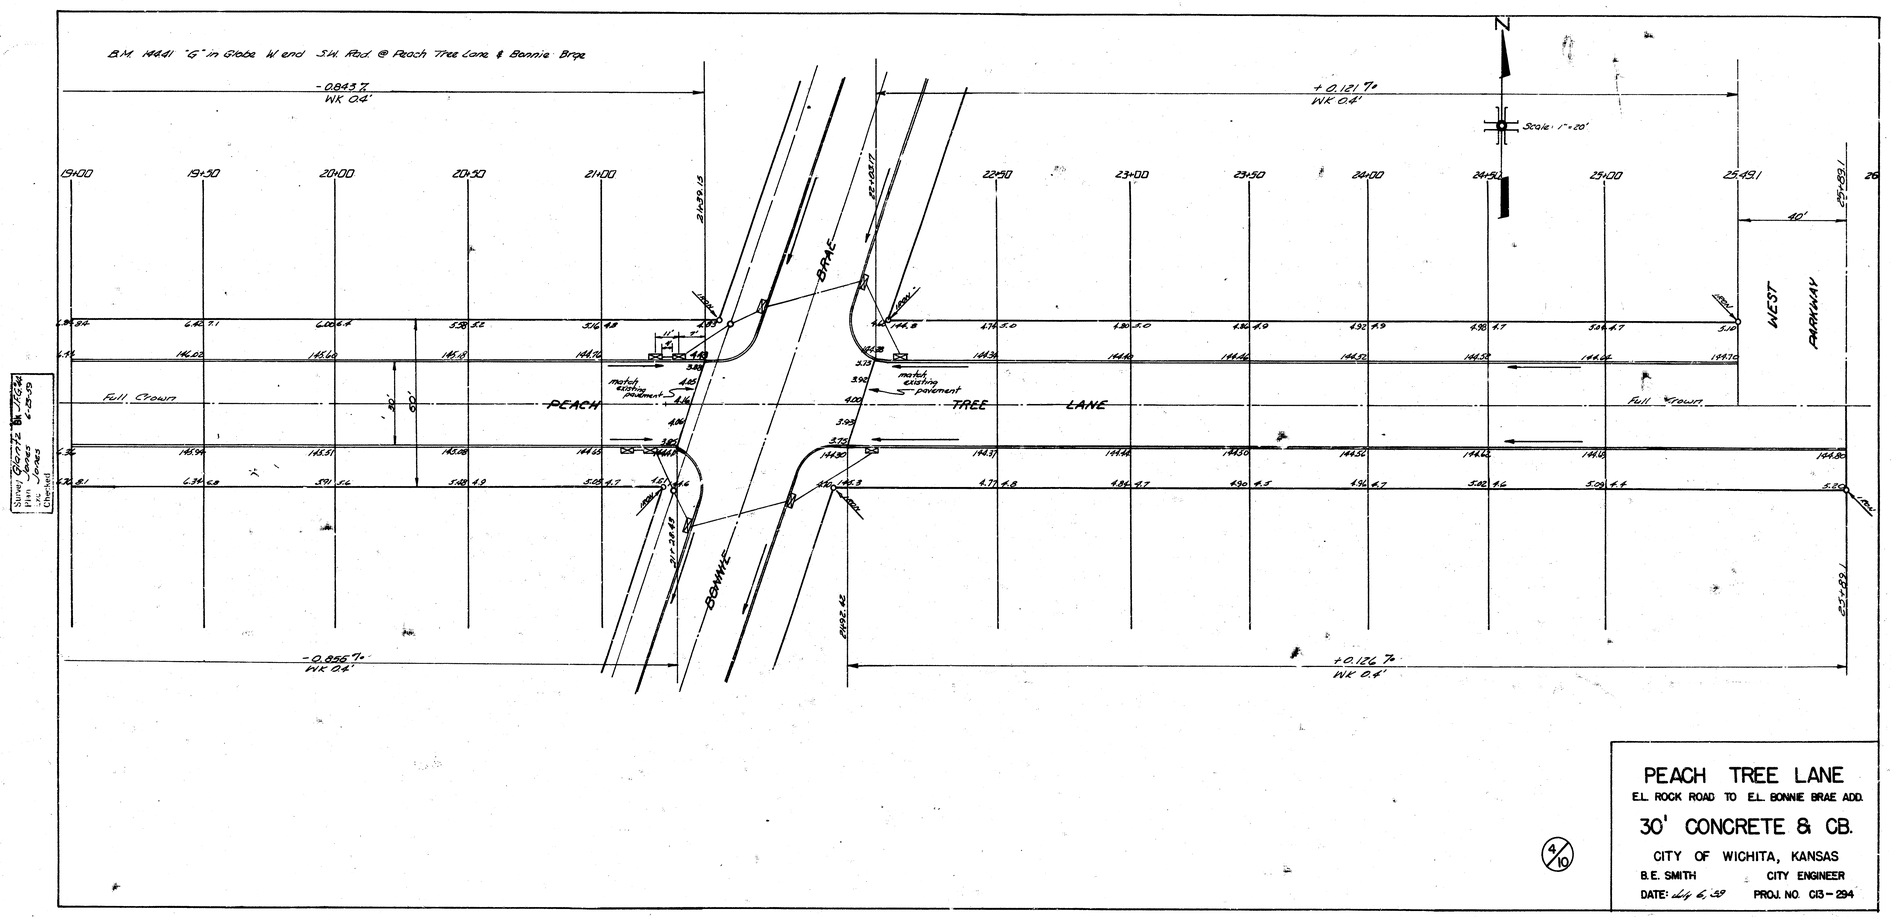

Survey Book 7624 Pg. 76
Plat Jones
Checked Jones
4-25-39

PEACH TREE LANE

E.L. ROCK ROAD TO E.L. BONNIE BRAE ADD.

30' CONCRETE & C.B.

CITY OF WICHITA, KANSAS

B.E. SMITH CITY ENGINEER

DATE: 4-4-39 PROJ. NO. 013-294

4/10