Book H-6

Ties:
Iron. C.L. Pennsylvania N.L. 11th.
60.58' N.E. to S.W. Cor. Porch Ho. # 1202.
21.02' W. to Nail (0.7' above Gnd.) in N. side Pine Tree.
47.15' N.W. to S.E. Cor. sidewalk below porch step Ho. # 1628

B.M. 116.05 S.W. Cor. Porch Ho # 1202

Ties:
Iron. W.P.L. Pennsylvania & ℄ 12th
47.93' SW to NE Cor of Porch, House No. 1257
91.84' SE to NW Cor. of Porch, House No. 1258
96.27' NE to SW Cor Conc. Found., House No. 1302

B.M. 116.60 S.W. Cor. Porch Ho # 1302 Penn.

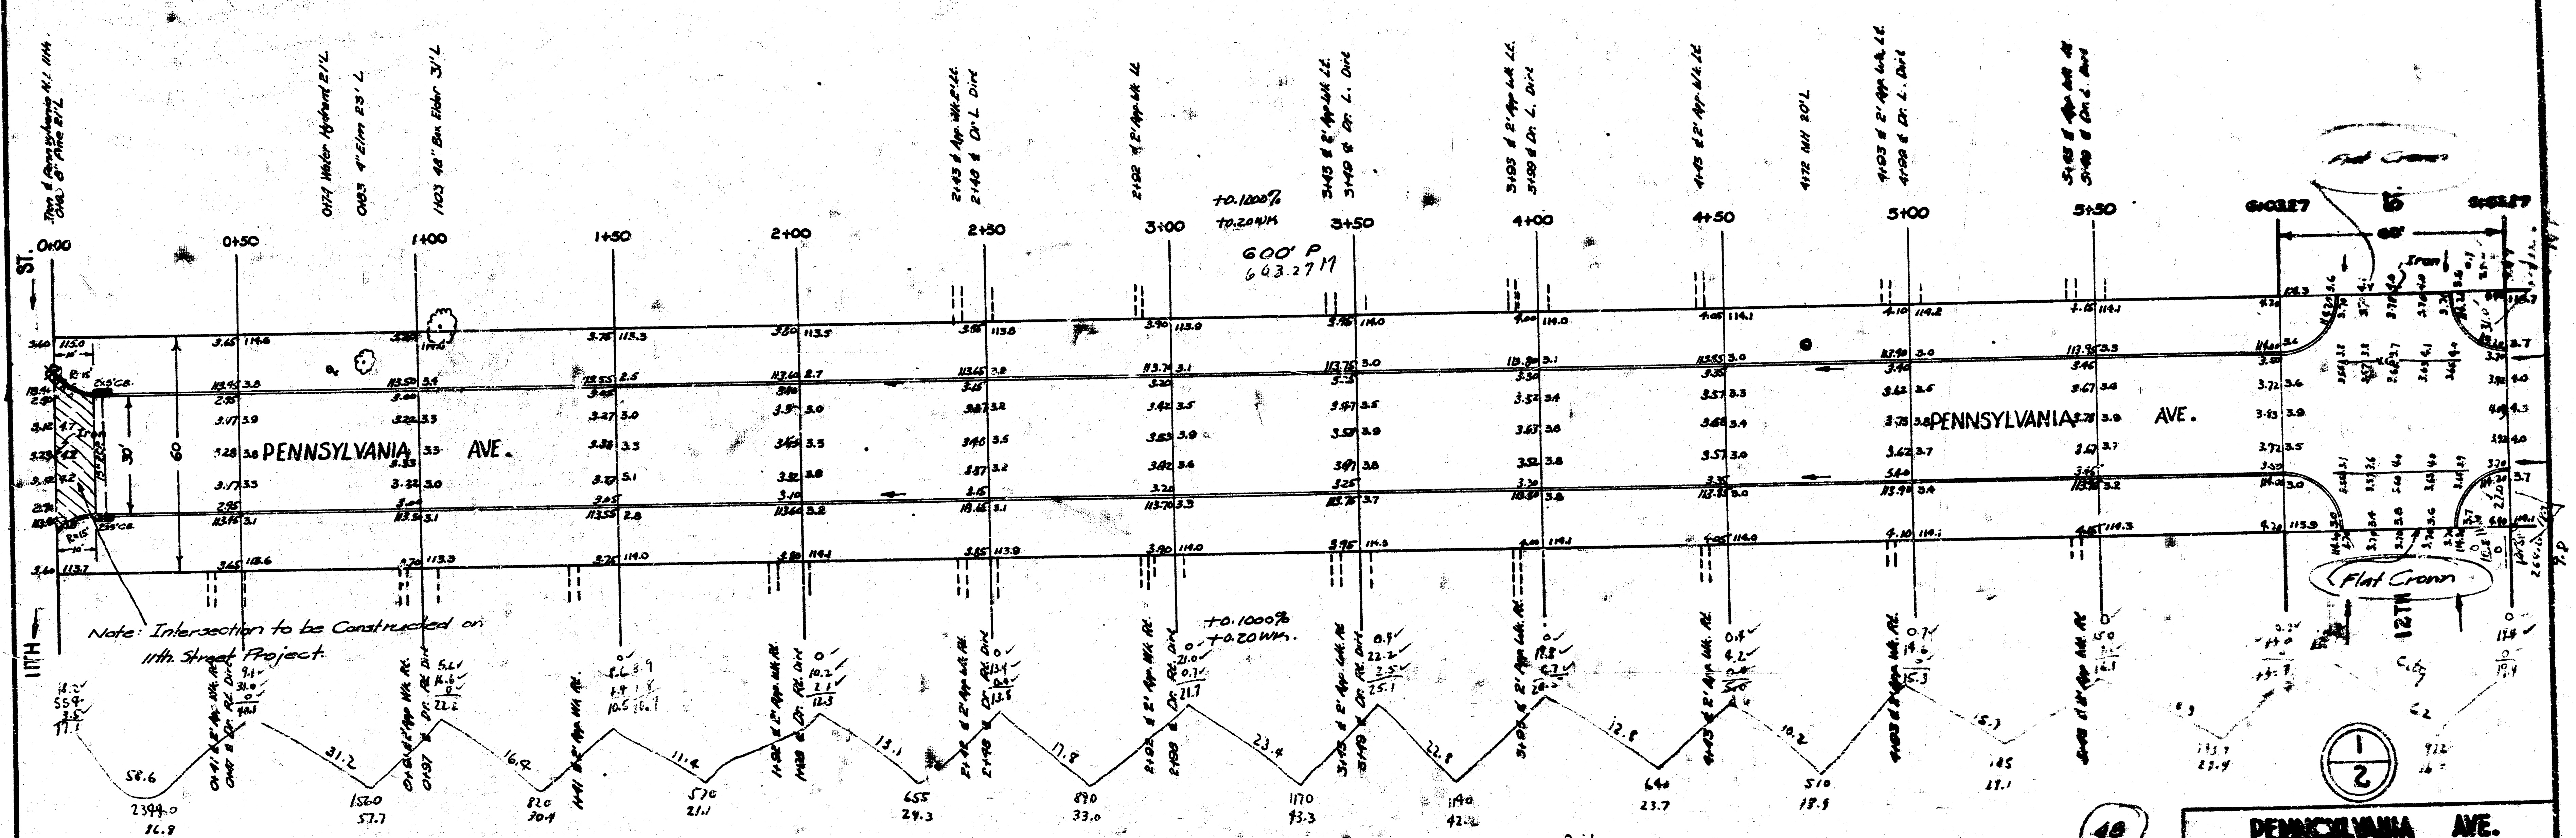
N
0+00
0+50
1+00
1+50
2+00
2+50
3+00
3+50
4+00
4+50
5+00
5+50
6+03.27
6+63.27
PENNSYLVANIA AVE.
PENNSYLVANIA AVE.
11TH ST.
12TH
Flat Crown
Flat Crown
Iron
+0.1000%
+0.1000%
600' P
Note: Intersection to be Constructed on 11th Street Project.

Ties:
Iron ℄ Pennsylvania & S.P.L. 11th
56.70' S. of Iron at ℄ Penn. & N.P.L. 11th
62.78' NW to Nail in NE side of 24" Elm about 6" above ground
92.75' NE to Center of Round Bulb on Gas Meter

B.M. 114.82 "G" in Globe N. Cb. 13th E.L. Penn. on Cb. Return.

Grand Total's

	Property	City
Sheet 1	439.9	24.3
Sheet 2	202.2	0
	642.1	24.3
+10%	64.2	2.4
Total Cu Yds Excavation	706.3	26.7

Fill
Property
245.4
24.5 +10%
269.9 Total Cu Yds Fill

Property
86.8
57.7
30.4
21.1
24.3
33.0
43.3
42.2
23.7
18.9
28.1
28.4
437.9 Cu Yds Excavation

City
9.8
Cu Yds Excavation

48

1/2

L. K. WHITE
LICENSED
55
KANSAS
PROFESSIONAL ENGINEER

PENNSYLVANIA AVE.
N.L. 11th to S.L. 13th
30' Conc. & Cb.
CITY OF WICHITA, KANSAS
L. K. WHITE CITY ENGINEER
DEC. 1950 - PROJ. NO. C10-172

Book 46

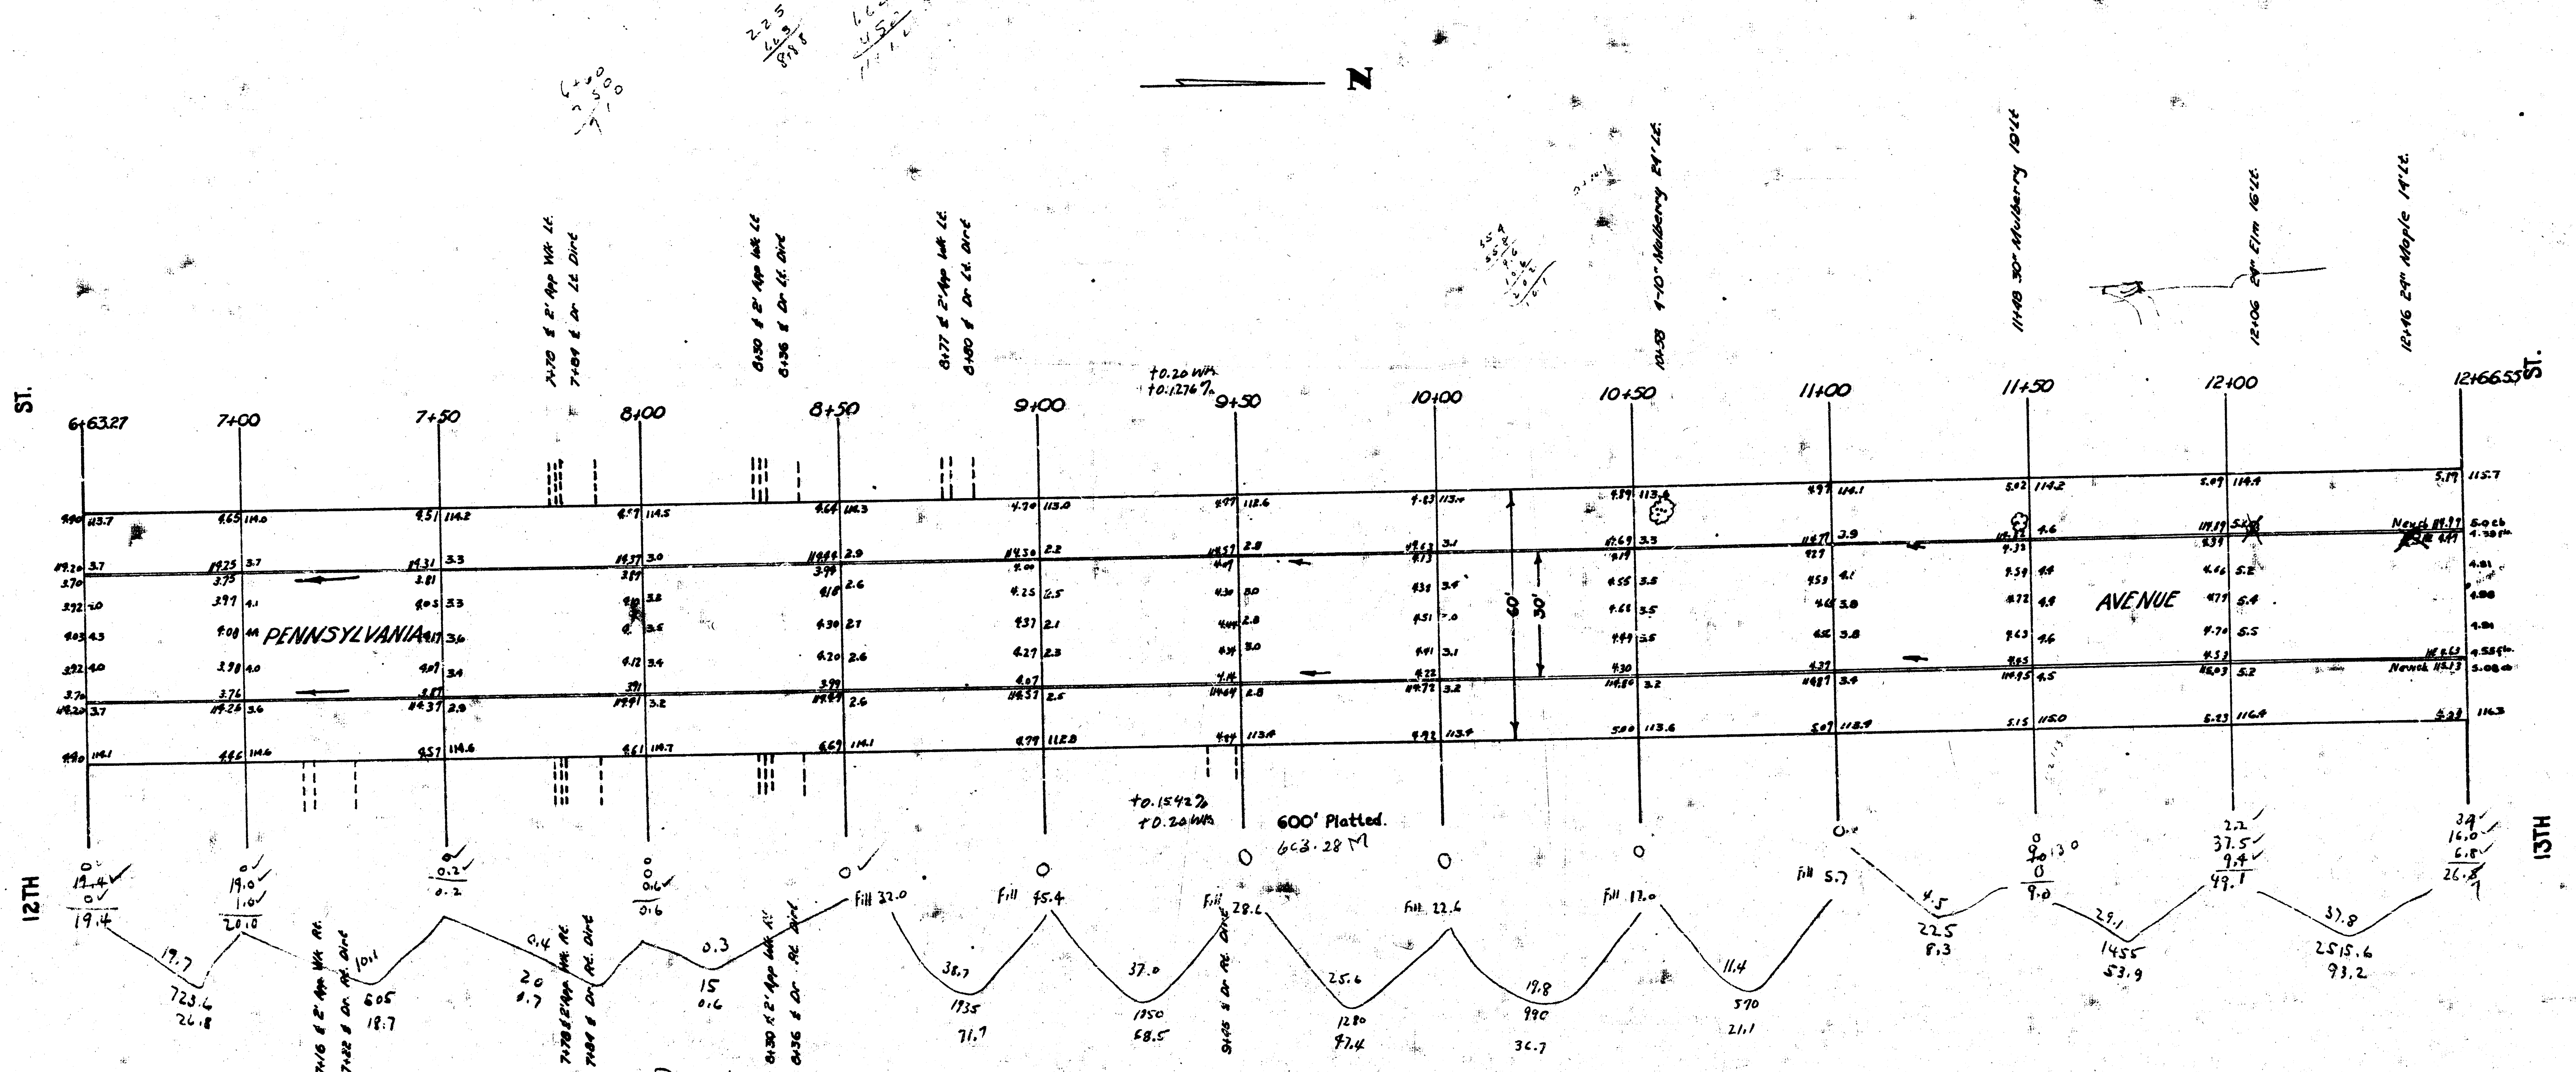
N
12TH ST.
13TH ST.
PENNSYLVANIA
AVENUE
6+63.27
7+00
7+50
8+00
8+50
9+00
9+50
10+00
10+50
11+00
11+50
12+00
12+66.55
7+70 & 2' App Wk Lt.
7+84 & Dr Lt. Dirt
8+30 & 2' App Wk Lt.
8+36 & Dr Lt. Dirt
8+77 & 2' App Wk Lt.
8+80 & Dr Lt. Dirt
10+58 4-10" Mulberry 24' Lt.
11+48 30" Mulberry 19' Lt.
12+06 24" Elm 16' Lt.
12+46 24" Maple 14' Lt.
+0.20 Wh.
+0.1276 %
+0.1542 %
+0.20 Wh.
60'
30'
600' Platted
603.28 M
Fill 32.0
Fill 45.4
Fill 28.6
Fill 22.6
Fill 17.0
Fill 5.7
7+16 & 2' App Wk Rt.
7+22 & Dr Rt. Dirt
7+78 & 2' App Wk Rt.
7+84 & Dr Rt. Dirt
8+30 & 2' App Wk Rt.
8+36 & Dr Rt. Dirt
723.6
26.8
605
18.7
1935
71.7
1850
68.5
1280
47.4
990
36.7
570
21.1
22.5
8.3
1455
53.9
2515.6
93.2

PROPERTY
26.8
18.7
0.7
0.6
8.3
53.9
93.2
202.2 Cu Yds. Excavation

Property
71.7
68.5
47.4
36.7
21.1
245.4 Cu Yds Fill

1145
110.52
3.7

L. K. WHITE
LICENSED
55
KANSAS
PROFESSIONAL ENGINEER

2
2

PENNSYLVANIA AVE.

B.M. 115.84 Std. S.E. Cor. 13TH & Hydraulic

REPLACE NECESSARY AMOUNT OF WING TO ASSURE FLOW IN VALLEY GUTTER

Per B. Smith
8' Excav. in Parking
Both Sides

Prop
62.4
89.8
86.5
90.2
106.3
119.3
116.3
129.4
152.0
155.0
134.3
124.8
1366.3
+10%
1502.9 Cu yds.

City
124.0
42.6
34.9
201.5
+10%
221.7 Cu yds

Totals

Prop	City
1502.9	221.7
1321.9	84.8
2824.8	306.5

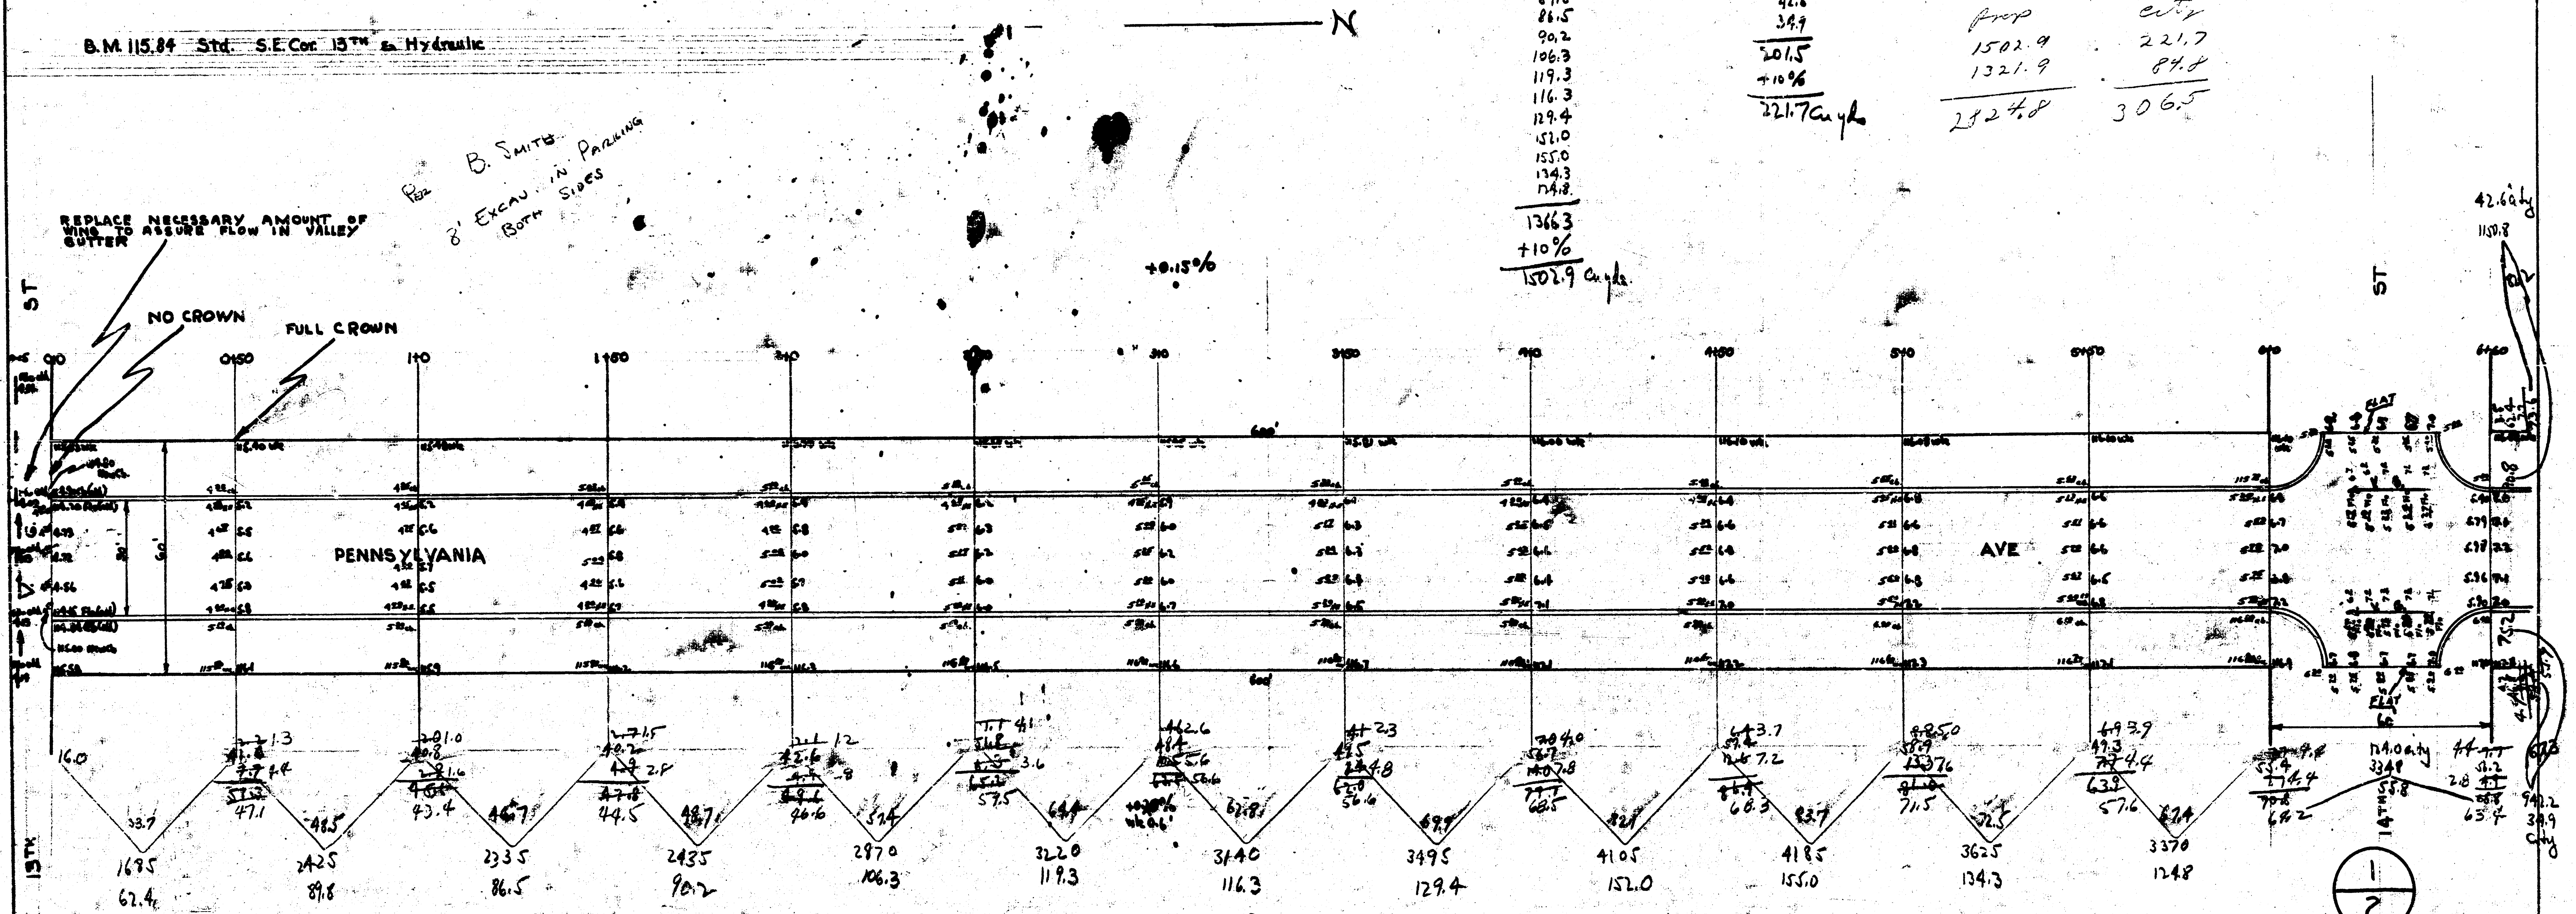
N
+0.15%
NO CROWN
FULL CROWN
13TH ST
14TH ST
PENNSYLVANIA
AVE
0+0
0+50
1+0
1+50
2+0
2+50
3+0
3+50
4+0
4+50
5+0
5+50
6+0
FLAT
42.6 City
34.9 City
16.0
168.5
62.4
242.5
89.8
233.5
86.5
243.5
90.2
287.0
106.3
322.0
119.3
314.0
116.3
349.5
129.4
410.5
152.0
418.5
155.0
362.5
134.3
337.0
124.8

1
2

PENNSYLVANIA AVE
N.L. 15TH TO S.L. 15TH
30' CONC. & C.B.
CITY of WICHITA, KANSAS
L.K. WHITE CITY ENGINEER
APRIL 1947

240 [illegible]

Prop
91.9
115.4
125.0
128.3
131.3
80.7
78.9
125.6
79.6
93.3
74.3
43.7
63.0
20.9

1201.7
+10%
1321.9 cu. yds

City
21.6
8.6
5.6
16.8
4.8
3.2
9.9
3.0
3.6

77.1
+10%
84.8 cu yds

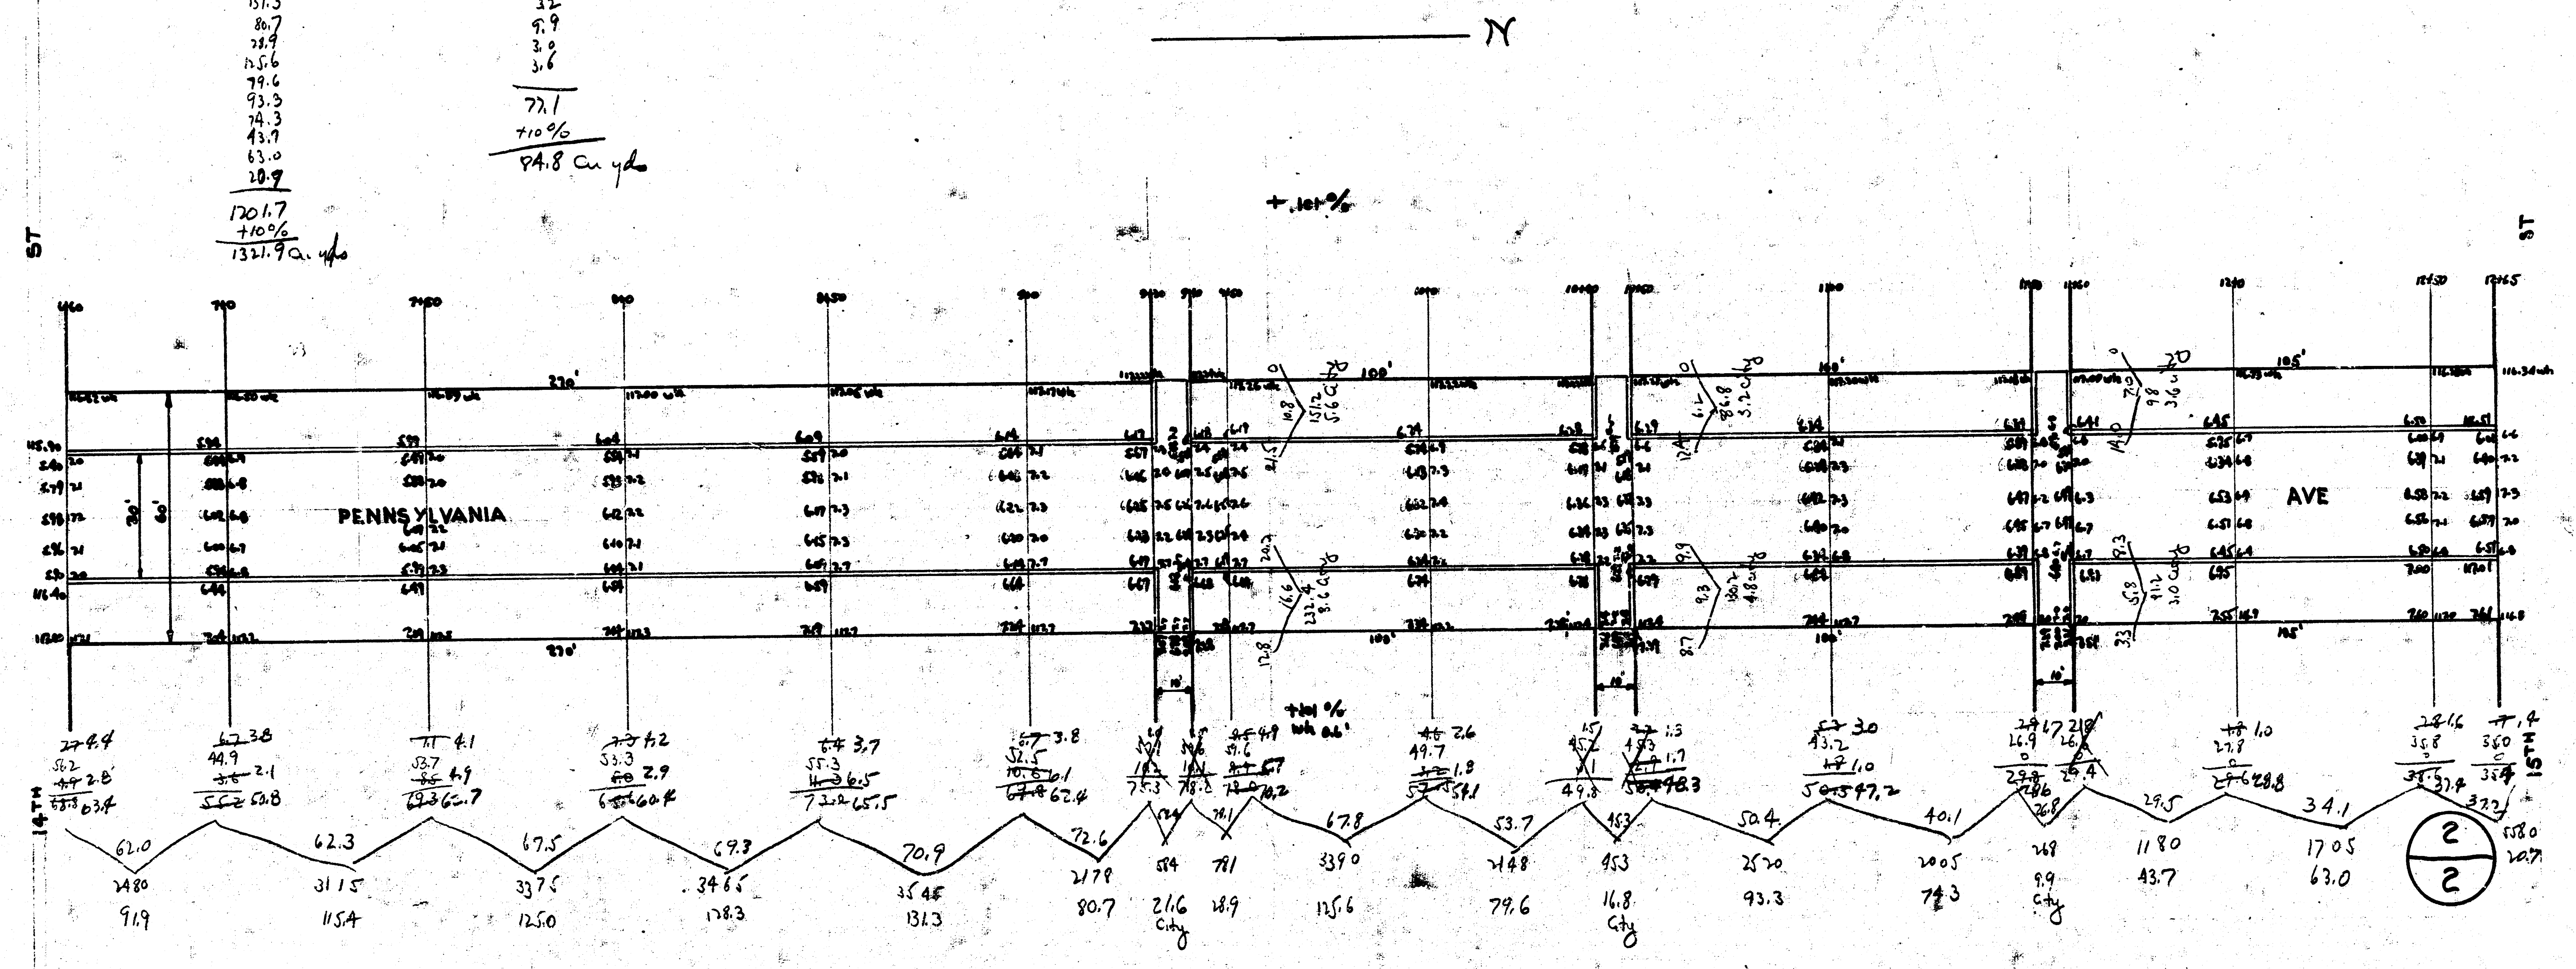
N
+.101%
ST
14TH
PENNSYLVANIA
AVE
ST
15TH
62.0
62.3
67.5
69.8
70.9
72.6
67.8
53.7
50.4
40.1
29.5
34.1
91.9
115.4
125.0
128.3
131.3
80.7
21.6
City
78.9
125.6
79.6
16.8
City
93.3
74.3
9.9
City
43.7
63.0
2
2

> 2 dms

S-5

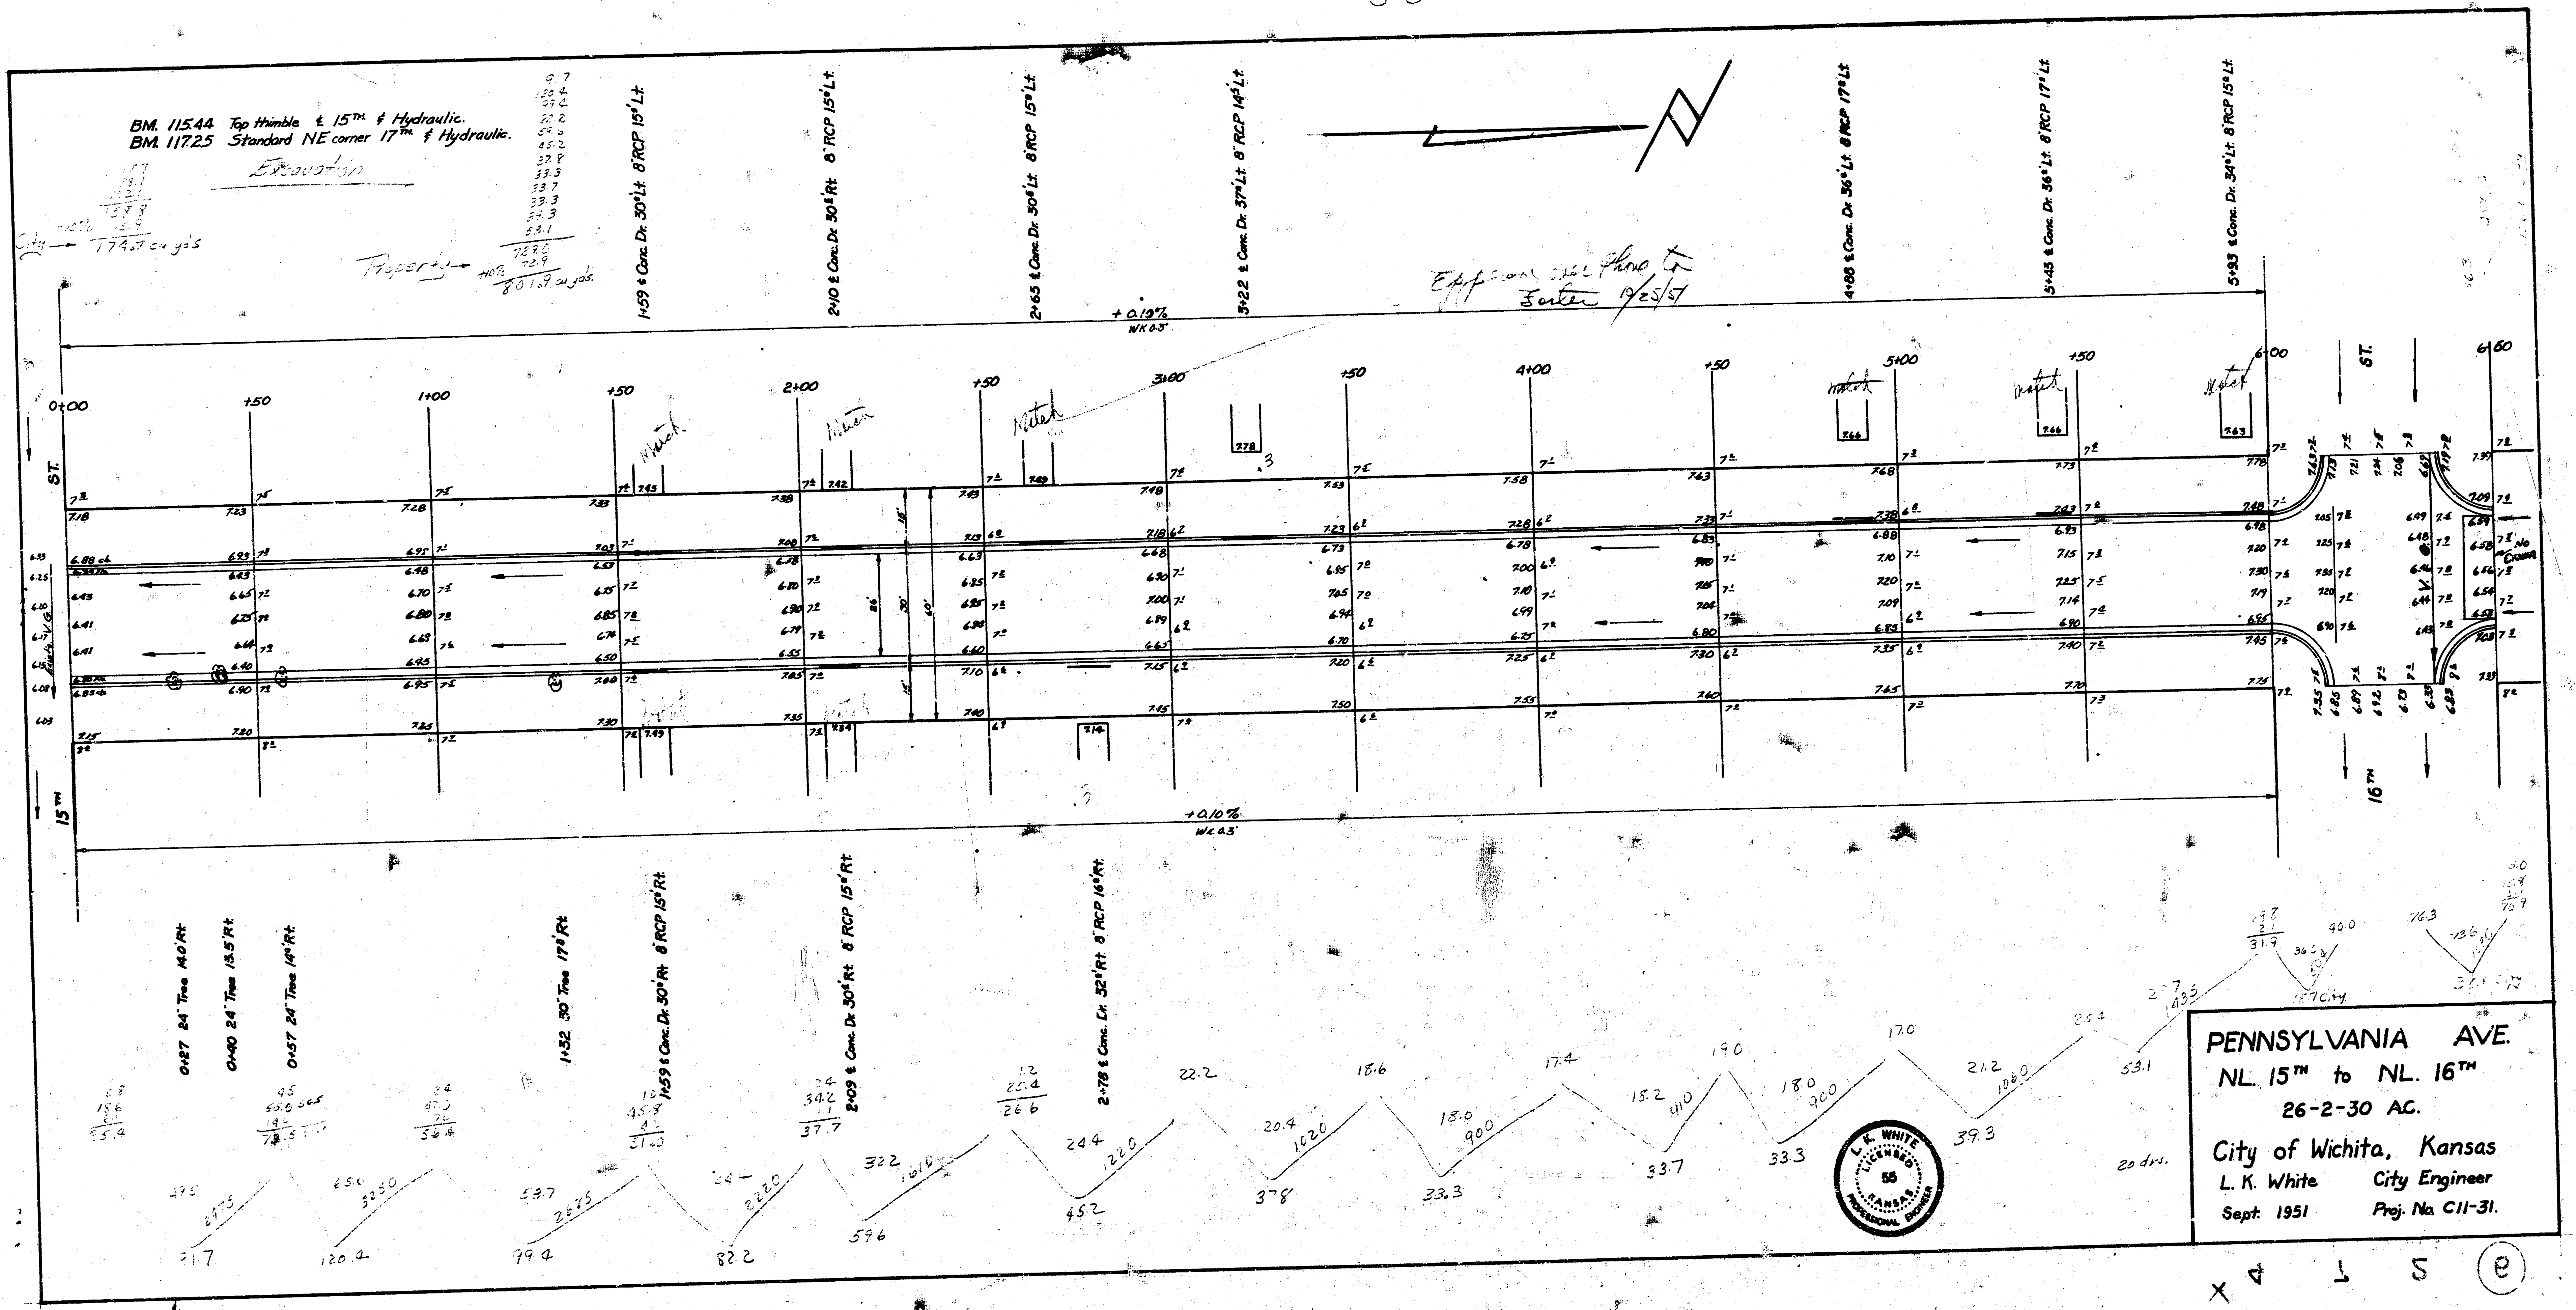
Excavation
City → +10% 774.7 cu yds
Property → +10% 729.0 72.9 801.9 cu yds
1+59 ℄ Conc. Dr. 30'Lt. 8"RCP 15'Lt.
2+10 ℄ Conc. Dr. 30'Rt. 8"RCP 15'Lt.
2+65 ℄ Conc. Dr. 30'Lt. 8"RCP 15'Lt.
3+22 ℄ Conc. Dr. 37'Lt. 8"RCP 14'Lt.
4+88 ℄ Conc. Dr. 36'Lt. 8"RCP 17'Lt.
5+43 ℄ Conc. Dr. 36'Lt. 8"RCP 17'Lt.
5+93 ℄ Conc. Dr. 34'Lt. 8"RCP 15'Lt.
Effective [illegible] Foster 1/25/57
+0.19%
WK 0.3'
0+00
+50
1+00
2+00
3+00
4+00
5+00
6+00
6+50
15TH ST.
16TH ST.
Watch
+0.10%
WK 0.3'
0+27 24" Tree 14.0'Rt.
0+40 24" Tree 13.5'Rt.
0+57 24" Tree 14'Rt.
1+32 30" Tree 17'Rt.
1+59 ℄ Conc. Dr. 30'Rt. 8"RCP 15'Rt.
2+09 ℄ Conc. Dr. 30'Rt. 8"RCP 15'Rt.
2+78 ℄ Conc. Dr. 32'Rt. 8"RCP 16'Rt.
20 drs.

BM. 115.44 Top thimble ℄ 15TH & Hydraulic.
BM. 117.25 Standard NE corner 17TH & Hydraulic.

PENNSYLVANIA AVE.
NL. 15TH to NL. 16TH
26-2-30 AC.

City of Wichita, Kansas
L. K. White City Engineer
Sept. 1951 Proj. No. C11-31.

L. K. WHITE
LICENSED
55
KANSAS
PROFESSIONAL ENGINEER