


1942

PENNSYLVANIA AVE. — N.L. THIRD TO S.L. CENTRAL

+0.217%
0.8' MK

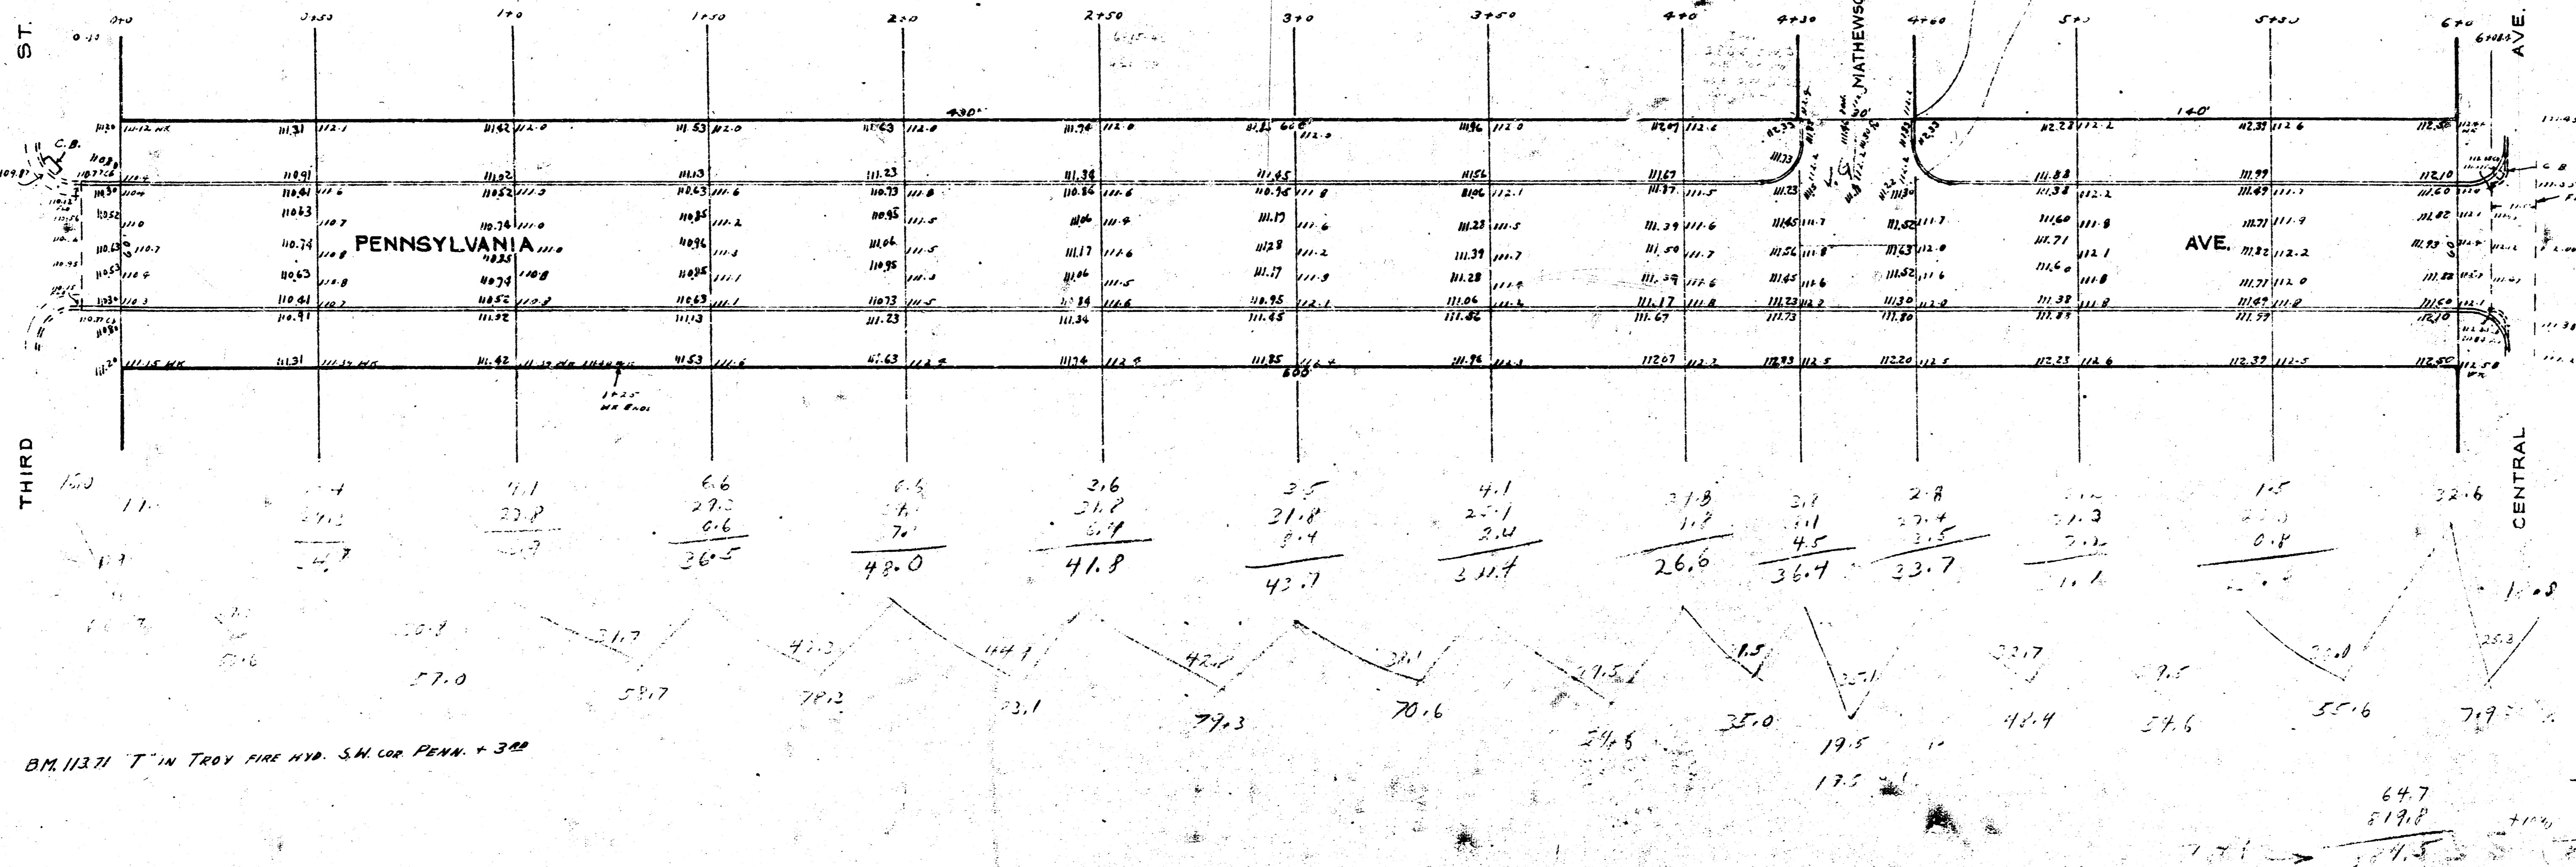

B.M. 113.71 T IN TROY FIRE HYD. S.M. COR. PENN. + 300

NOTE: REBUILD RETURN WITH 10' R.