


PAYNE AVE. N. 15th to S. L. 17th St.

Actual Co. Grade
12902
Revised N.S. 1911

B.M. 119.65 R. in Sellers
back of walk S.
S.W. Cor. Payne & 15th

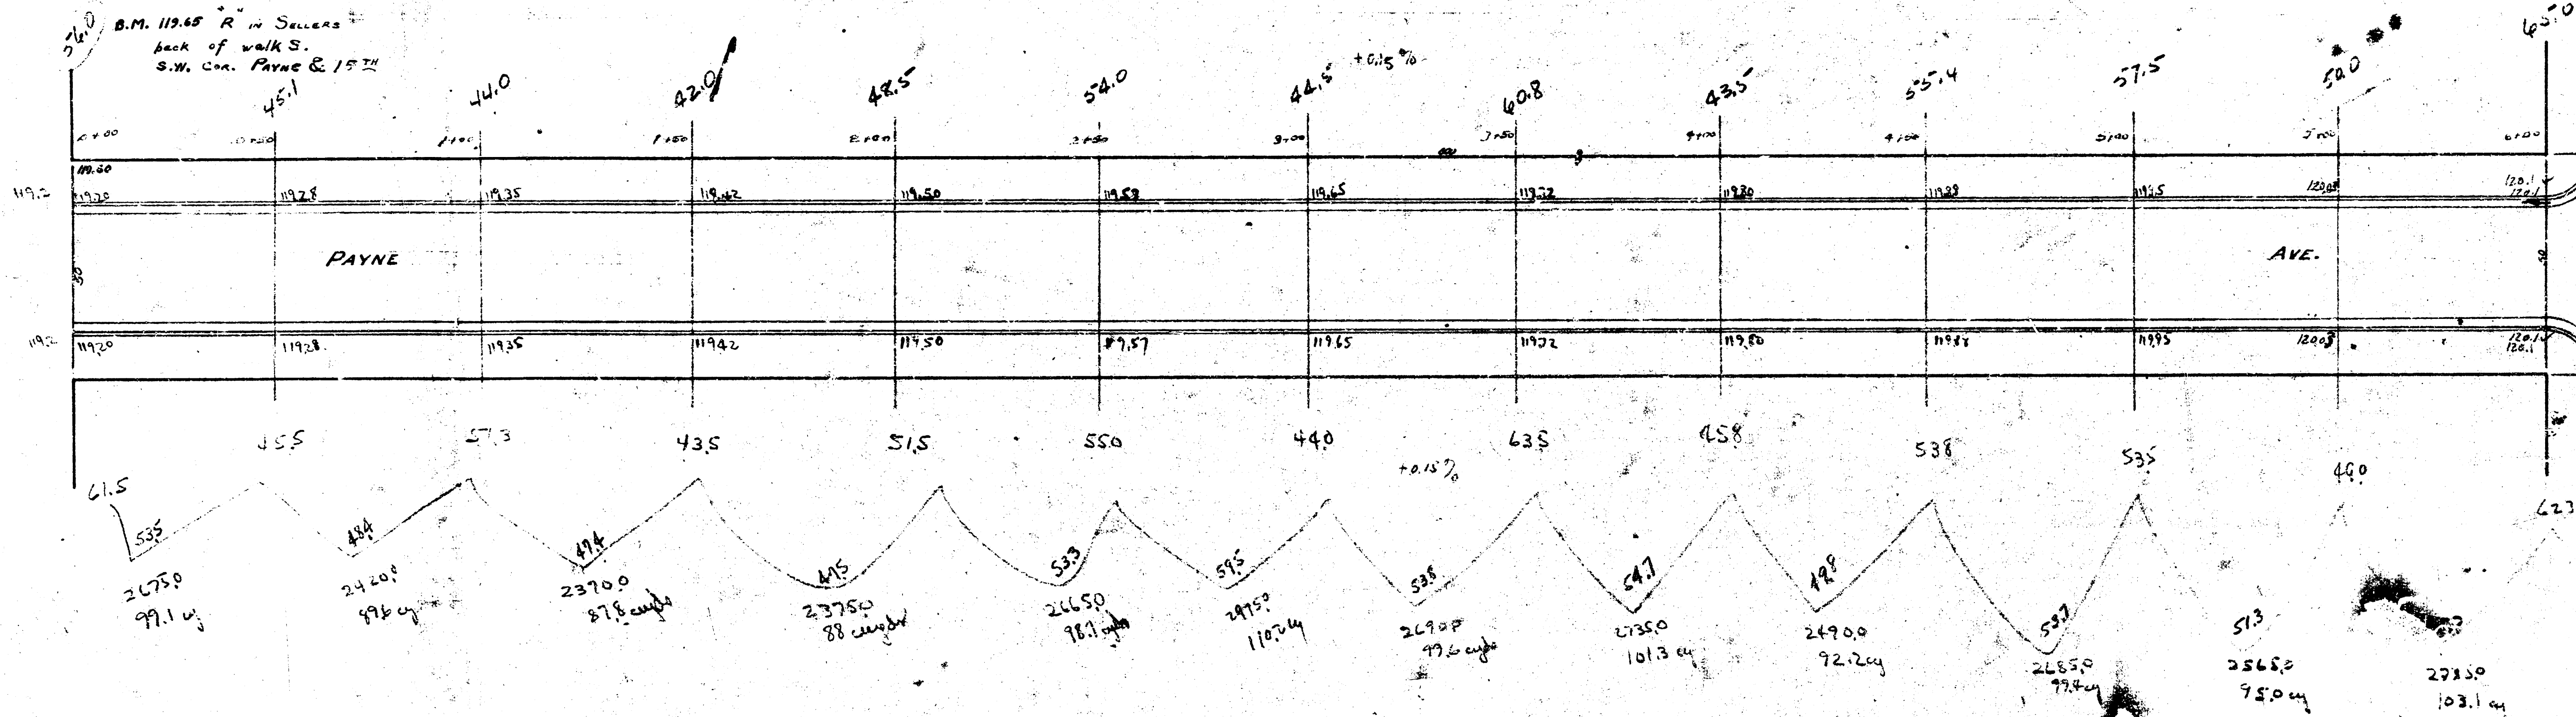

Grade: -22.26 + 22.2 = -2443.8
Cut: -17.1 + 17.9 = 197.0
2640.8