


DO NOT

Pavement not built as per plan
 changed by Field Engr
 JTE 7/25/51

No curve at Sta 2+50

STREET: PERRY AVE.
 LIMITS: N.L. MCKEE-WL. WOODBROW
 TYPE CONST: 30' CONC. & CB.
 CITY OF: WICHITA, KANSAS
 CITY ENGINEER: L.K. WHITE
 DATE: 3-13-51 PROJ. NO.: C10-182
 DEPARTMENT OF: ENGINEERING



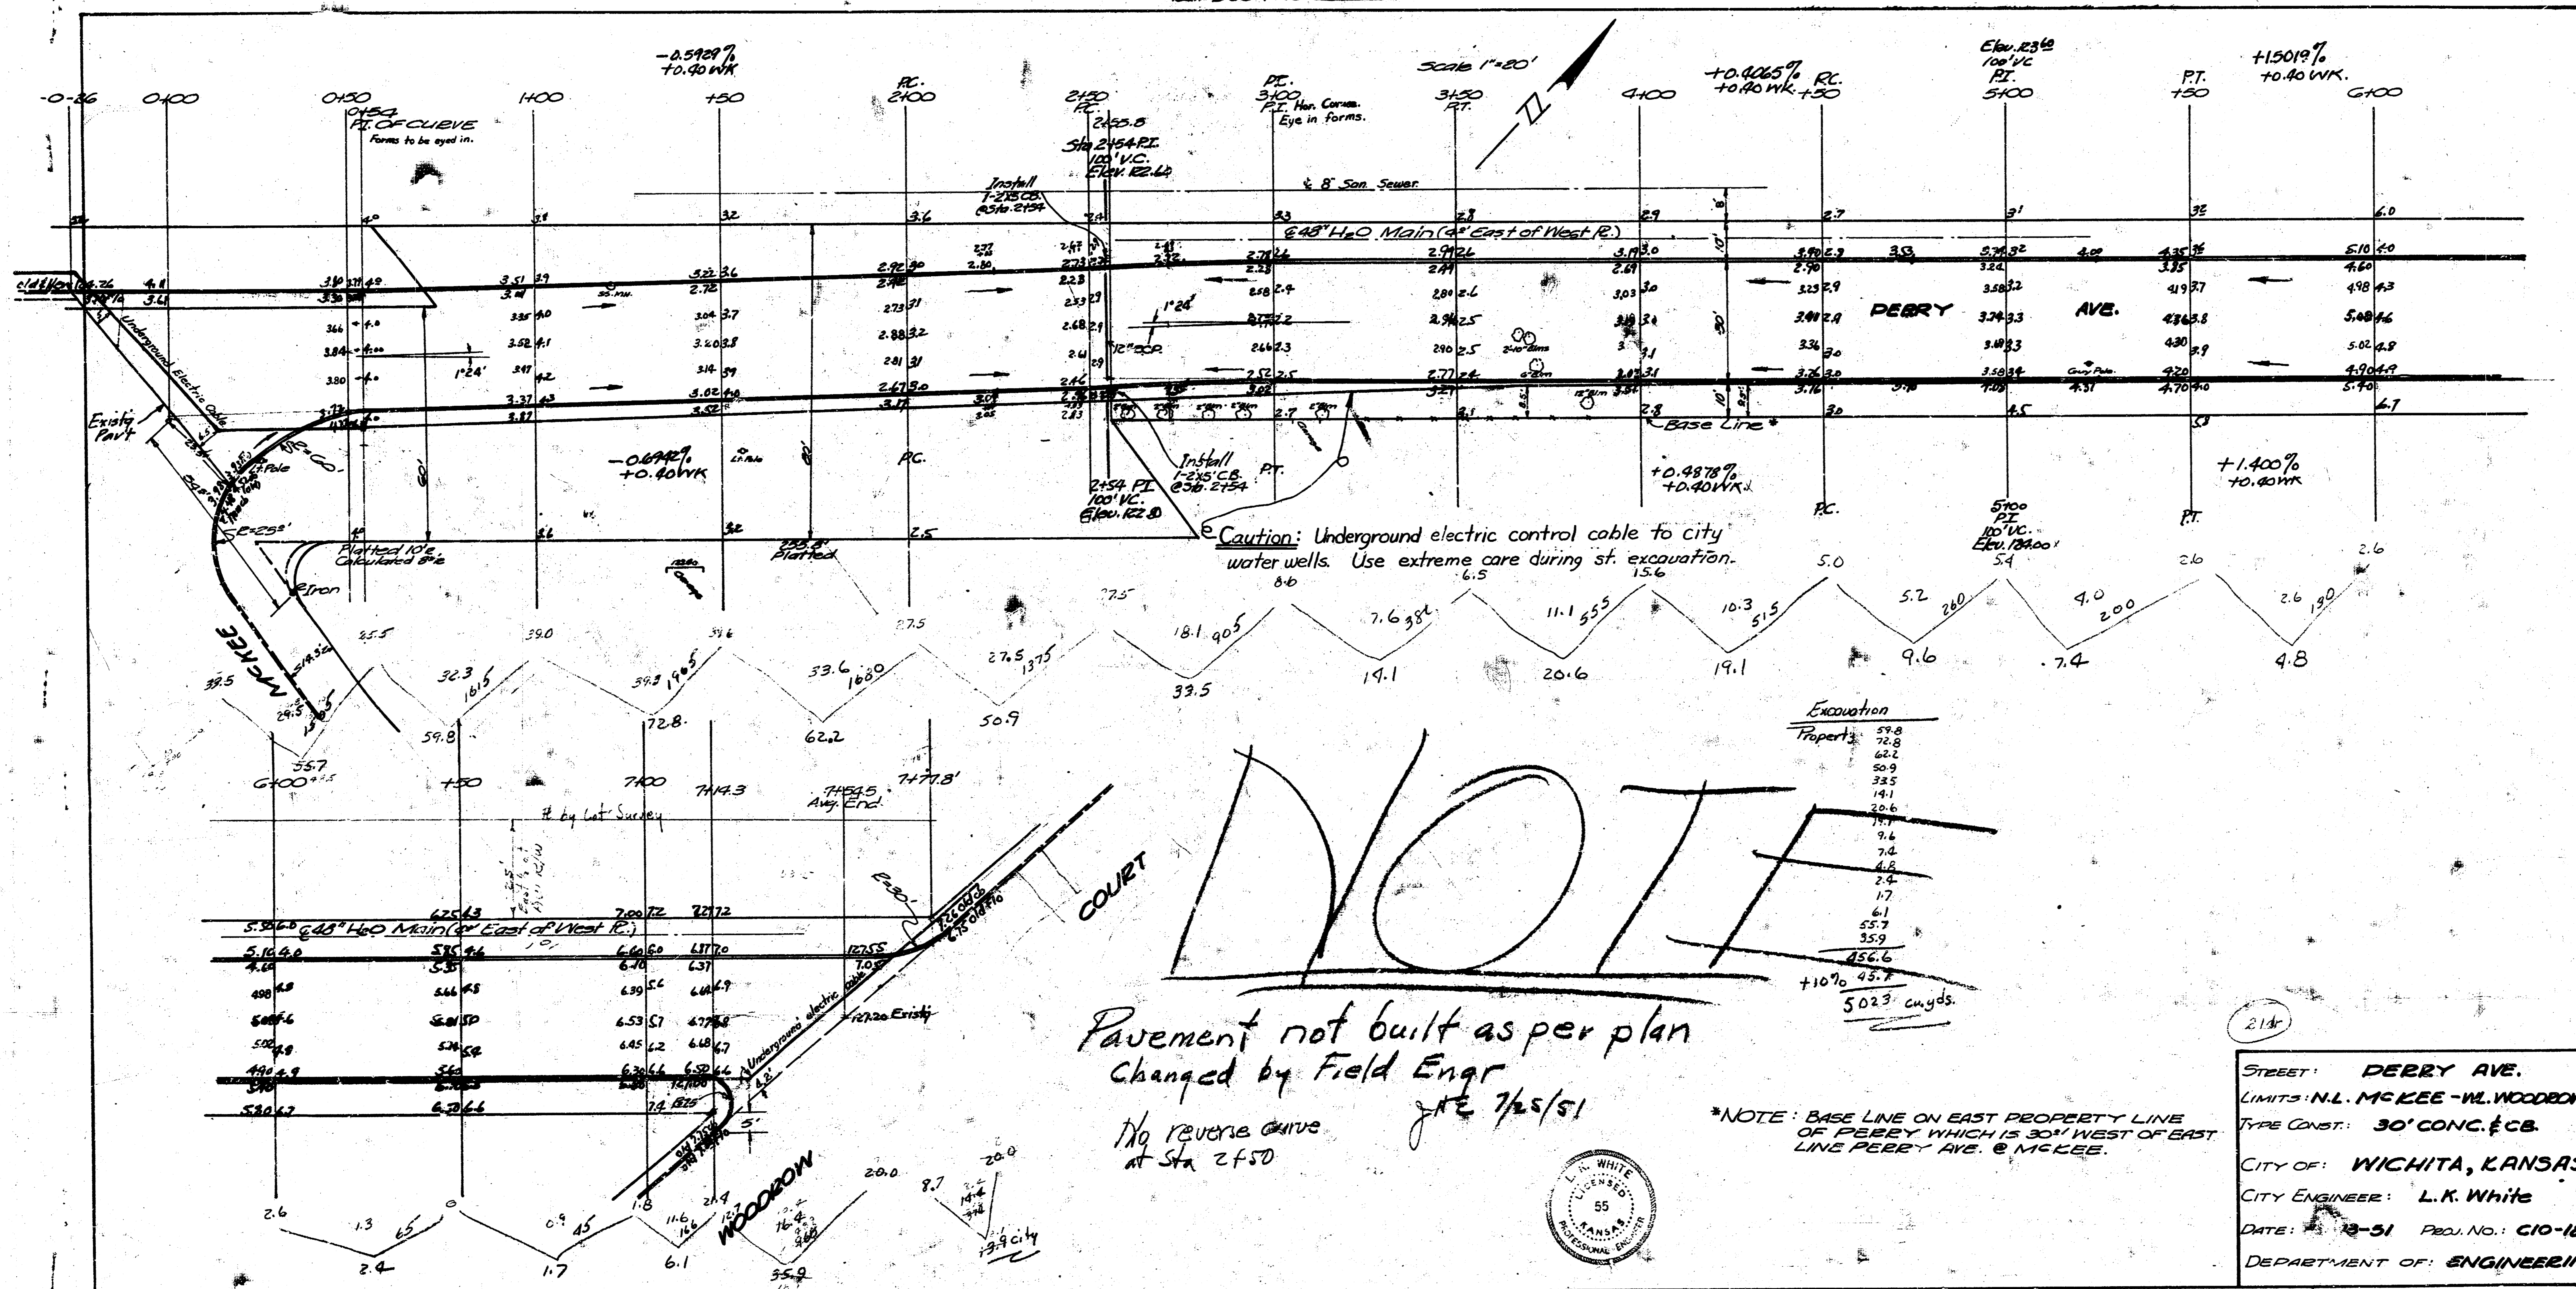


NOTE

Pavement not built as per plan
 changed by Field Engr
 No reverse curve
 at Sta 2+50
 JTE 7/5/51

*NOTE: BASE LINE ON EAST PROPERTY LINE
 OF PERRY WHICH IS 30' WEST OF EAST
 LINE PERRY AVE. @ MCLEE.

Excavation	
Property	59.8
	72.8
	62.2
	50.9
	14.1
	20.6
	19.1
	9.6
	7.4
	4.8
	2.6
	1.7
	6.1
	1.7
	2.4
	1.3
	2.6
	5023 cu yds.

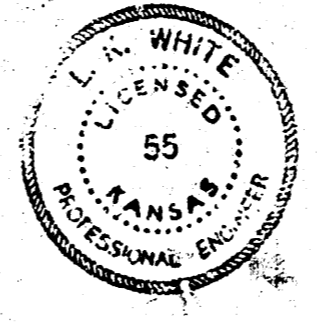

214

STREET: PERRY AVE.
 LIMITS: N.L. MCLEE - W.L. WOODROW
 TYPE CONST: 30' CONC. & CB.
 CITY OF: WICHITA, KANSAS
 CITY ENGINEER: L.K. White
 DATE: 7-51 PROJ. NO.: C10-182
 DEPARTMENT OF: ENGINEERING