


1941  
E + PERSHING - SL. KELLOGG TO N.L. ORME  
15' CONC.

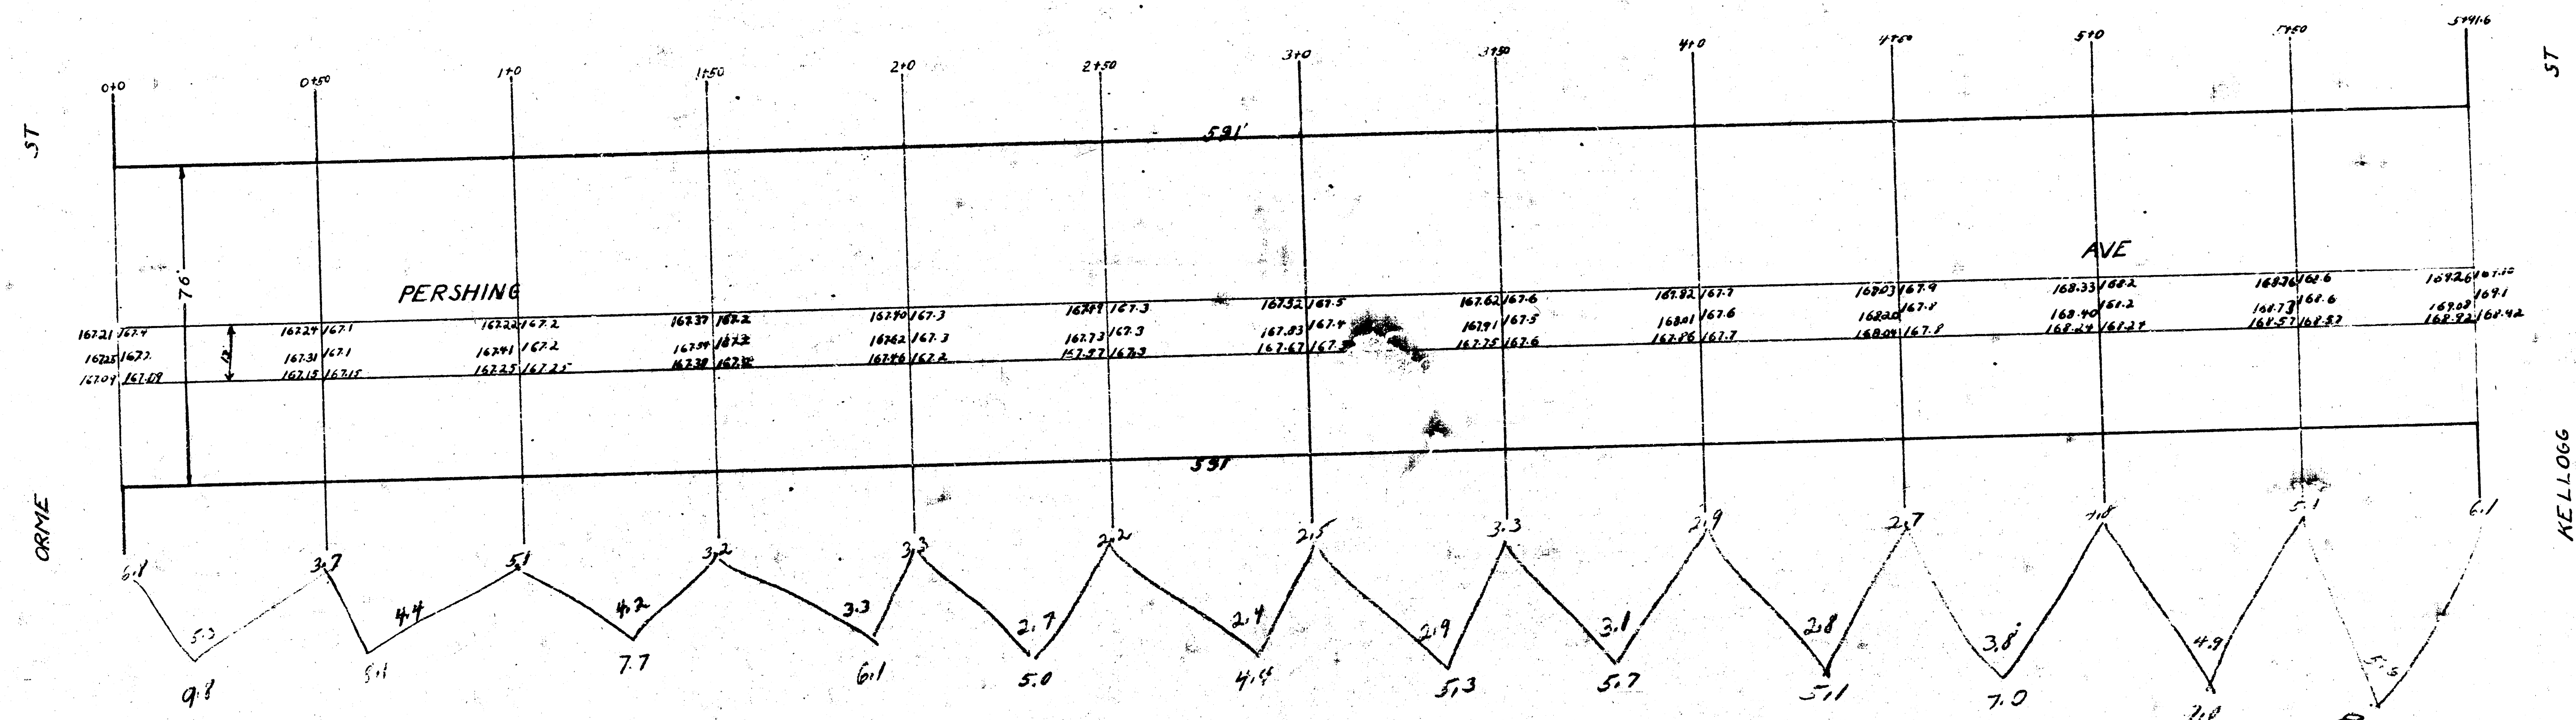


BM 'L' in LeFever D/Y Hg = 507 169.15

Property  
9.8  
4.1  
7.7  
6.1  
5.0  
4.4  
5.3  
5.1  
5.0  
2.0  
9.6

PROPERTY CUYD + 10.5 TOTAL  
82.5 8.3 90.8

B.M. Elev. ~~165.97~~ H.E. W.L. Delrose N.L. Orme.  
" " 162.15 "F" in Le Foyer in Drive" 507 S. Pershing

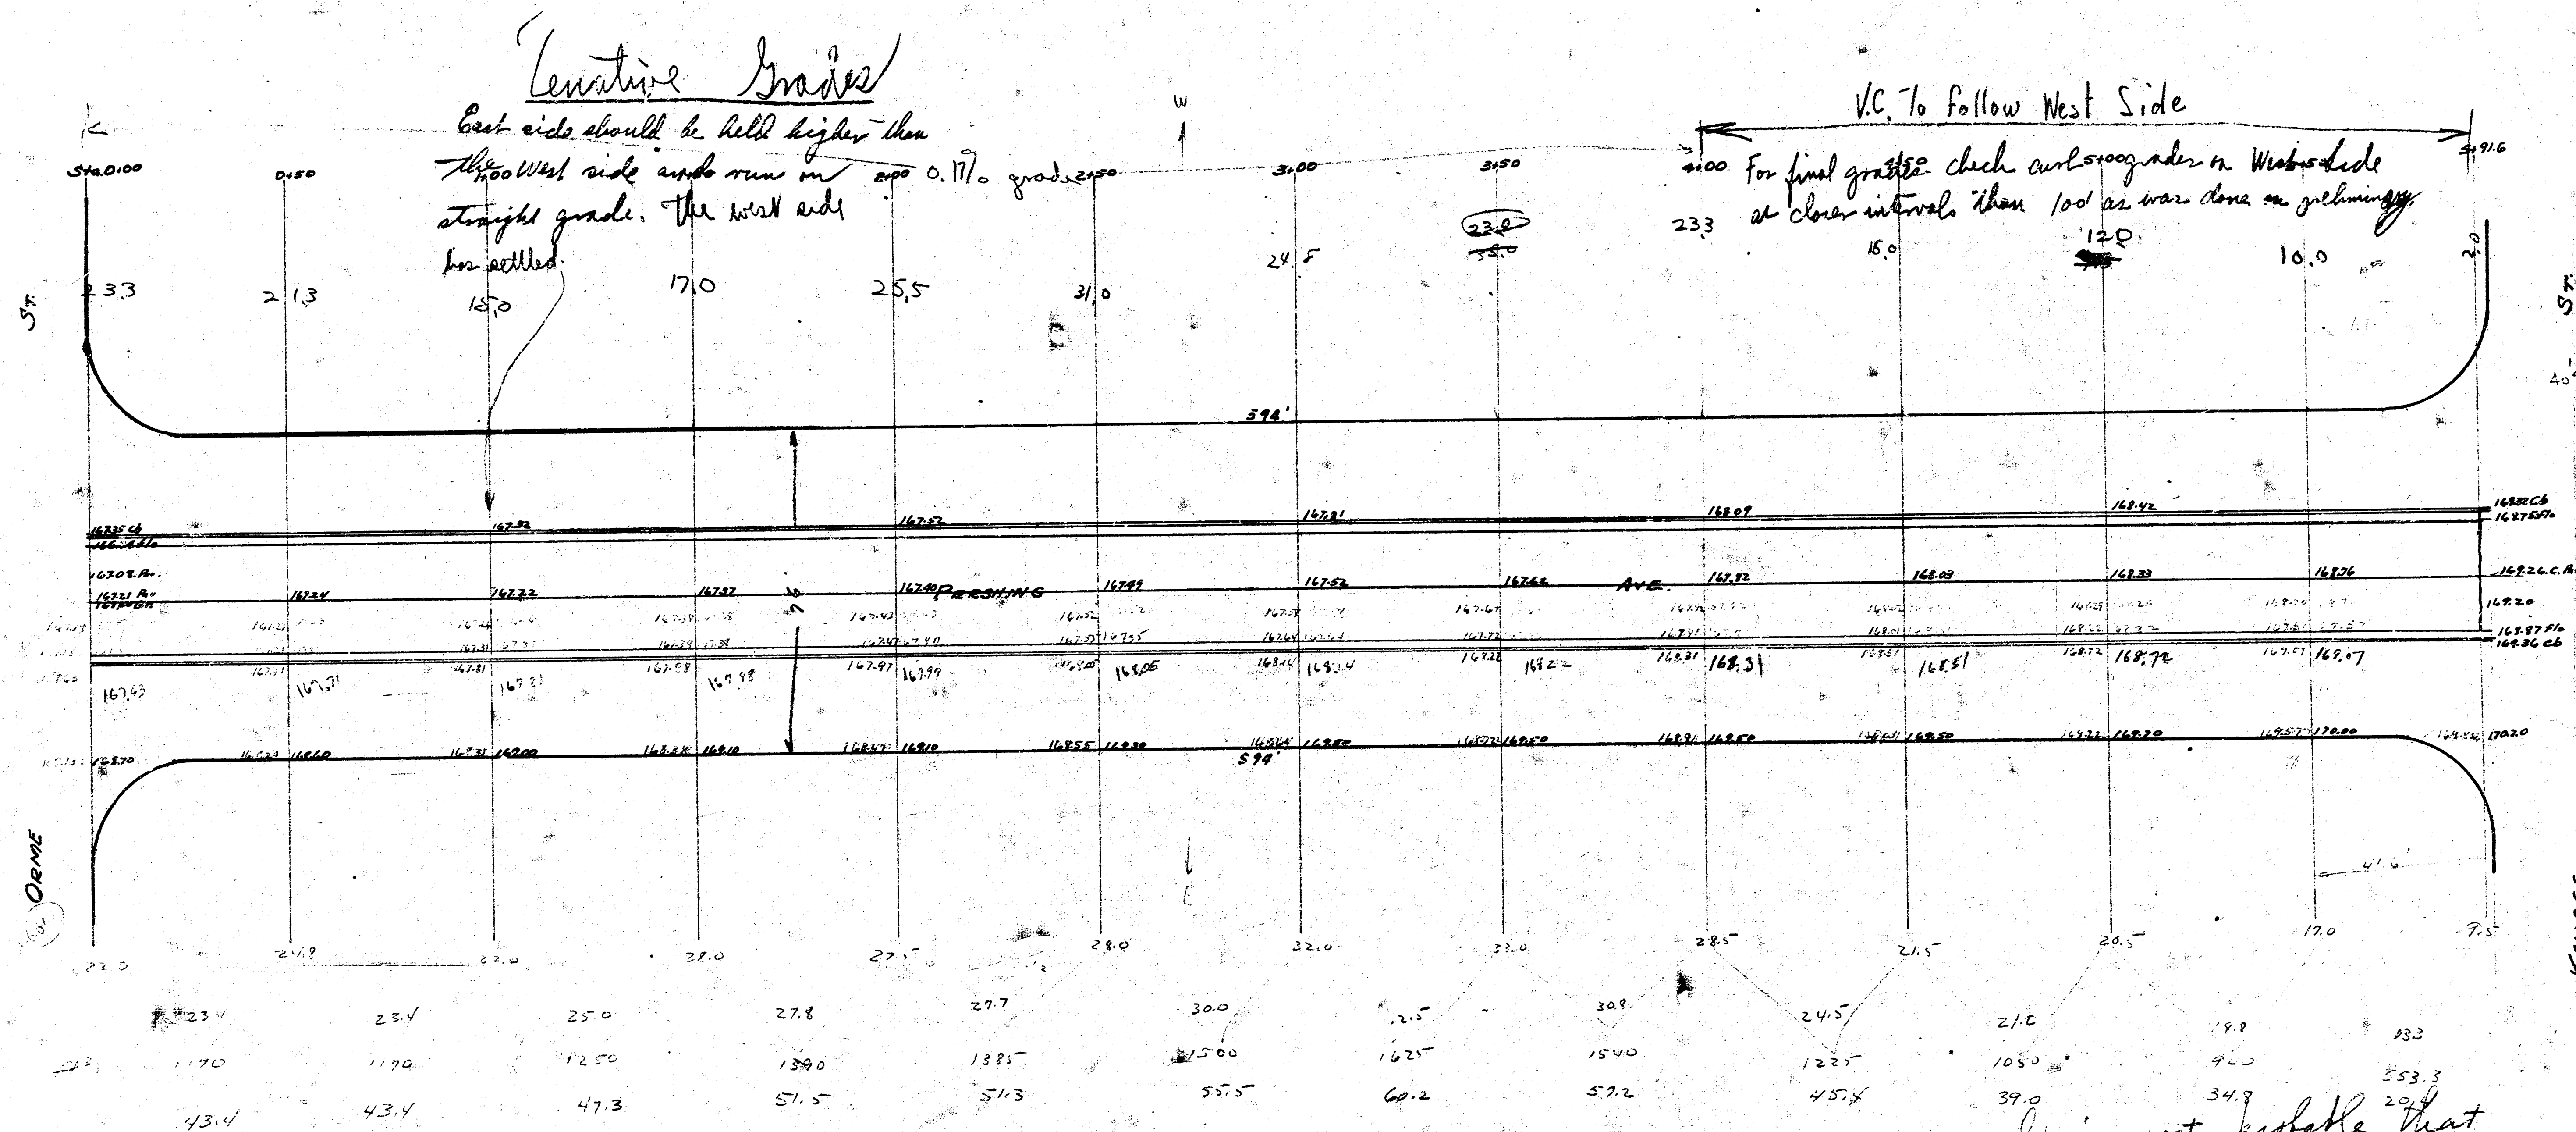

39.0                      34.9                      20.4  
It is not probable that  
excavation will be made  
more than 5' from the gutter  
into the street. Present street  
surface being well established.

PAYING PLAT  
PERSHING AVE.  
E3. 51. Kellows  
to  
NL. ORME  
1940.