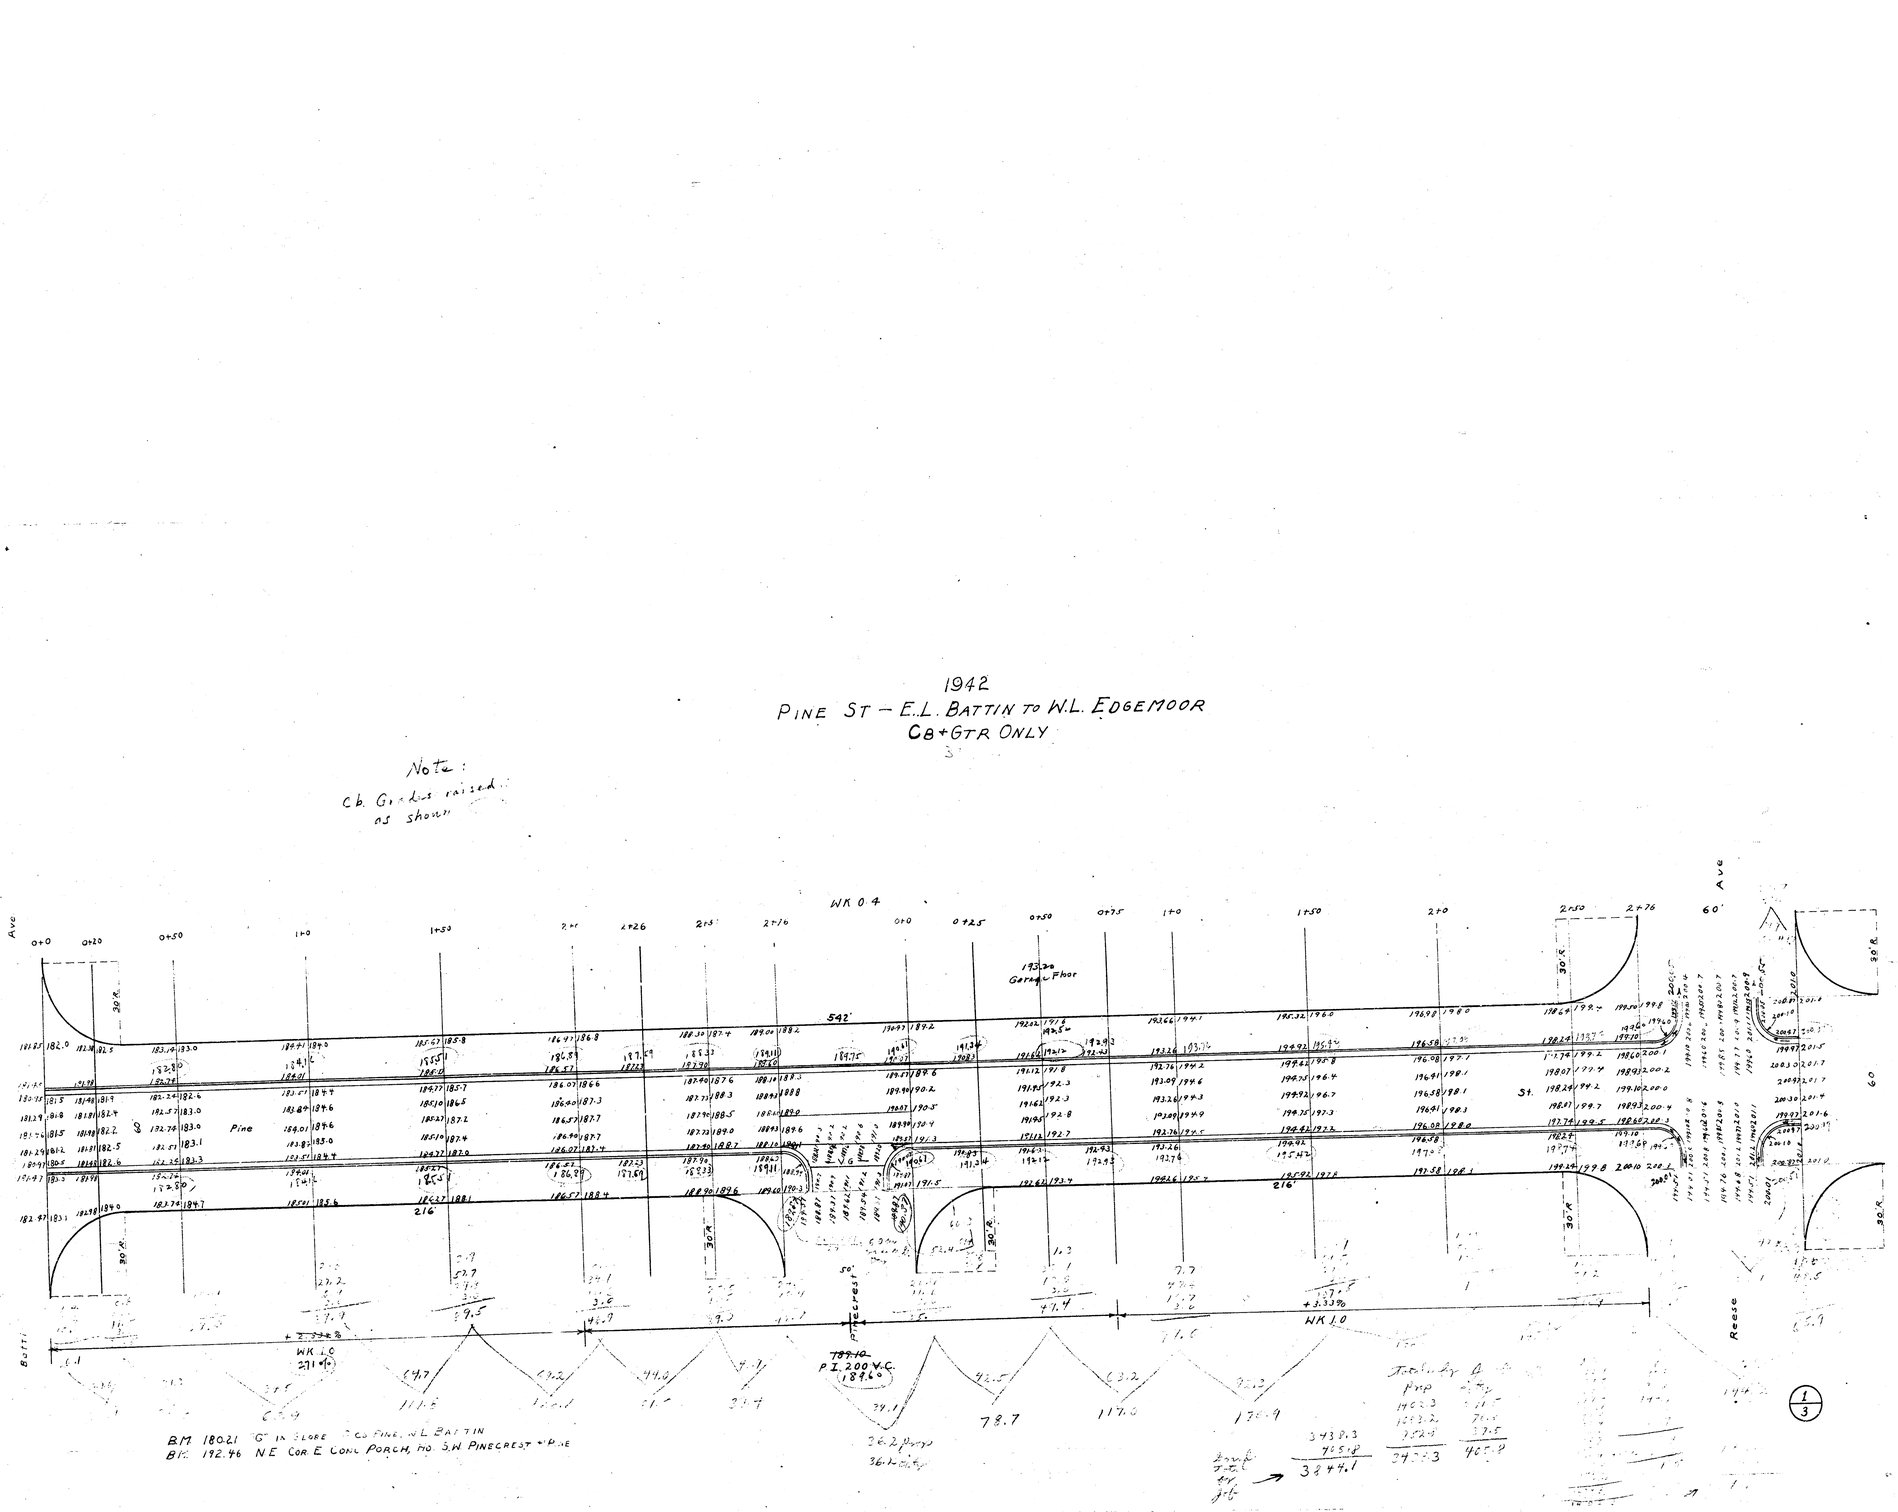
1942

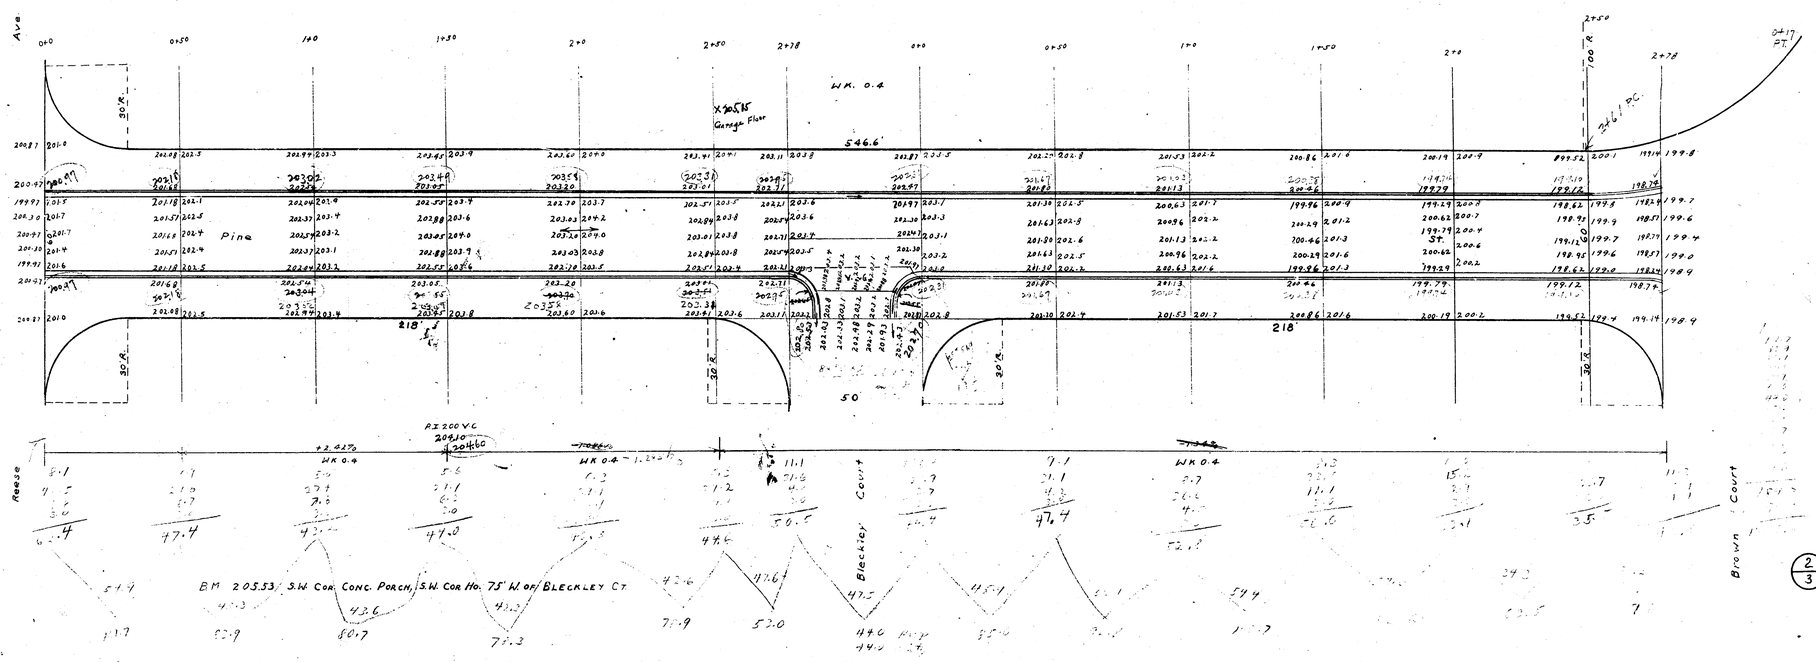
PINE ST – E.L. BATTIN TO W.L. EDGEMOOR

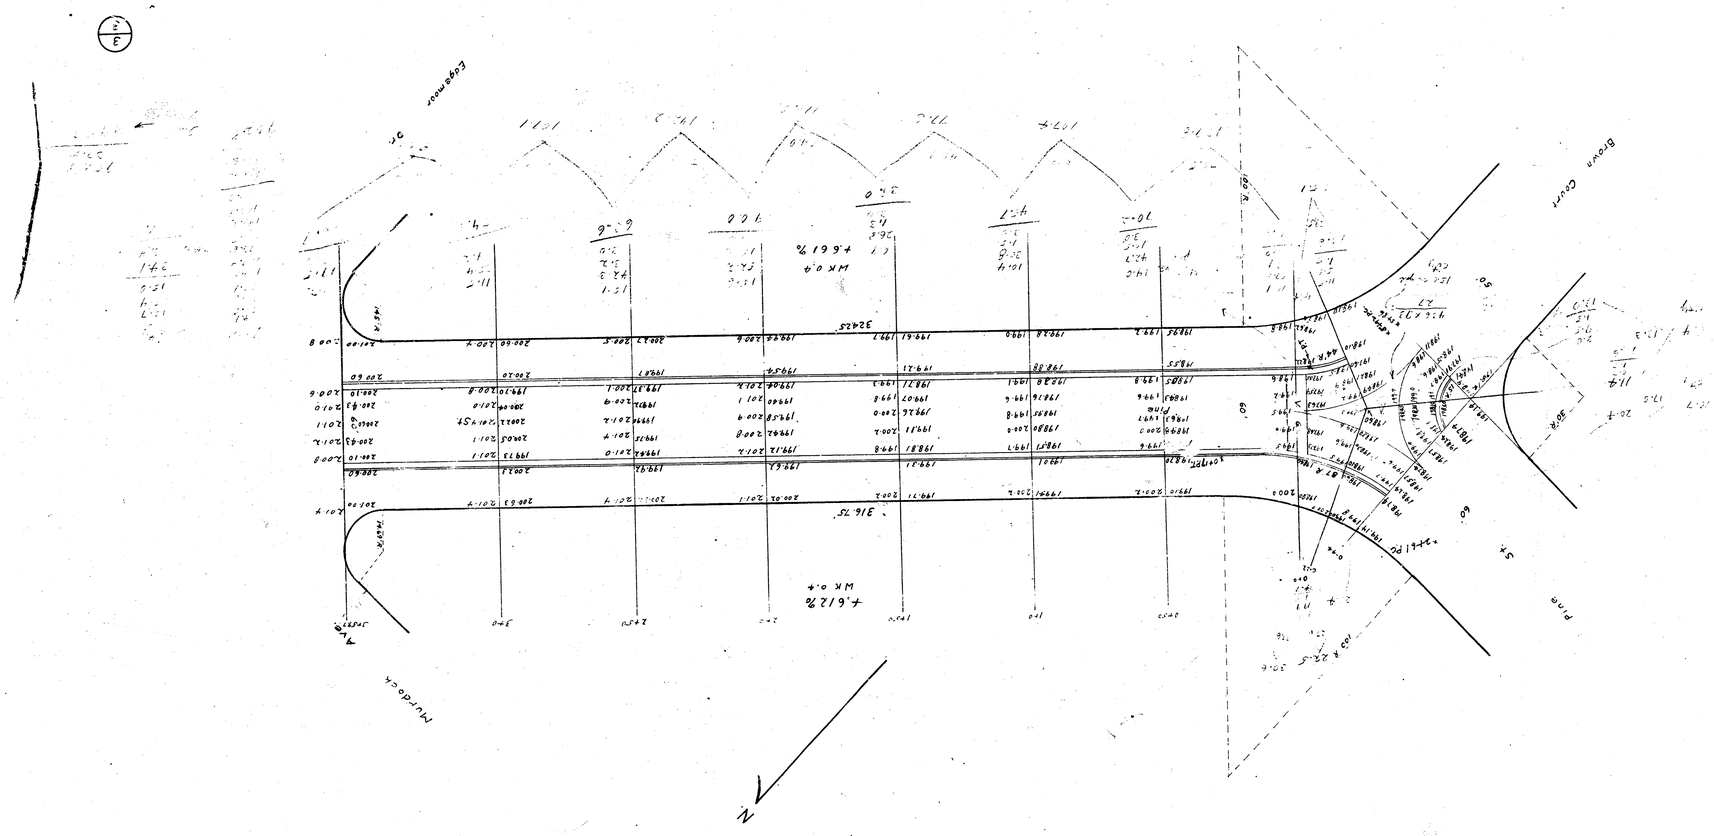
CB+GTR ONLY

Note:
Cb. Grades raised as shown



1/3


Ave
0+0
0+50
1+0
1+50
2+0
2+50
2+78
WK. 0.4
546.6'
X 202.55
Garage Floor
2+50
700 R
2+78
2+17
PT
30 R
Pine
218'
50
30 R
Reese
Bleckley Court
Brown Court
BM 205.53 S.W. Cor. Conc. Porch, S.W. Cor Ho. 75' W. of Bleckley Ct.
2/3


Edgemoor
Brown Court
Muirdock
Ave
Pine
N
WK 0.9
4.6.61 %
WK 0.4
4.6.12 %
324.25
316.75
PC
PT
S