


B.M. 10773 TOP IRON MAN & PIKE, STA 0+0
B.M. 10713 IRON IN THIN. C. LULU, N.S. LINCOLN

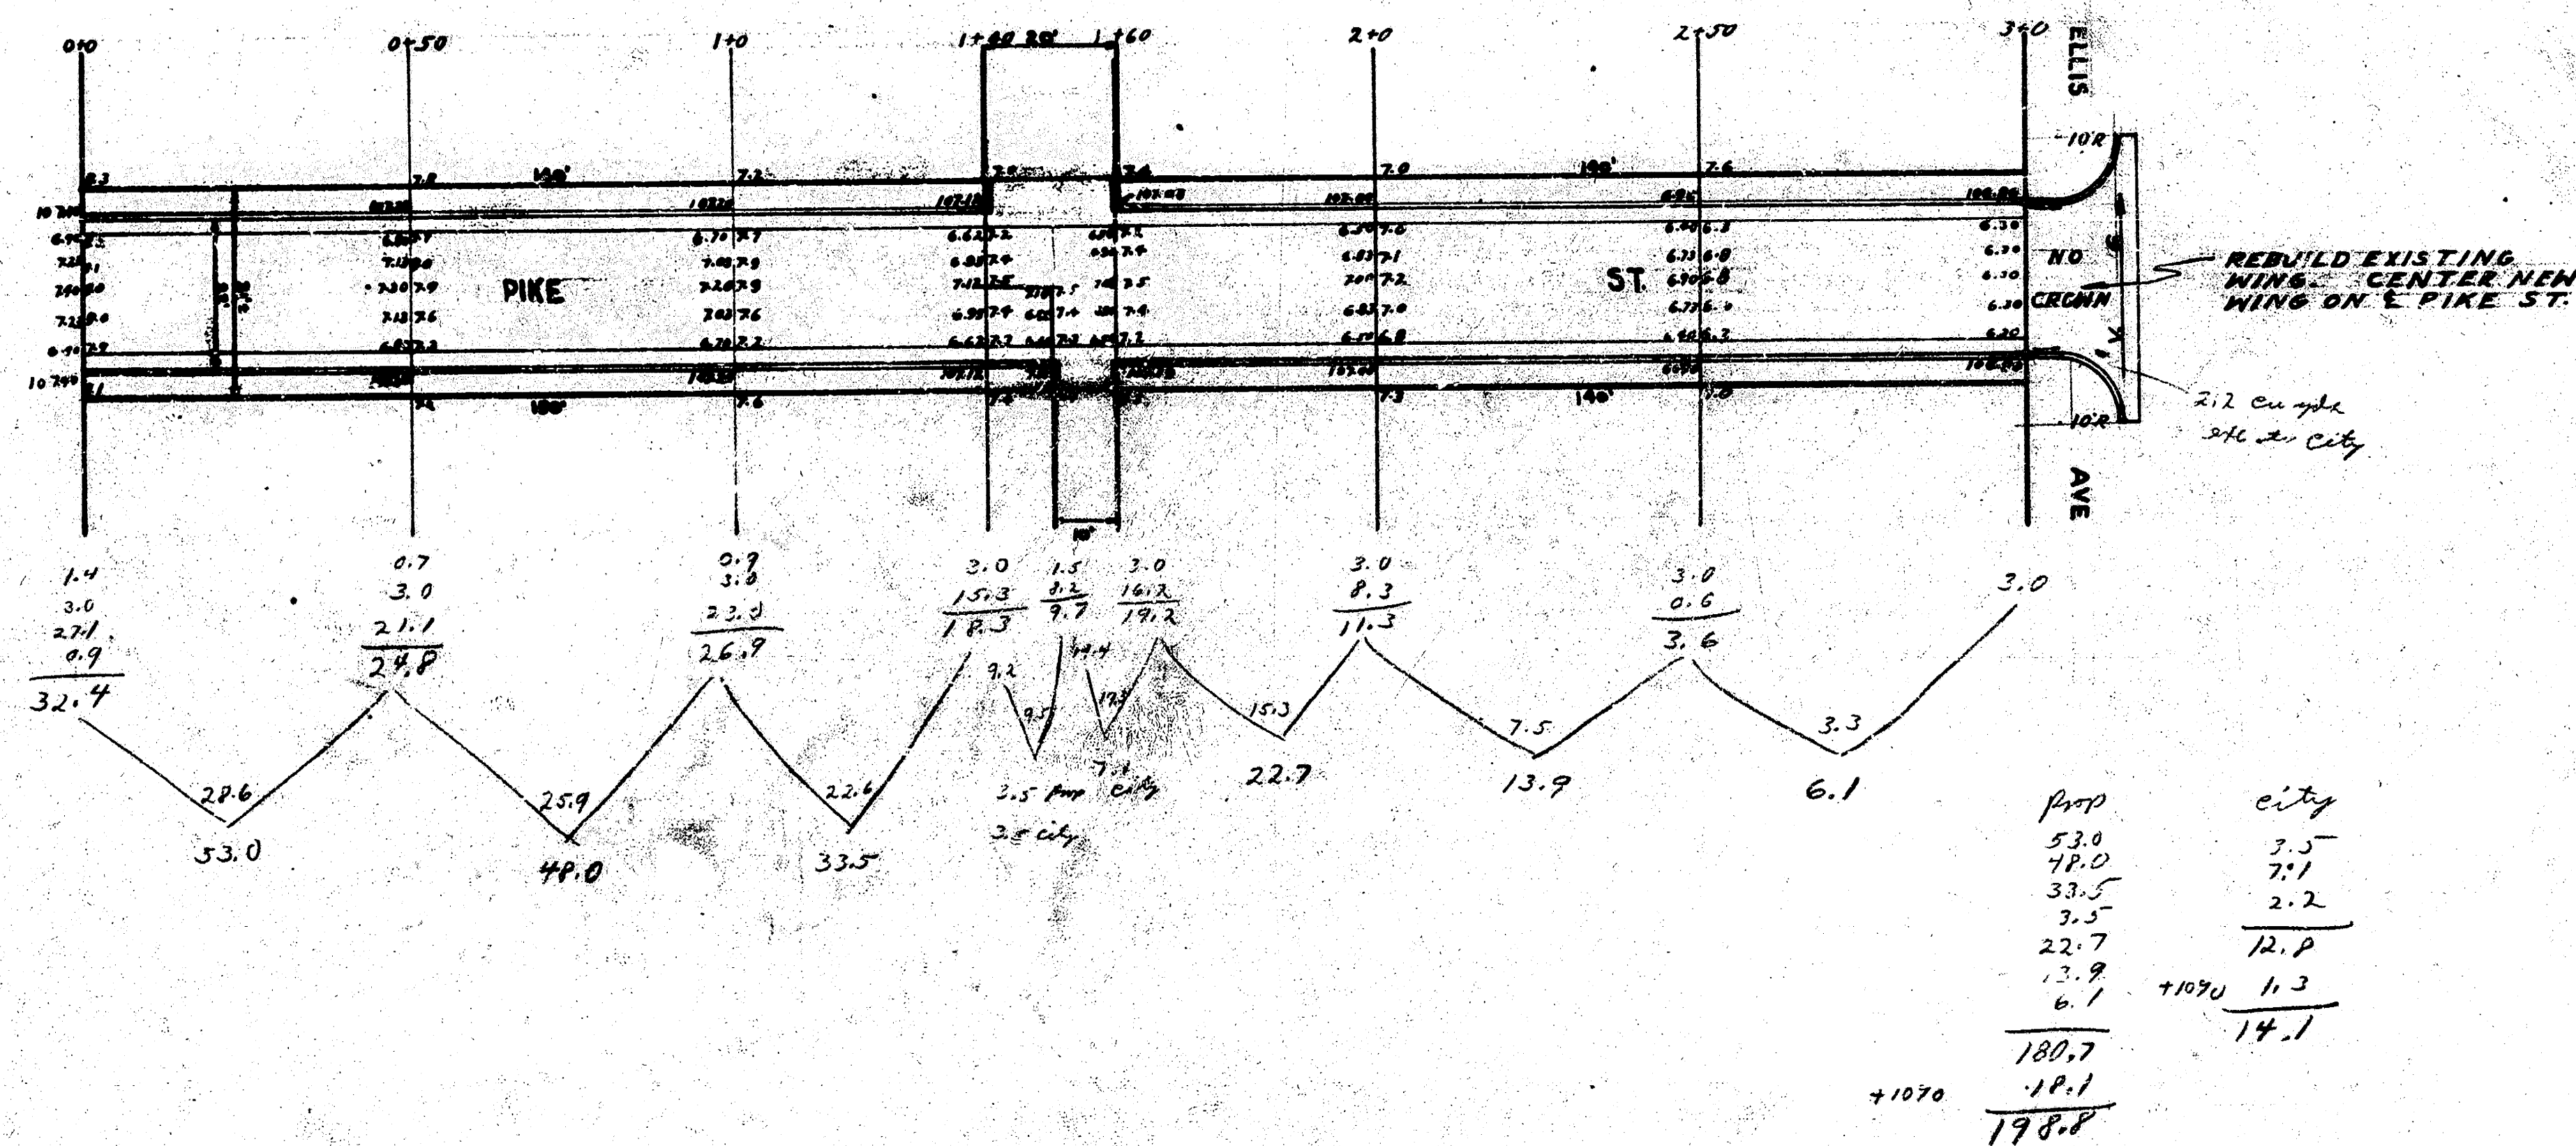

PIKE ST
W. ELLIS TO 300' WEST
COMBINED CURB & STR.
CITY OF WICHITA, KANSAS
L.K. WHITE CITY ENGINEER
1946

4 1 5 10