


B.M. 2034 "T" in Tray Top hyd. NE cor. Pine & OLD MANOR

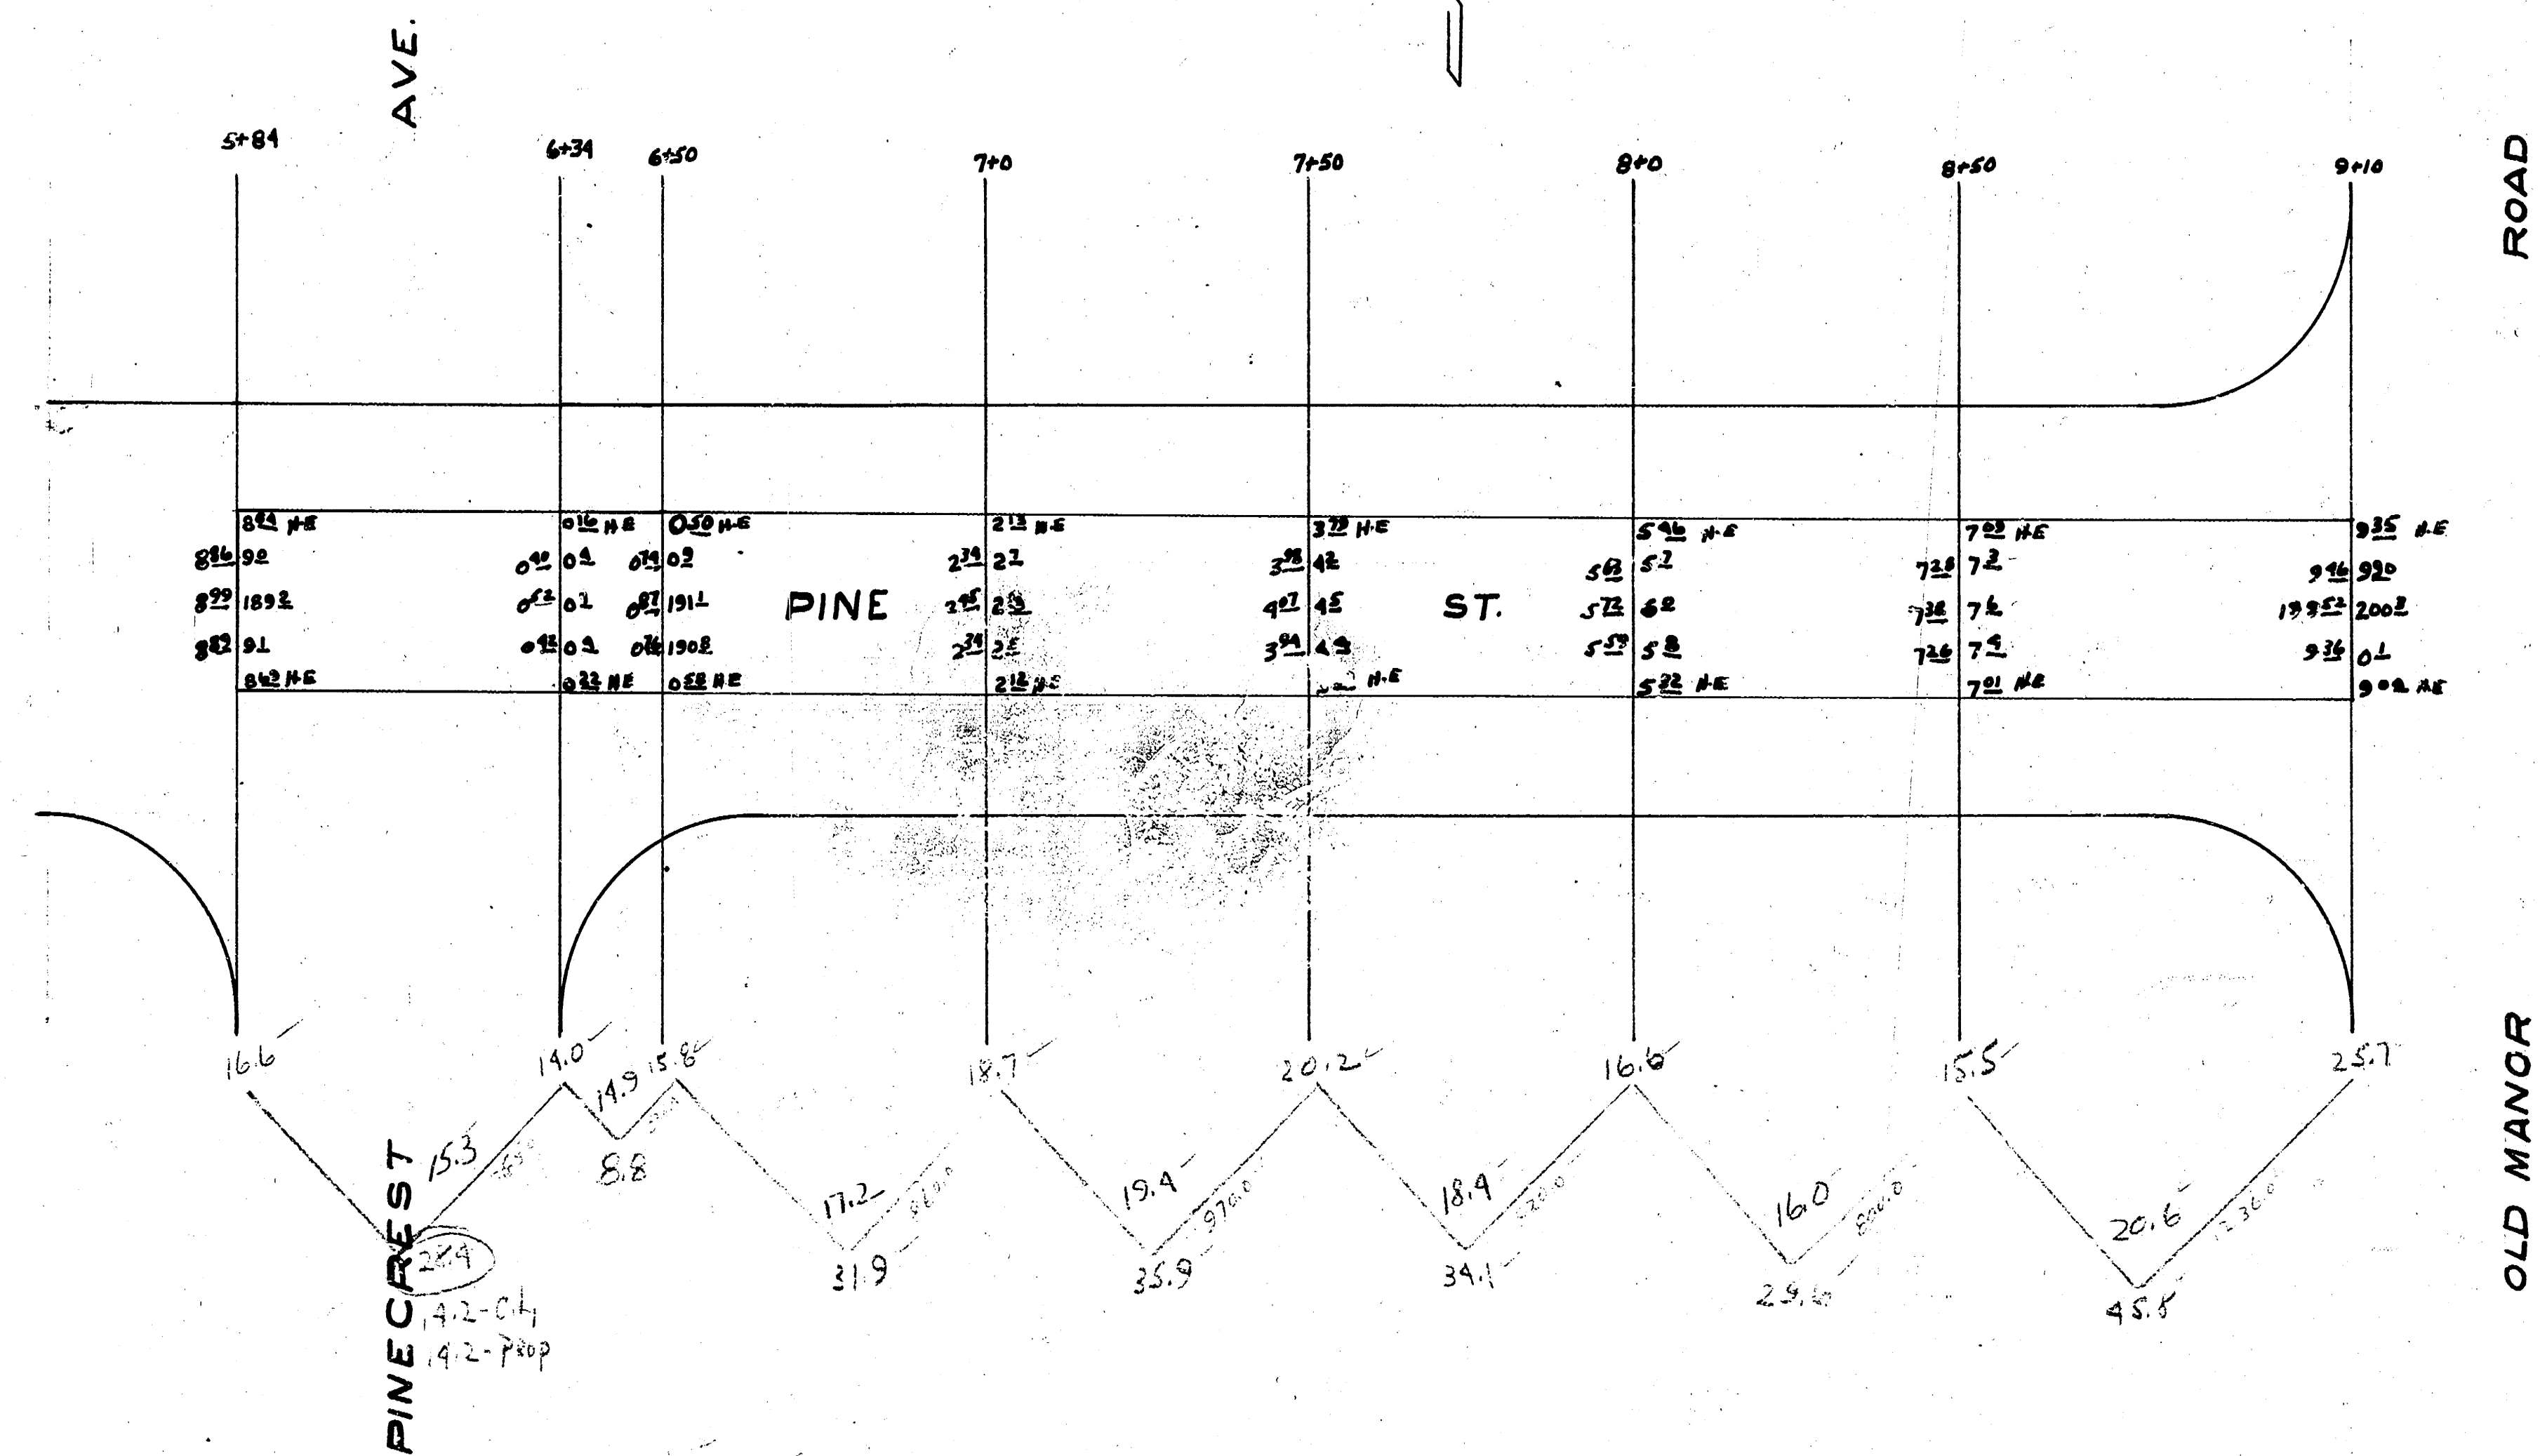

Prop
 19.2
 8.8
 3.0
 35.7
 34.1
 25.6
 45.8
 20.4 + 10.7
 260.2

City
 19.2
 1.9 + 10.3
 15.6

PINE ST.
 W.L. PINECREST W.L. OLD MANOR
 26'-CONC.
 CITY OF WICHITA, KANSAS
 L.K. WHITE CITY ENGINEER
 JULY 1947