




MG-5

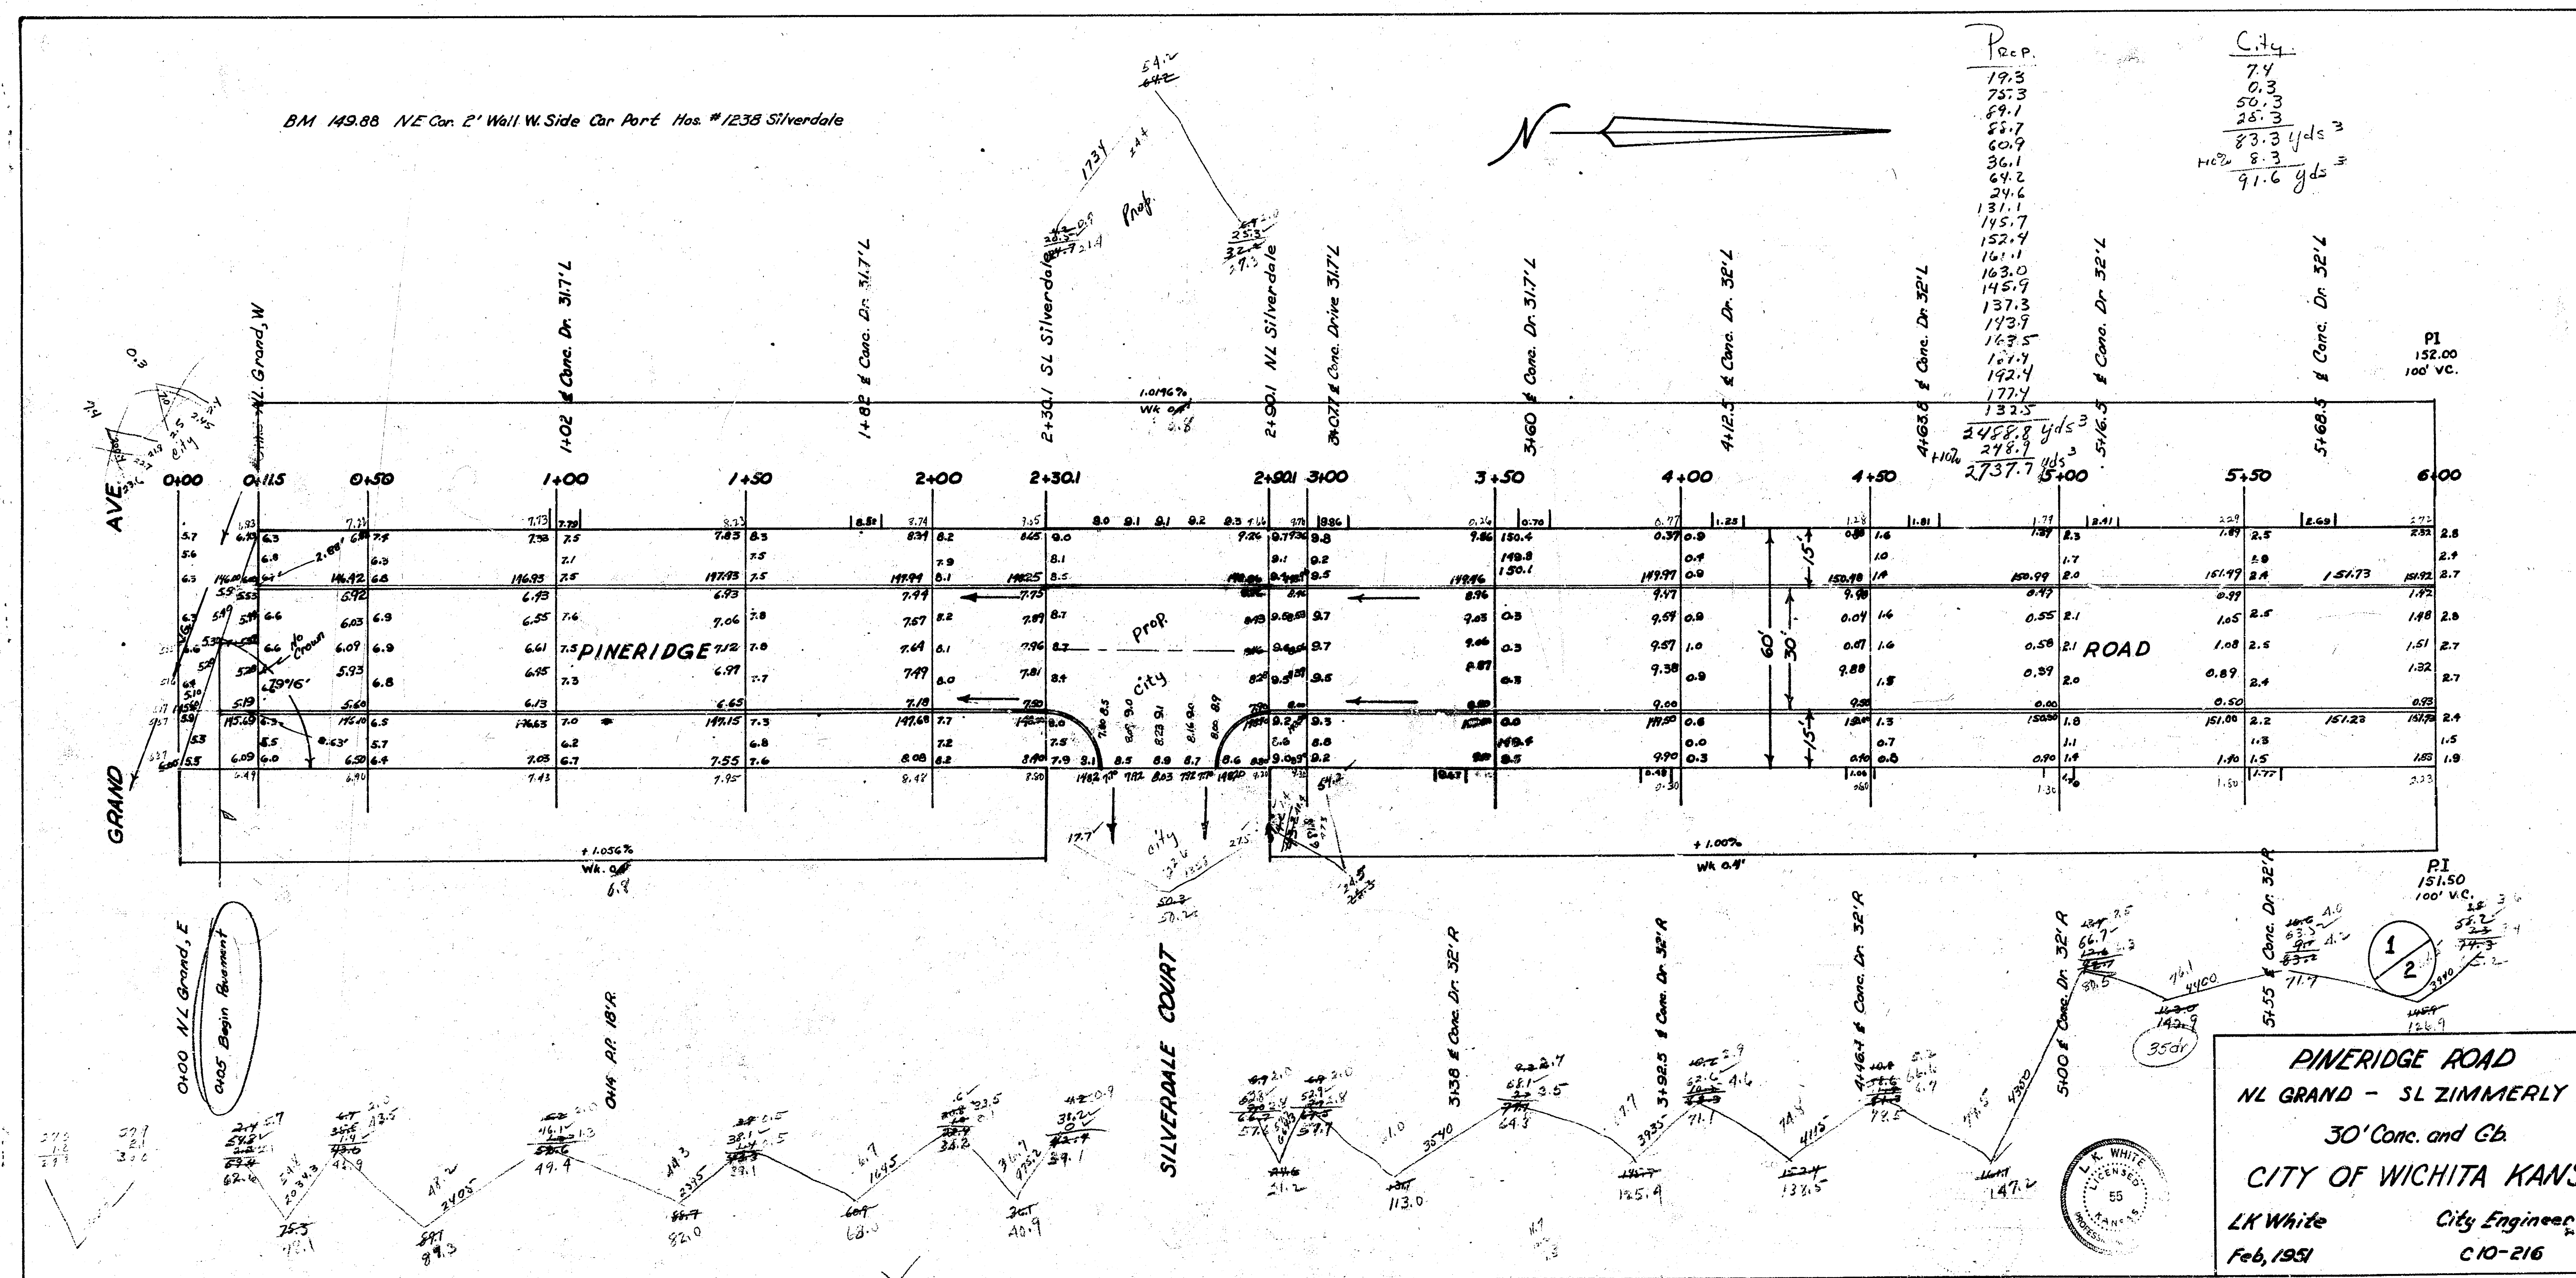

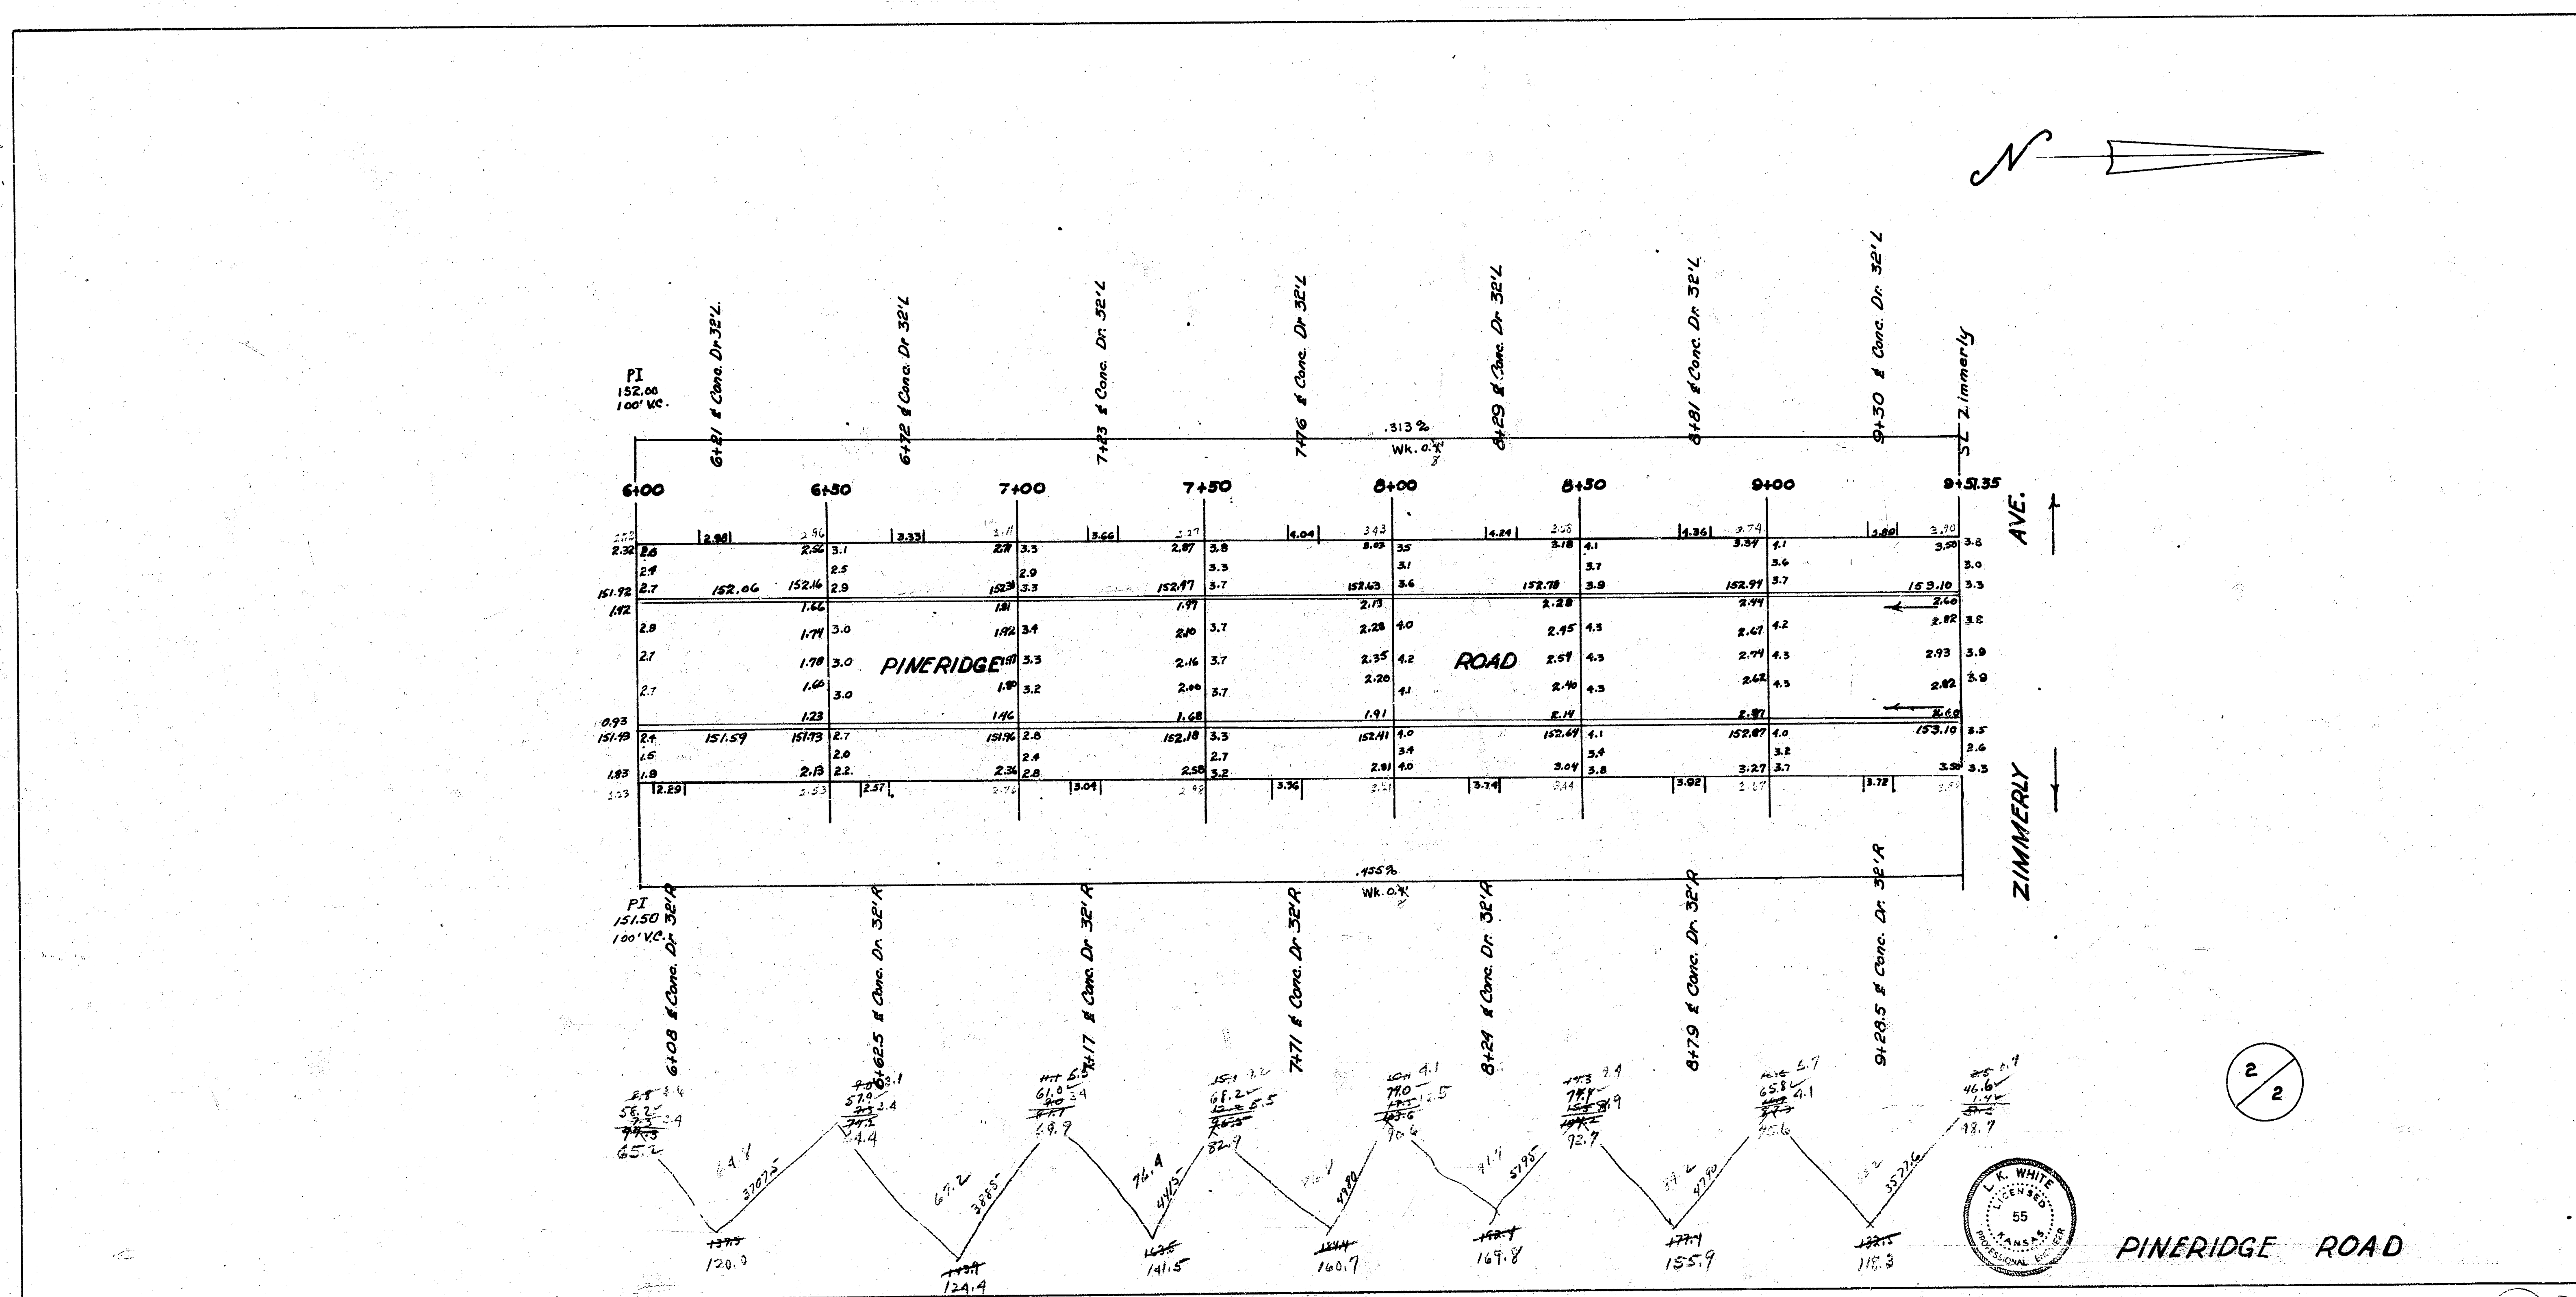

2/2

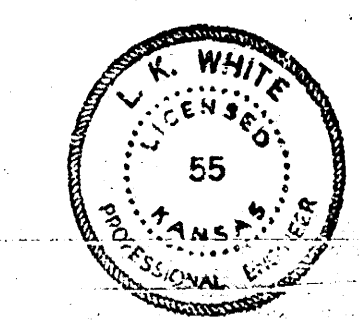

PINERIDGE ROAD

4 3 4 54