


BM. 146.89 Standard SW corner Edgemoor and Harry.

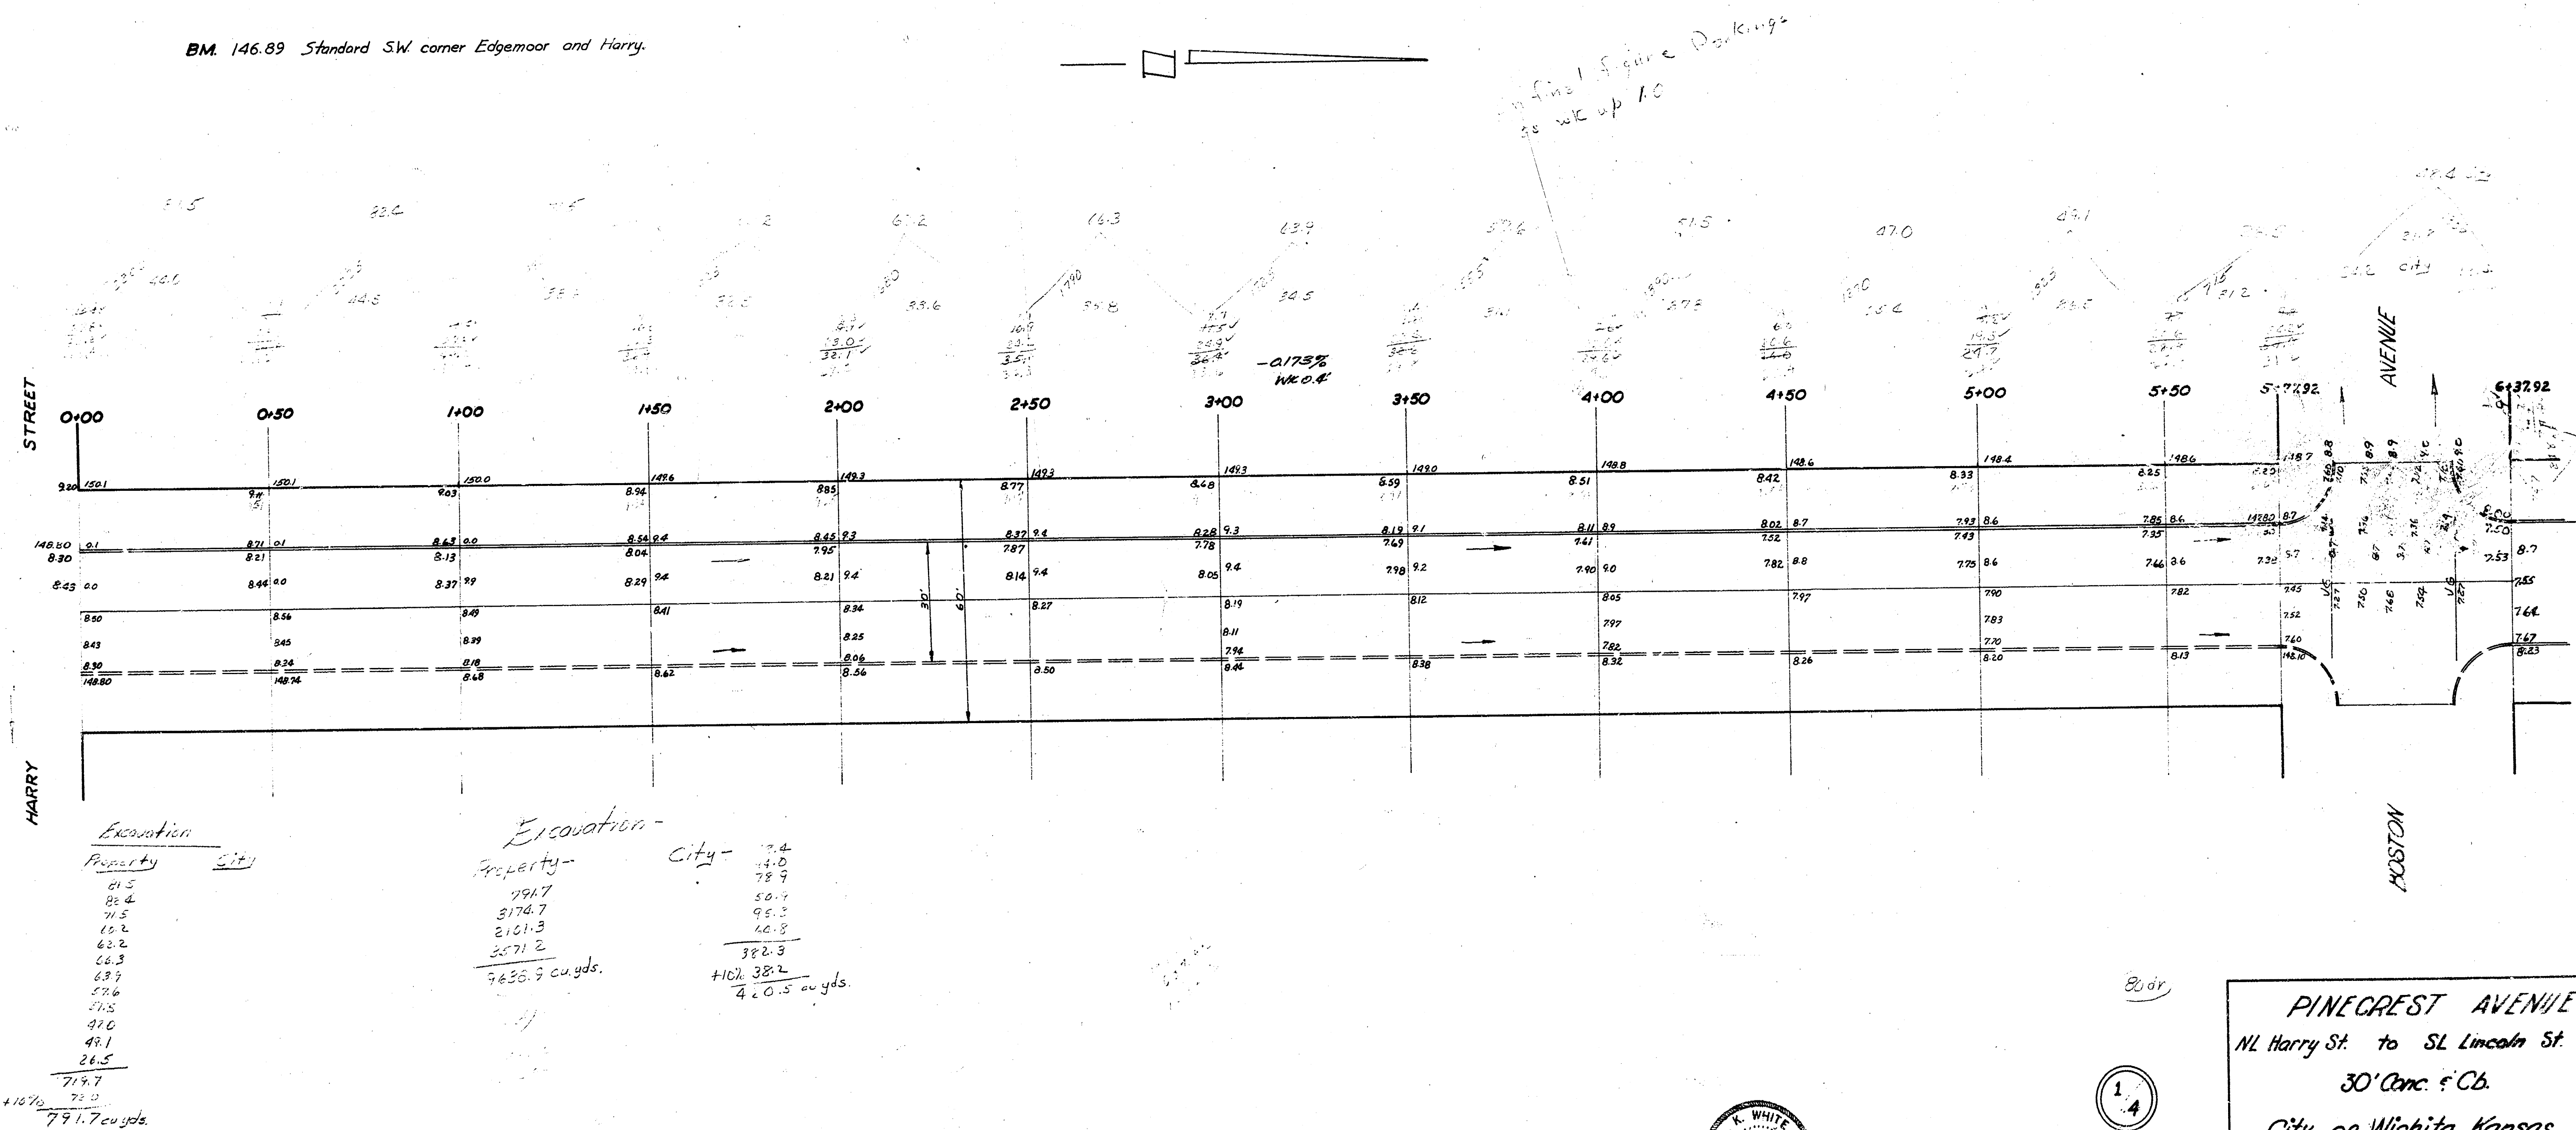


Excavation

Property	City
21.5	7.4
26.4	14.0
71.5	78.7
62.2	50.1
68.3	95.3
68.7	40.8
57.6	382.3
57.5	
47.0	
44.1	
26.5	
714.7	
72.0	
791.7 cu yds.	


Excavation


Property	City
194.7	7.4
2174.7	14.0
2101.3	78.7
2571.2	50.1
	95.3
	40.8
	382.3
9636.3 cu yds.	
	101.382
	40.5 cu yds.

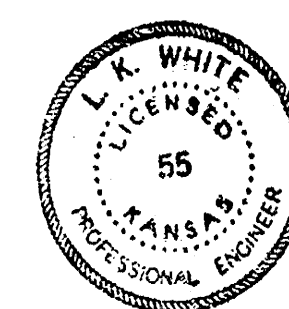


1.4

PINECREST AVENUE
N. Harry St. to S. Lincoln St.
30' Conc. & Cb.
City of Wichita Kansas
L.K. White City Engineer
April, 1951 Proj. No. C10-173

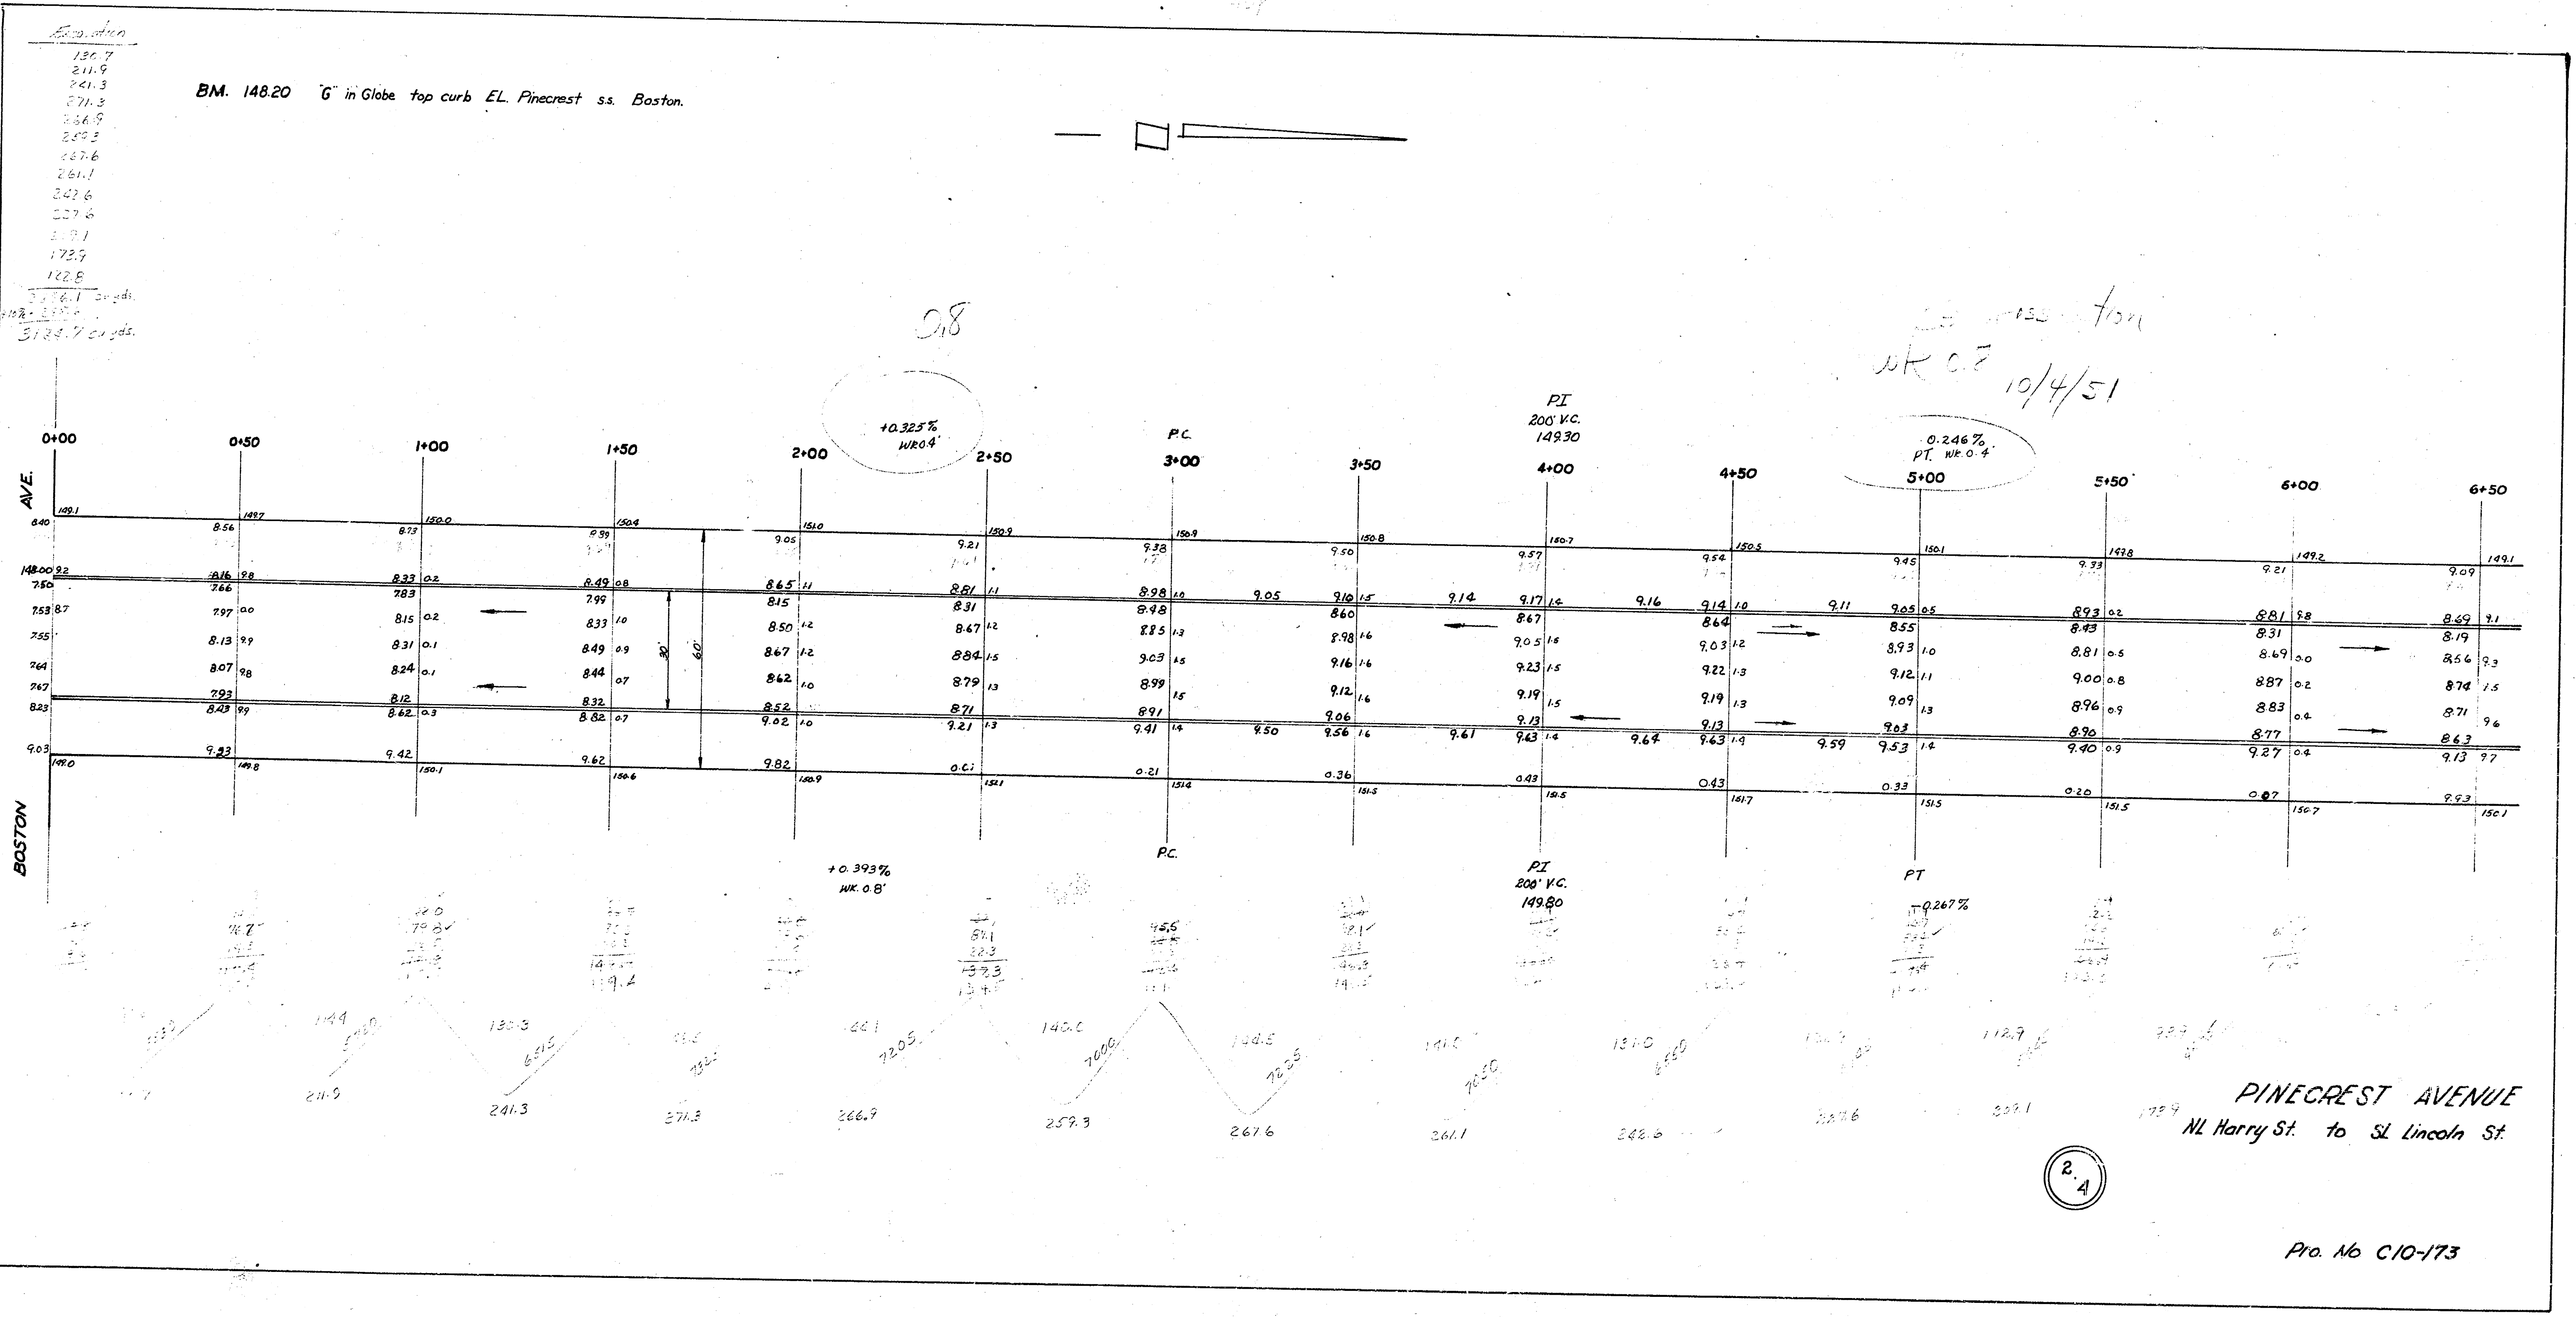

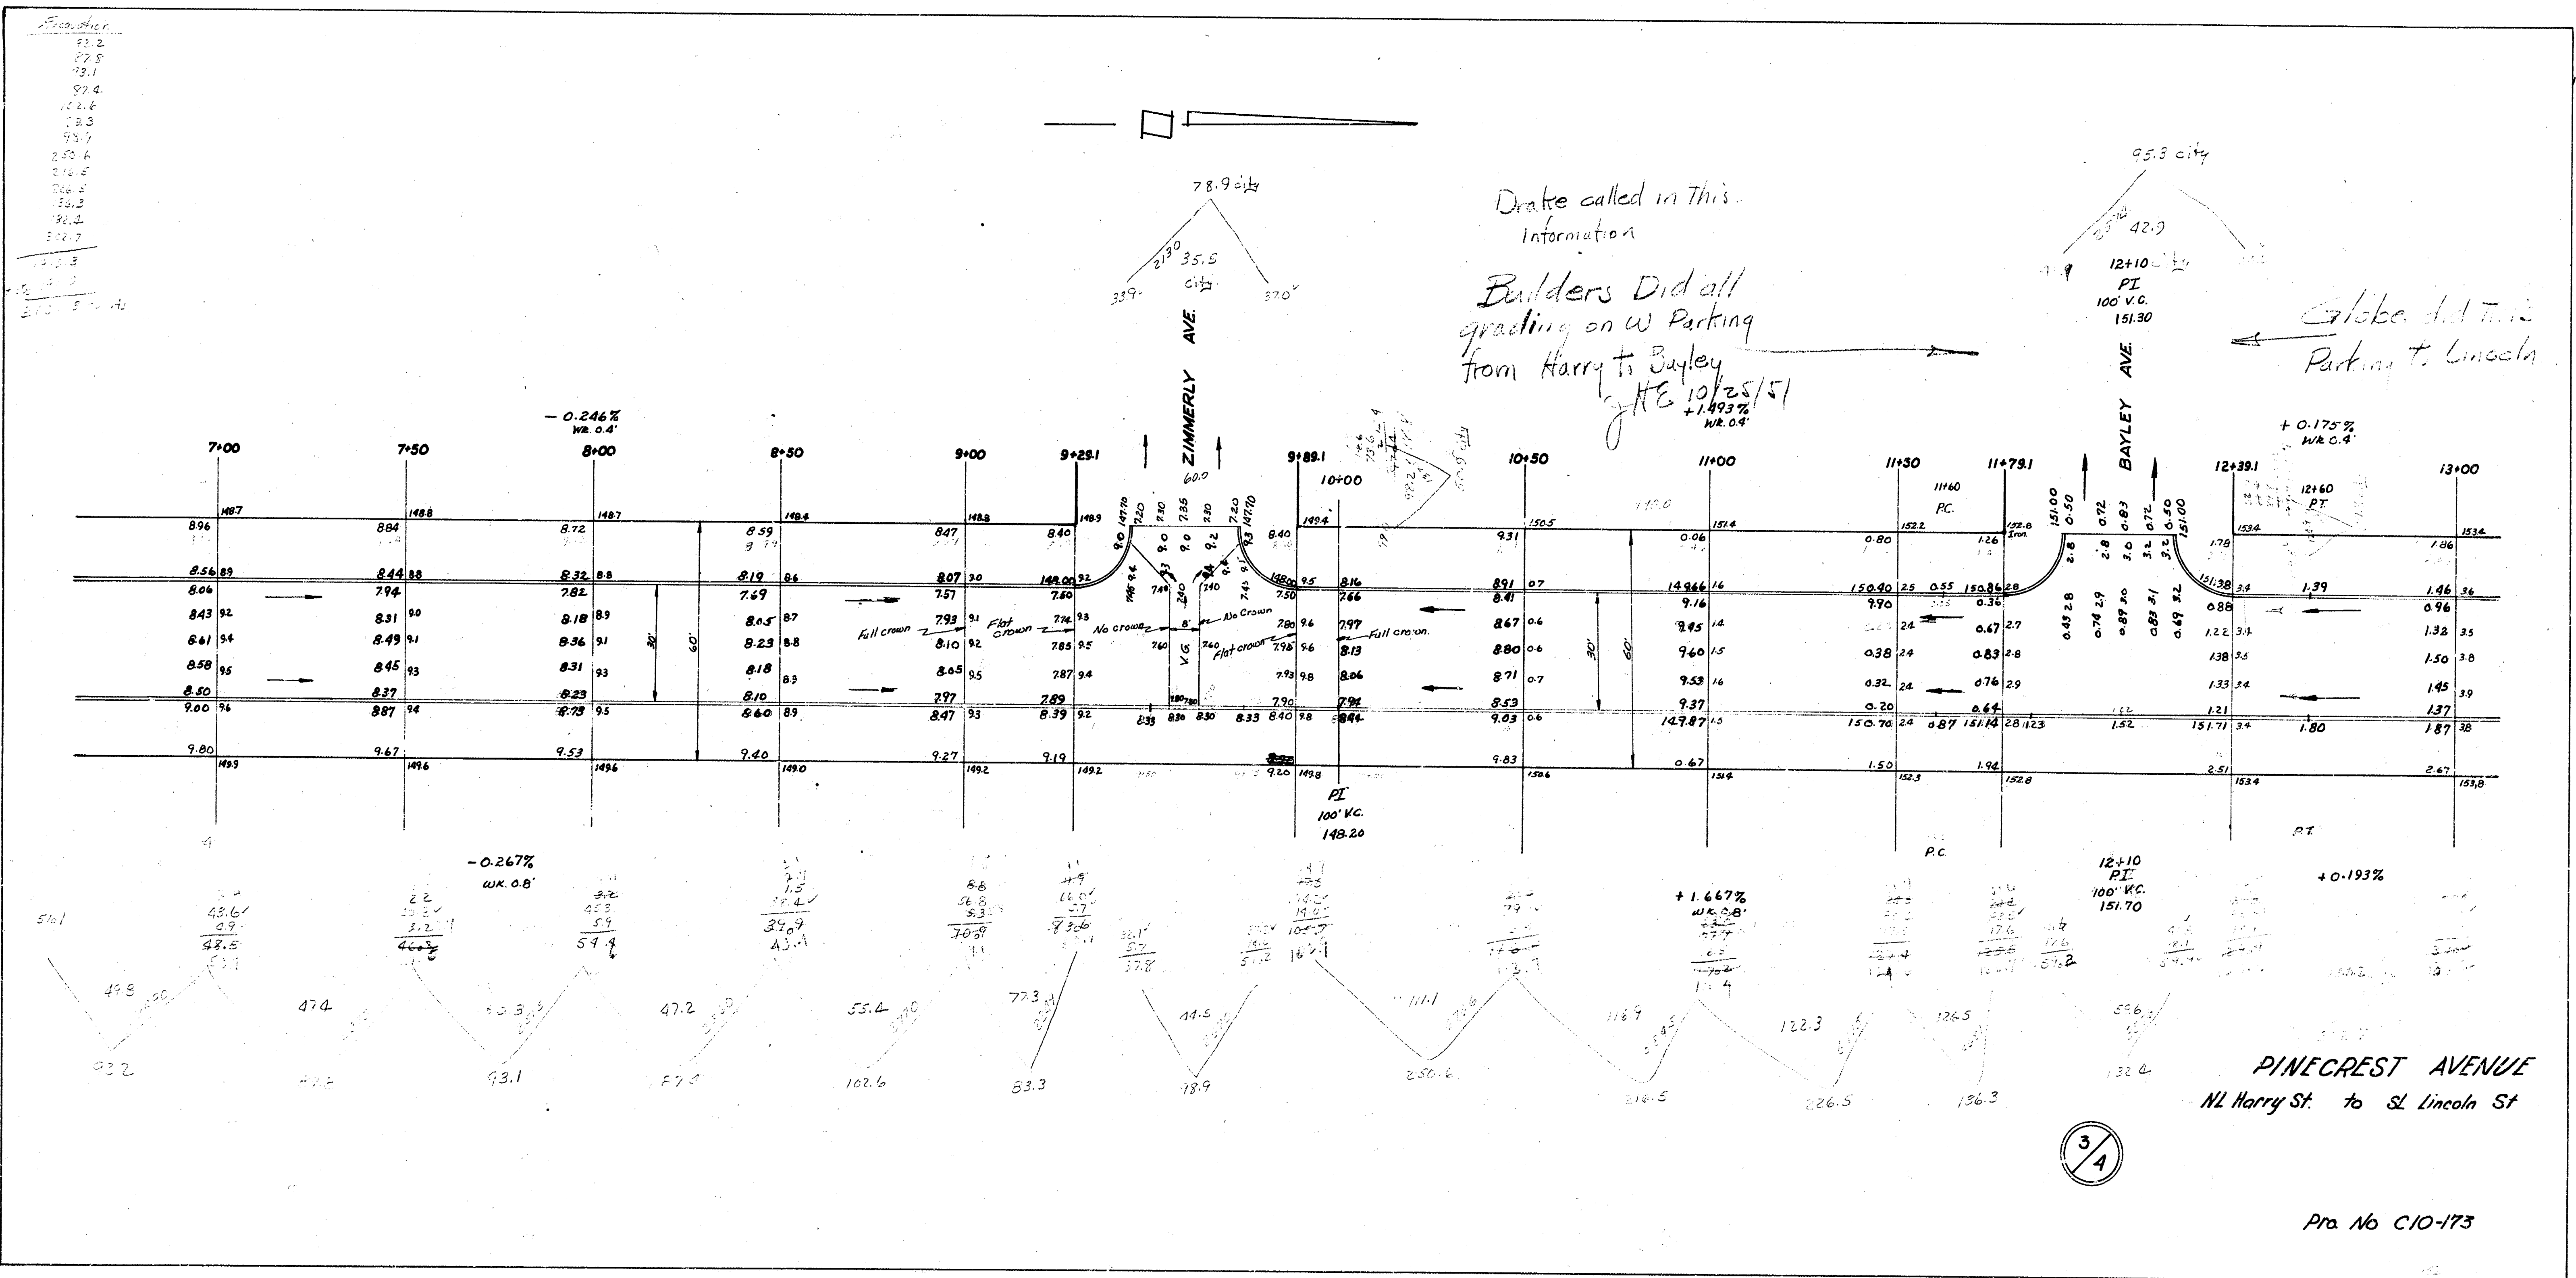

BM. 153.00 SW. corner concrete porch Ho.st 858 Deavola @ NE. corner Lincoln & Deavola.

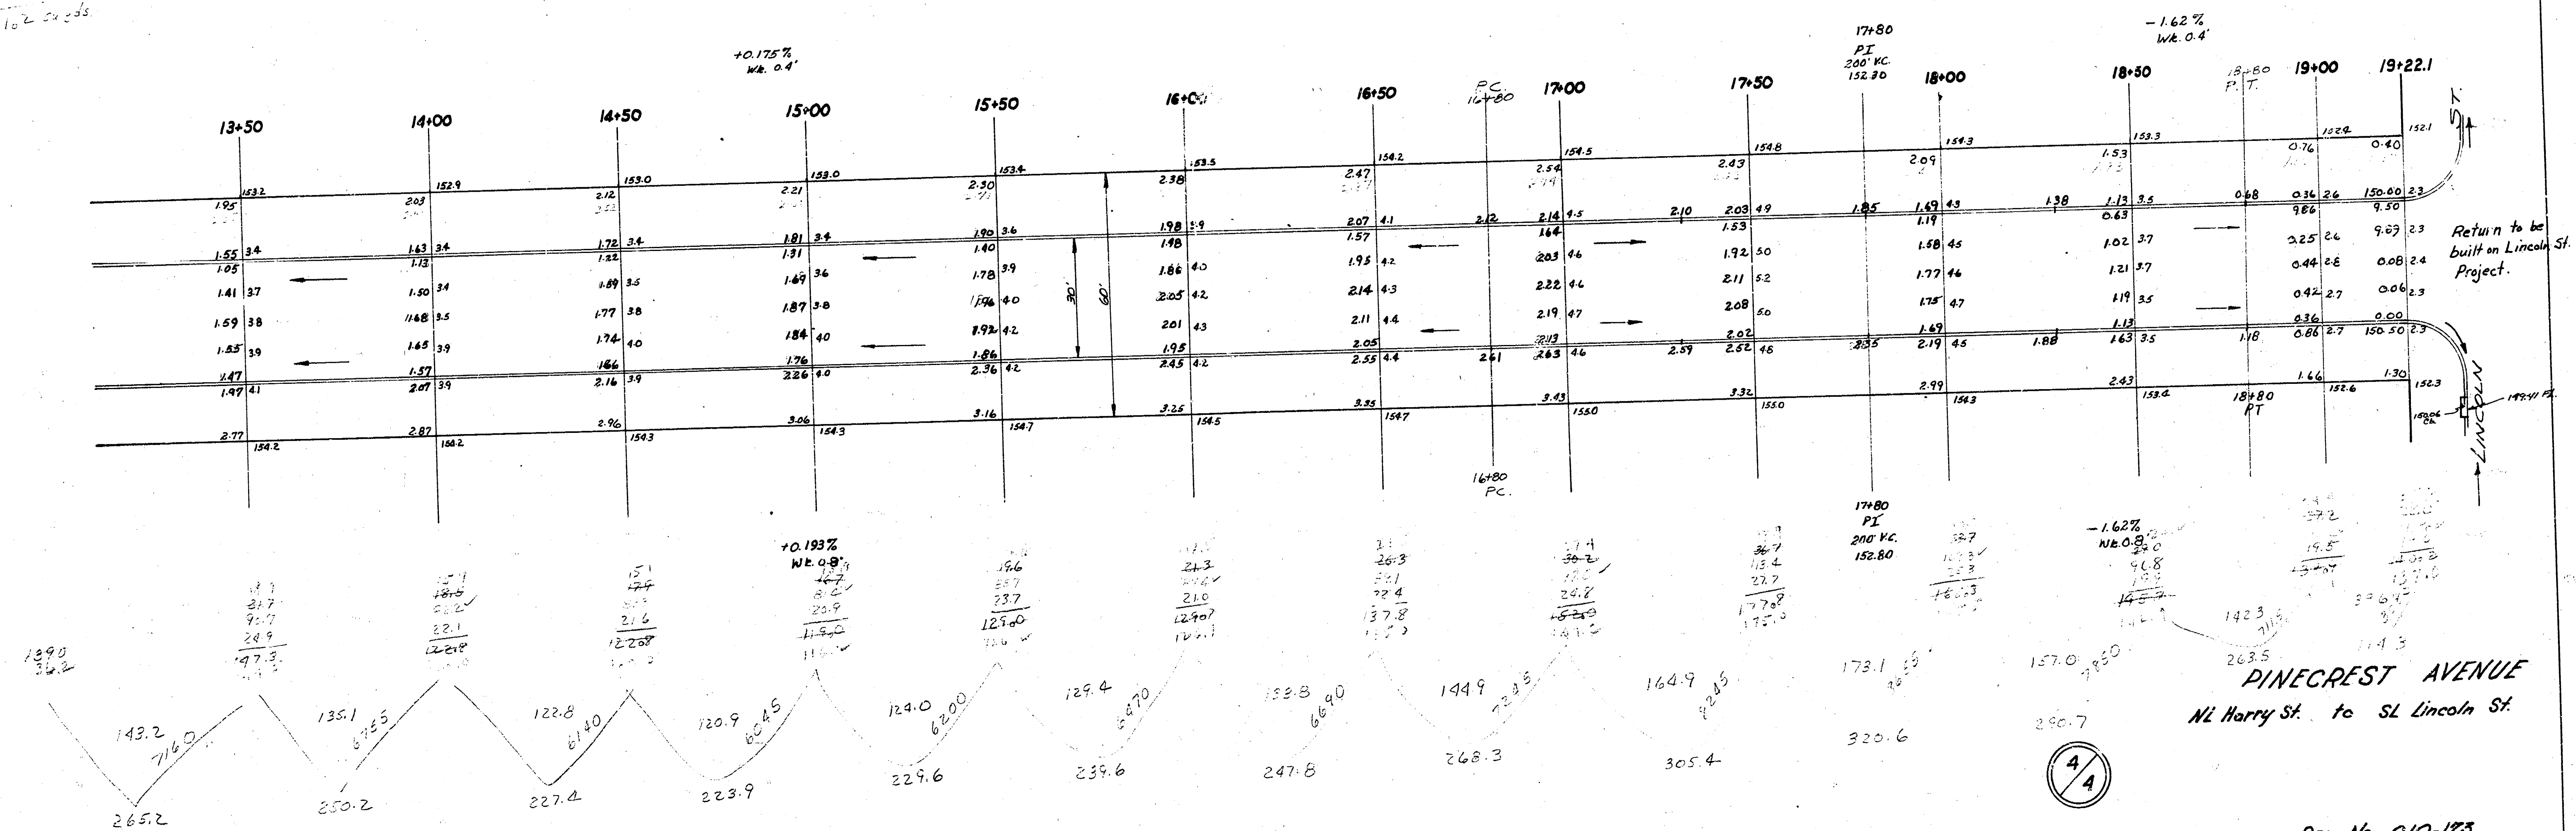


Pro. No C/D-173

Page 10

43.7
34.1
76.3
67.2
70.7
74.3
73.1
76.5
69.1
62.9
50.5
32.1


554.3
41090

914.1 C4 yds
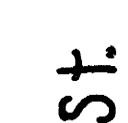
$$\begin{array}{r} 55.4 \\ 15.5 \\ 30.4 \\ \hline 48.9 \\ 2.090 \\ \hline 55.4 \end{array}$$


0400

Harry

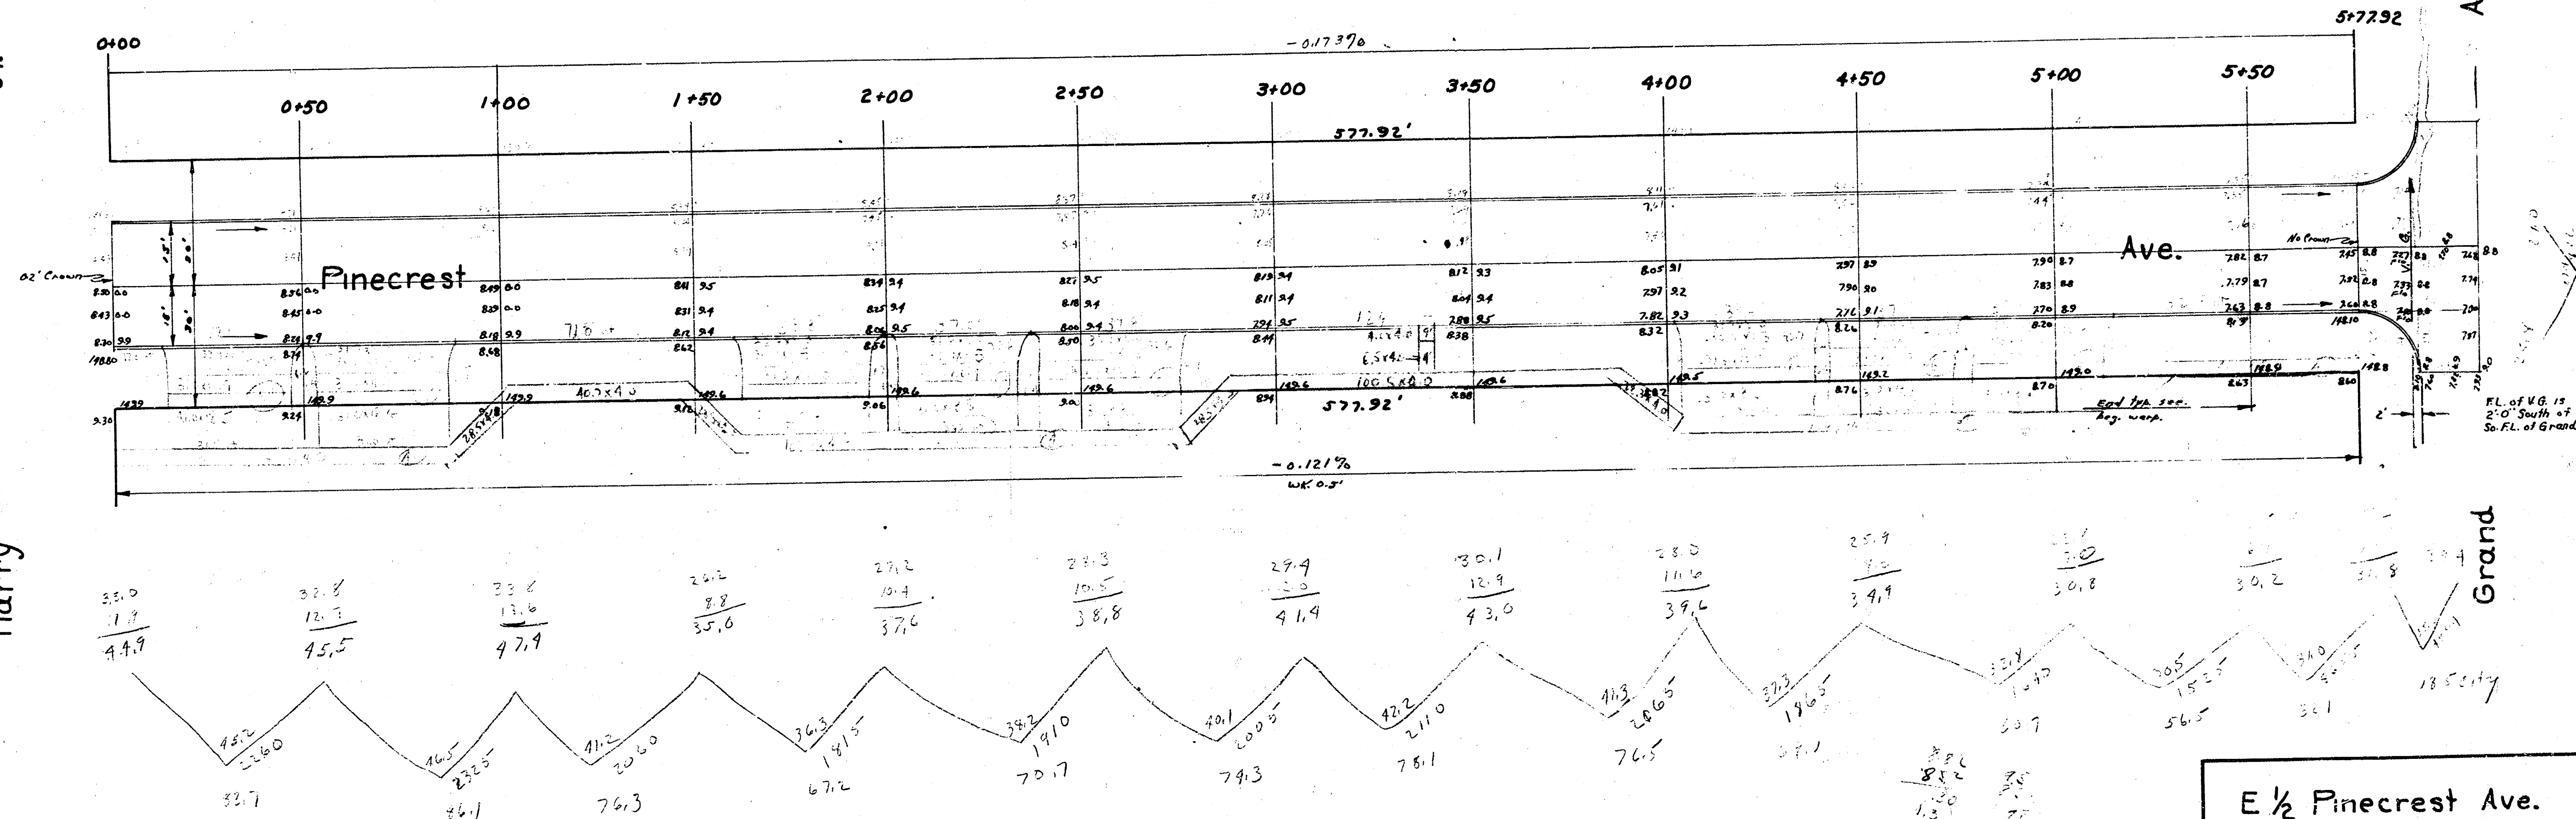

Grand

E 1/2 Pinecrest Ave.
N. L. Harry to E. Grand
15' Conc. & Cb.
City of Wichita, Kansas
L. K. White ~ City Engineer
April 1950 Private Job.