


PAVING PLAN 1937


Pinecrest -

N.L. Second St. to Third St.
26'-2'-30" Curb & Gutter.

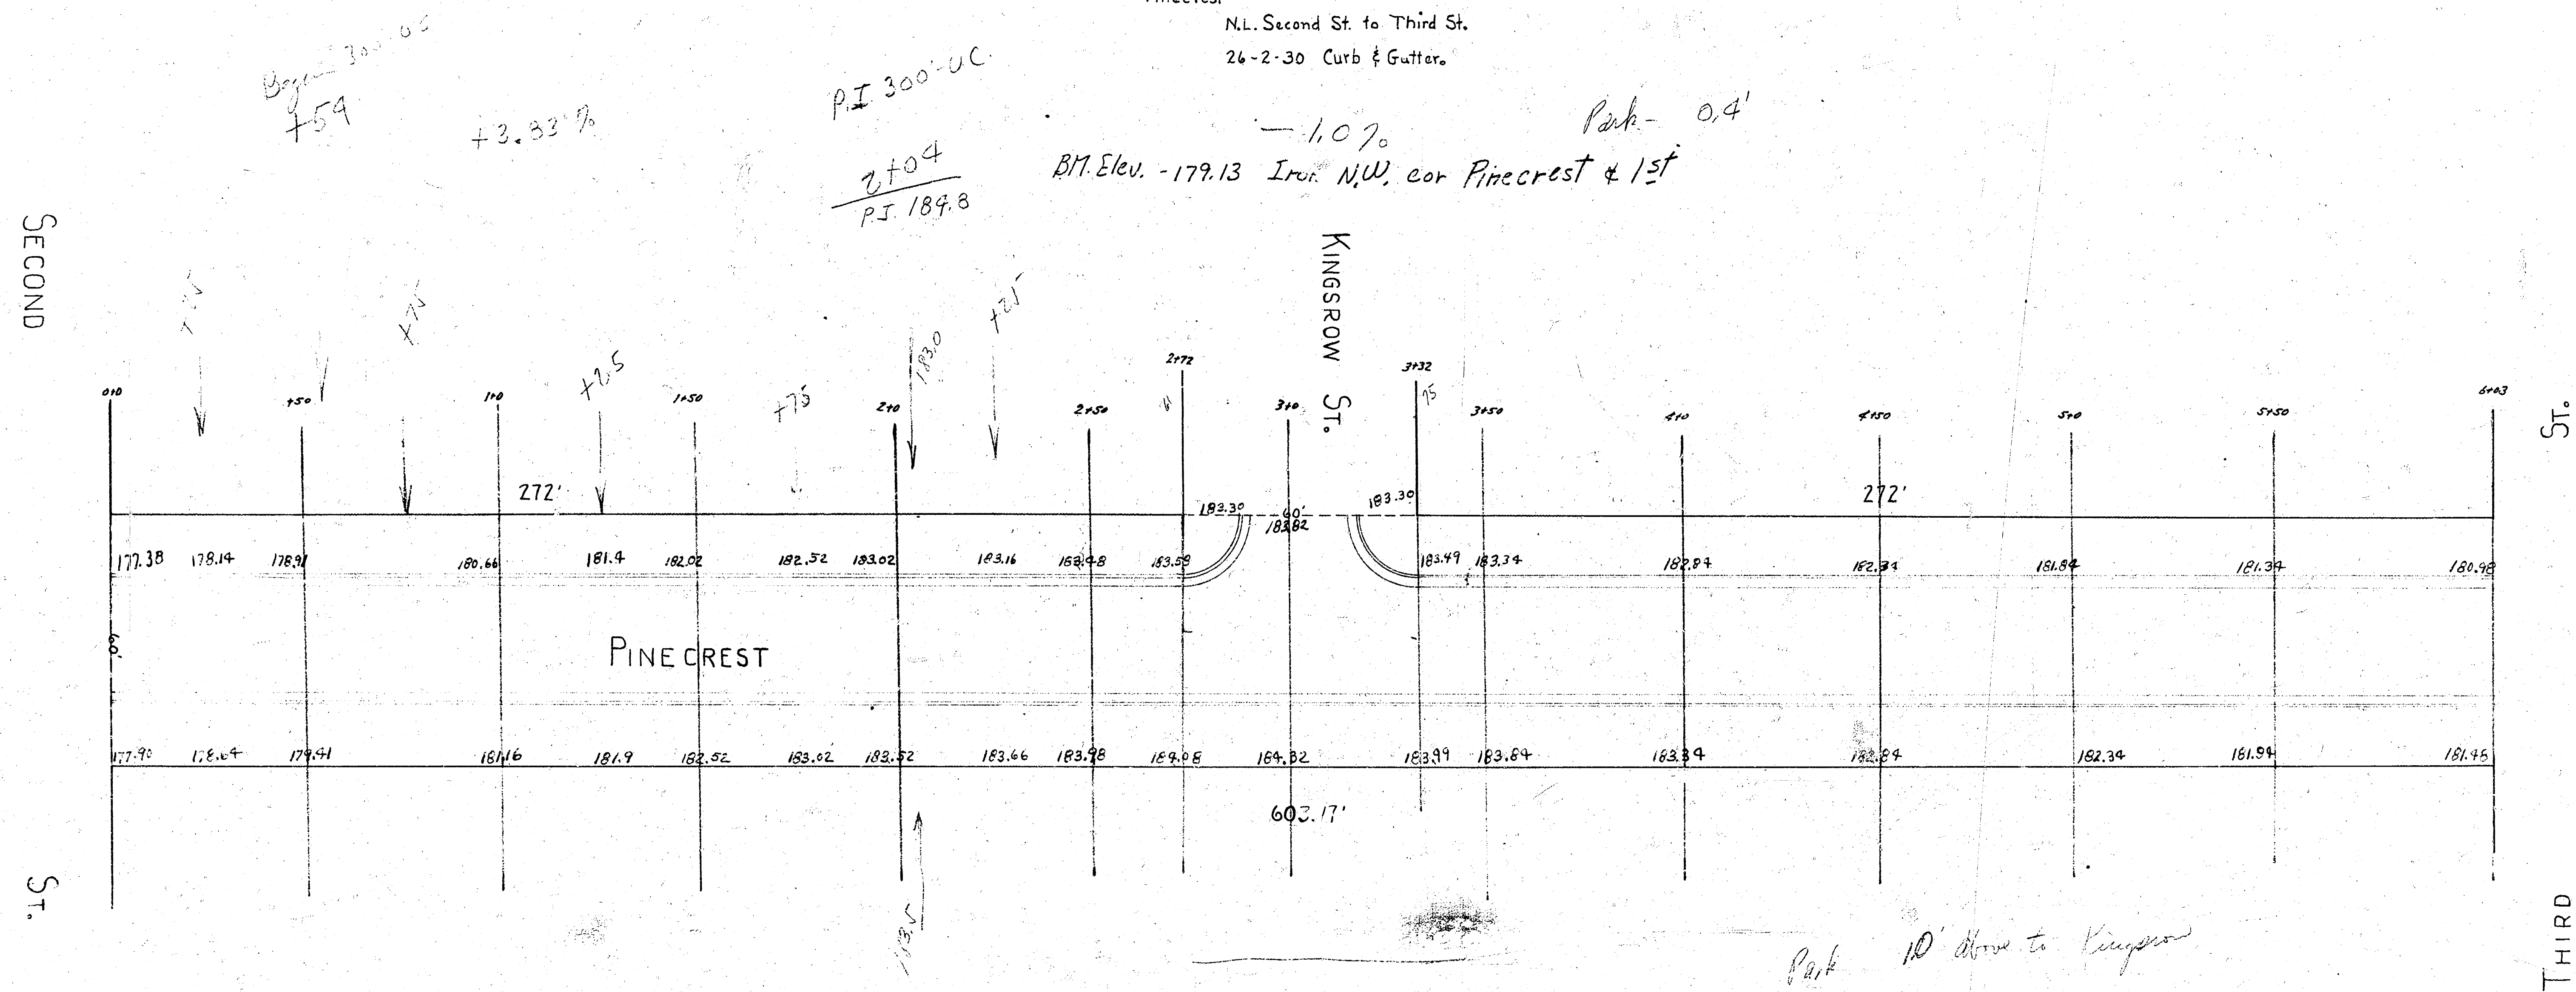

PAVING PLAN PINECREST N.L. 2ND + S.L. 3RD 26' Concrete.

BM Elev. 181.14 5' 9" in 6" dia. Manhole, 9 S.L. 3RD

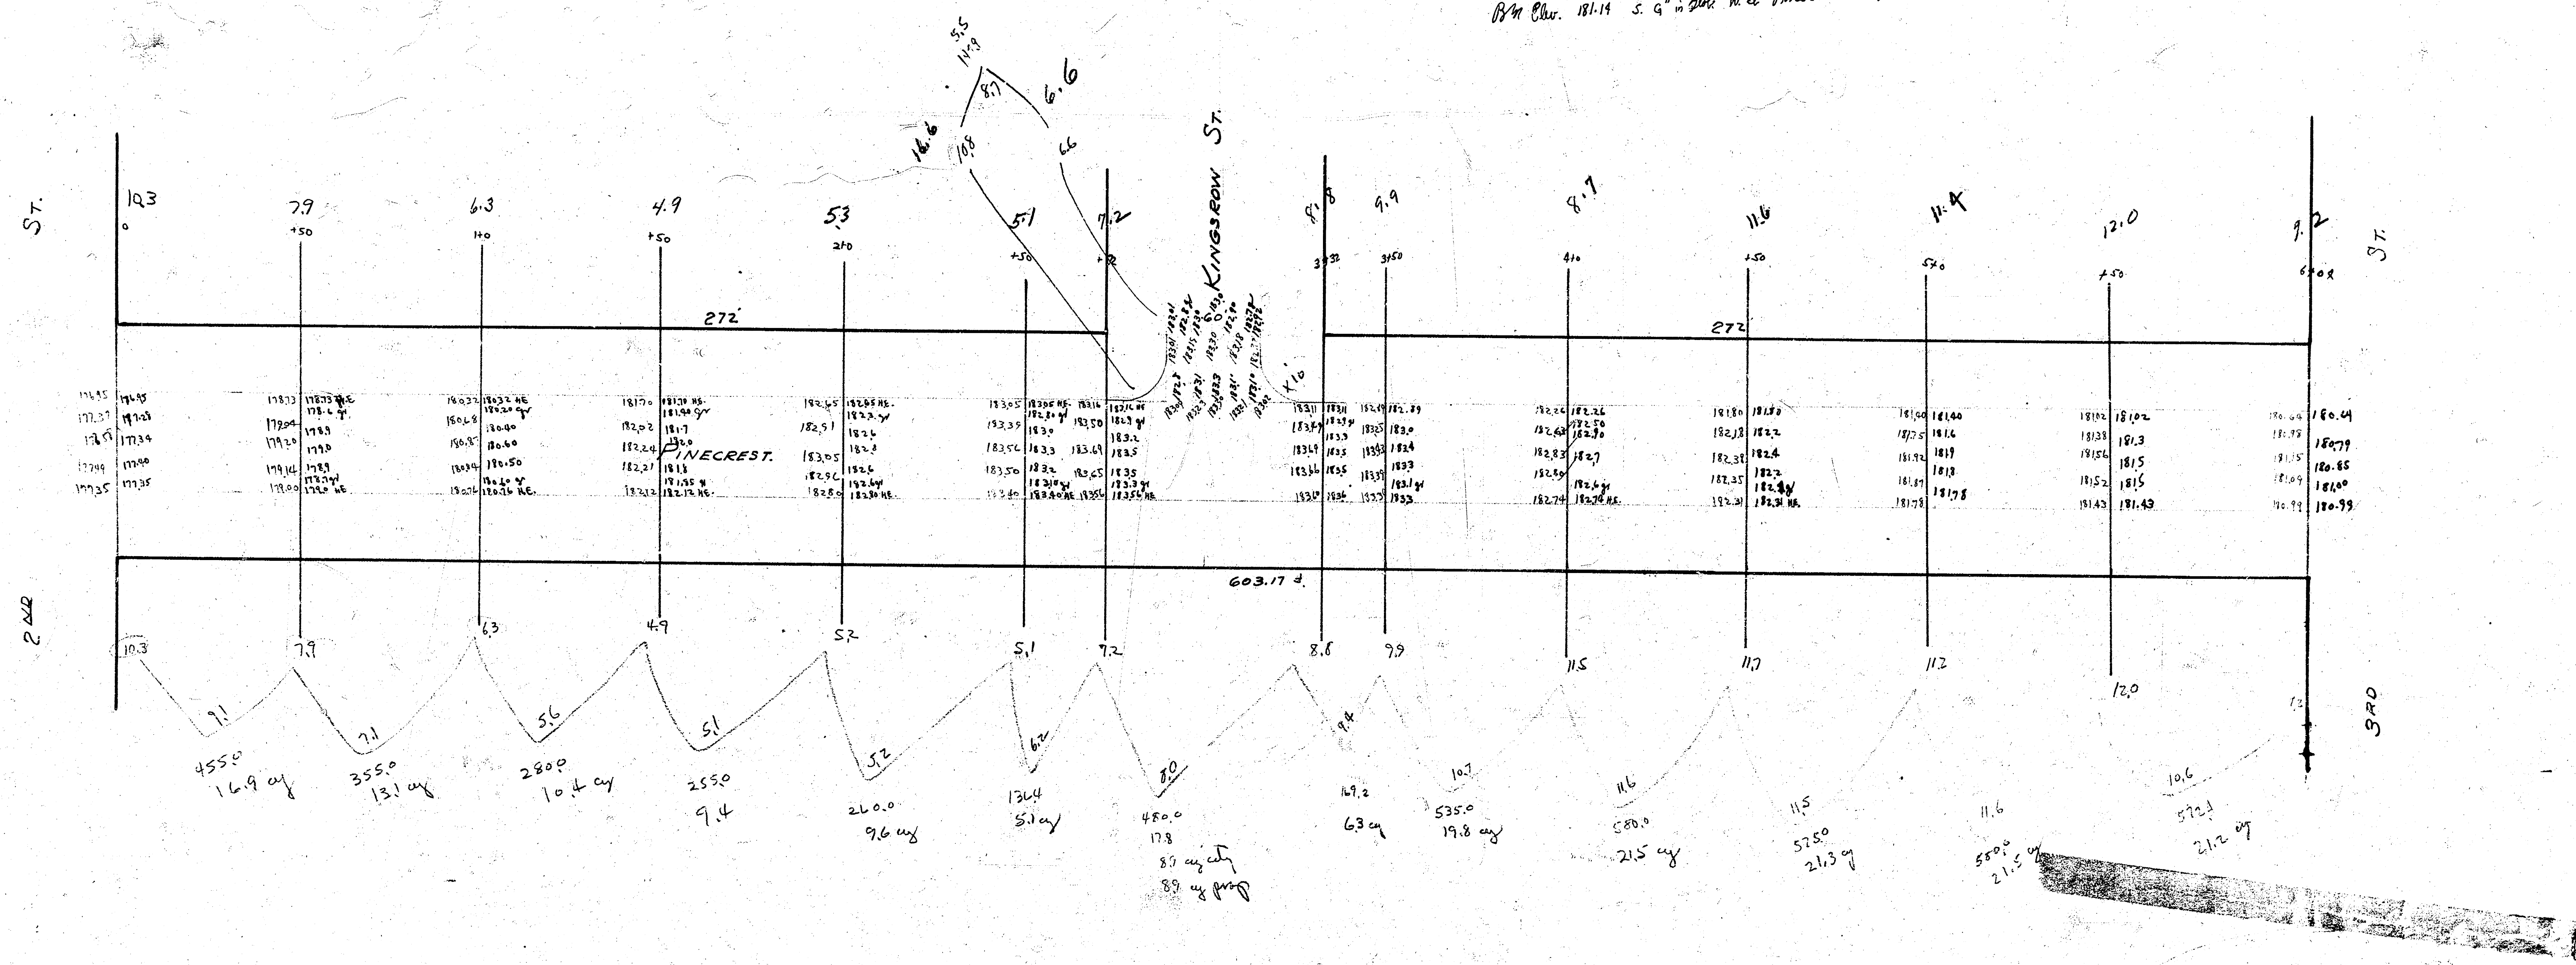

PAVING PLAN
PINECREST
N.L. 2ND
S.L. 3RD
1891.

By
City
Estimate
1891