
B.M. 154.98 N.W. Cor. Conc. Porch
Ho. # 2615 E. 21st Street.

N

Scale : 1" = 20'

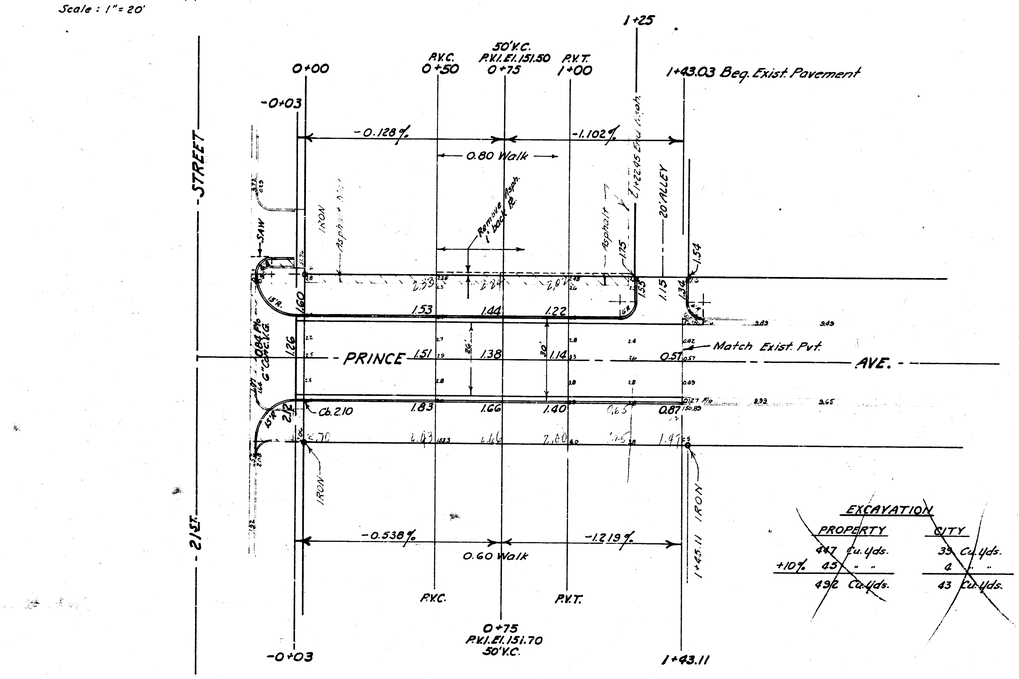

EXCAVATION

	PROPERTY	CITY
	447 Cu. Yds.	39 Cu. Yds.
+10%	45 " "	4 " "
	492 Cu. Yds.	43 Cu. Yds.

PRINCE AVENUE
N.L. 21st STREET to 245.29' S. of S.L. AUDREY STREET.
26-2-30 A.C.
CITY OF WICHITA, KANSAS
B.E. SMITH, CITY ENGINEER
Oct. 1961. PROJECT No. C11-17

B. E. SMITH LICENSED 436 KANSAS PROFESSIONAL ENGINEER

1/2