
B.M. 1038 City Std. 6' N & 8' E of SE cor. 13th & Meridian
B.M. 1198A SE cor. conc. porch 1303 N. Richmond
B.M. 1198B SW cor. conc. porch 6512 N. 11th St.

Survey: King
Plan: Kahn
Enc: Kahn
Checked:

St. DAK 1301

scale 1"=20'

N

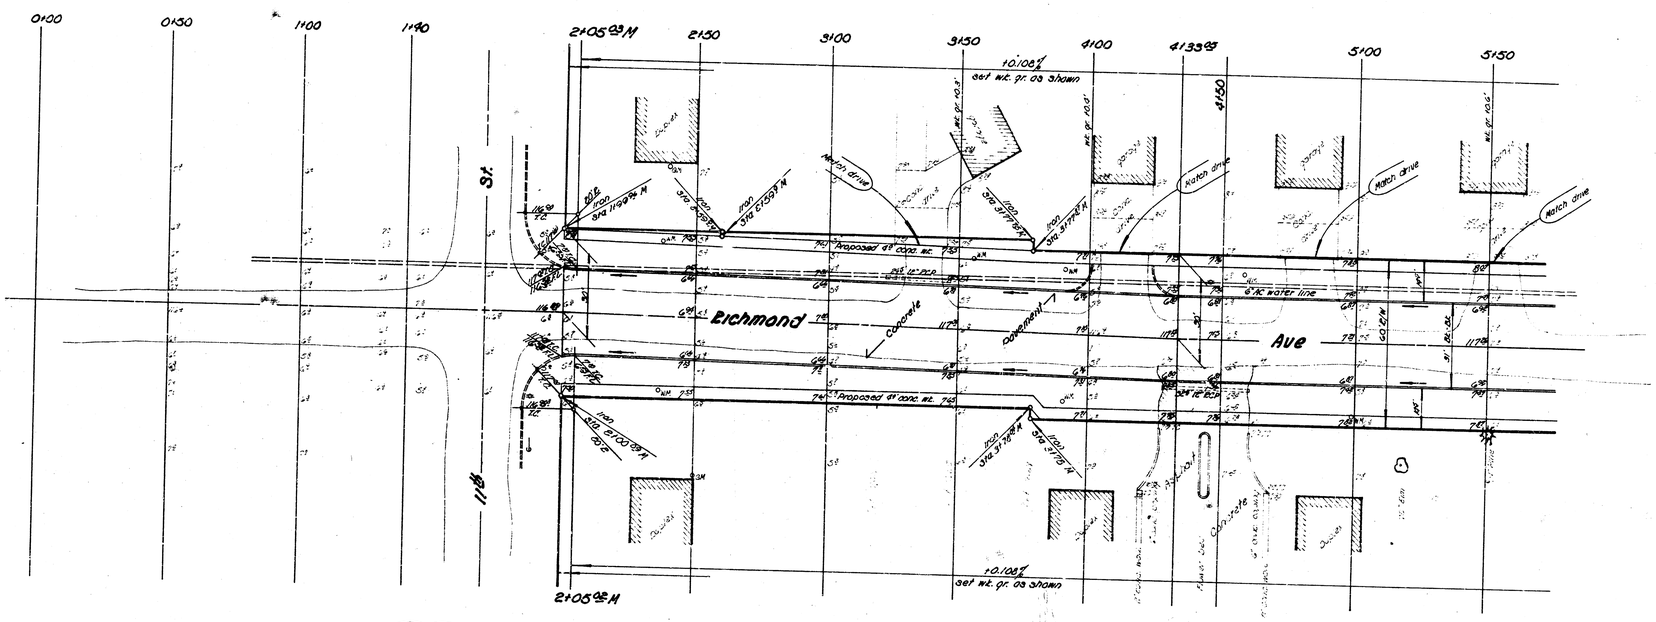


General Notes

1. Contractor to clear Right-of-Way, grade parking and construct compacted fill in sidewalk areas. Sidewalk to be constructed by others.
2. Contractor to grade 11th St. and Richmond Ave. intersection to match new pavement such that water will drain west to Meridian Ave. This work shall be considered incidental to project.

Earthwork


| | | | |
|---|---|---|---|
| Excavation | 463.4 cu yds | Comp. fill | 238.4 cu yds |
| 110% | 46.3 cu yds | 110% | 23.9 cu yds |
| Total | 509.7 cu yds | Total | 262.3 cu yds |

Borrow Excavation
400 cu yds


1/4

6311

Richmond Ave.
NL 11th St. to NL lot 9 Coler Addn.
Concrete 30' B curb
City of Wichita, Kansas
E.W. Linn City Engineer
Project No. DAK3573070
Date: MAY 1974

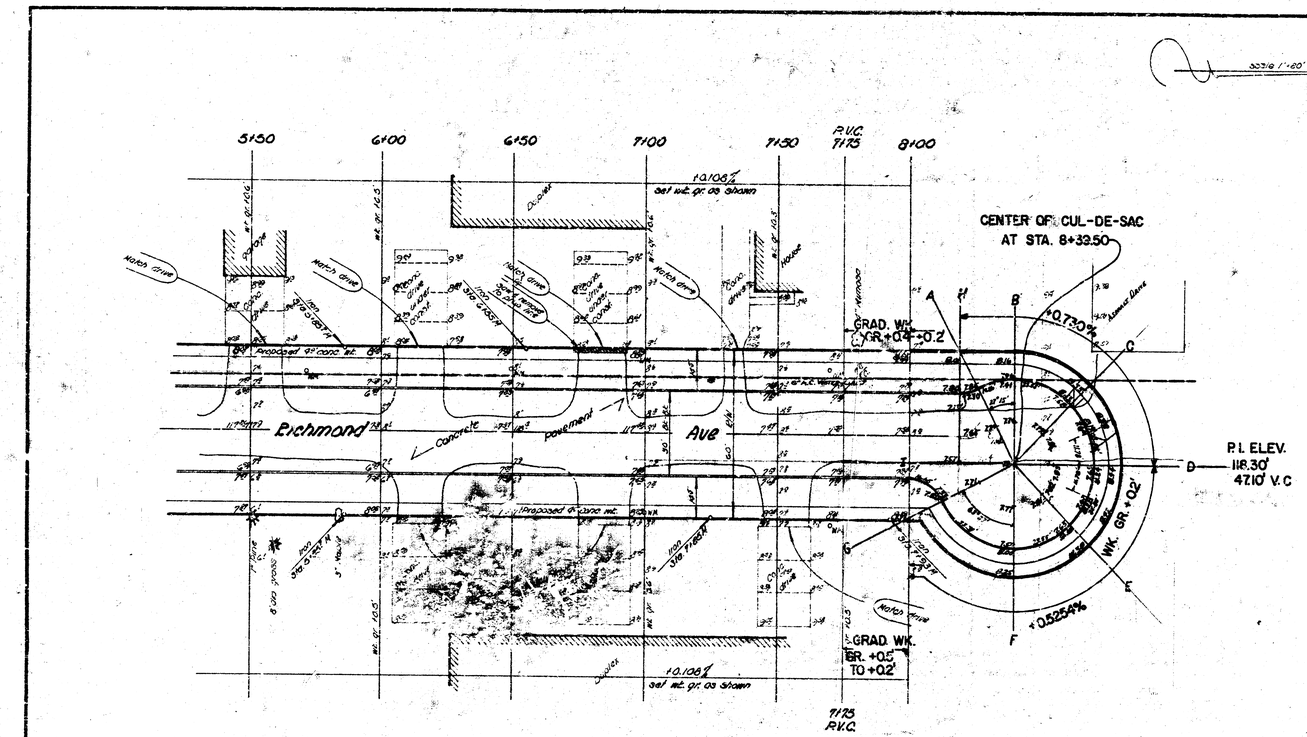


Rev. 8-14-74 RICHMOND AVE. DAKS 5730.70

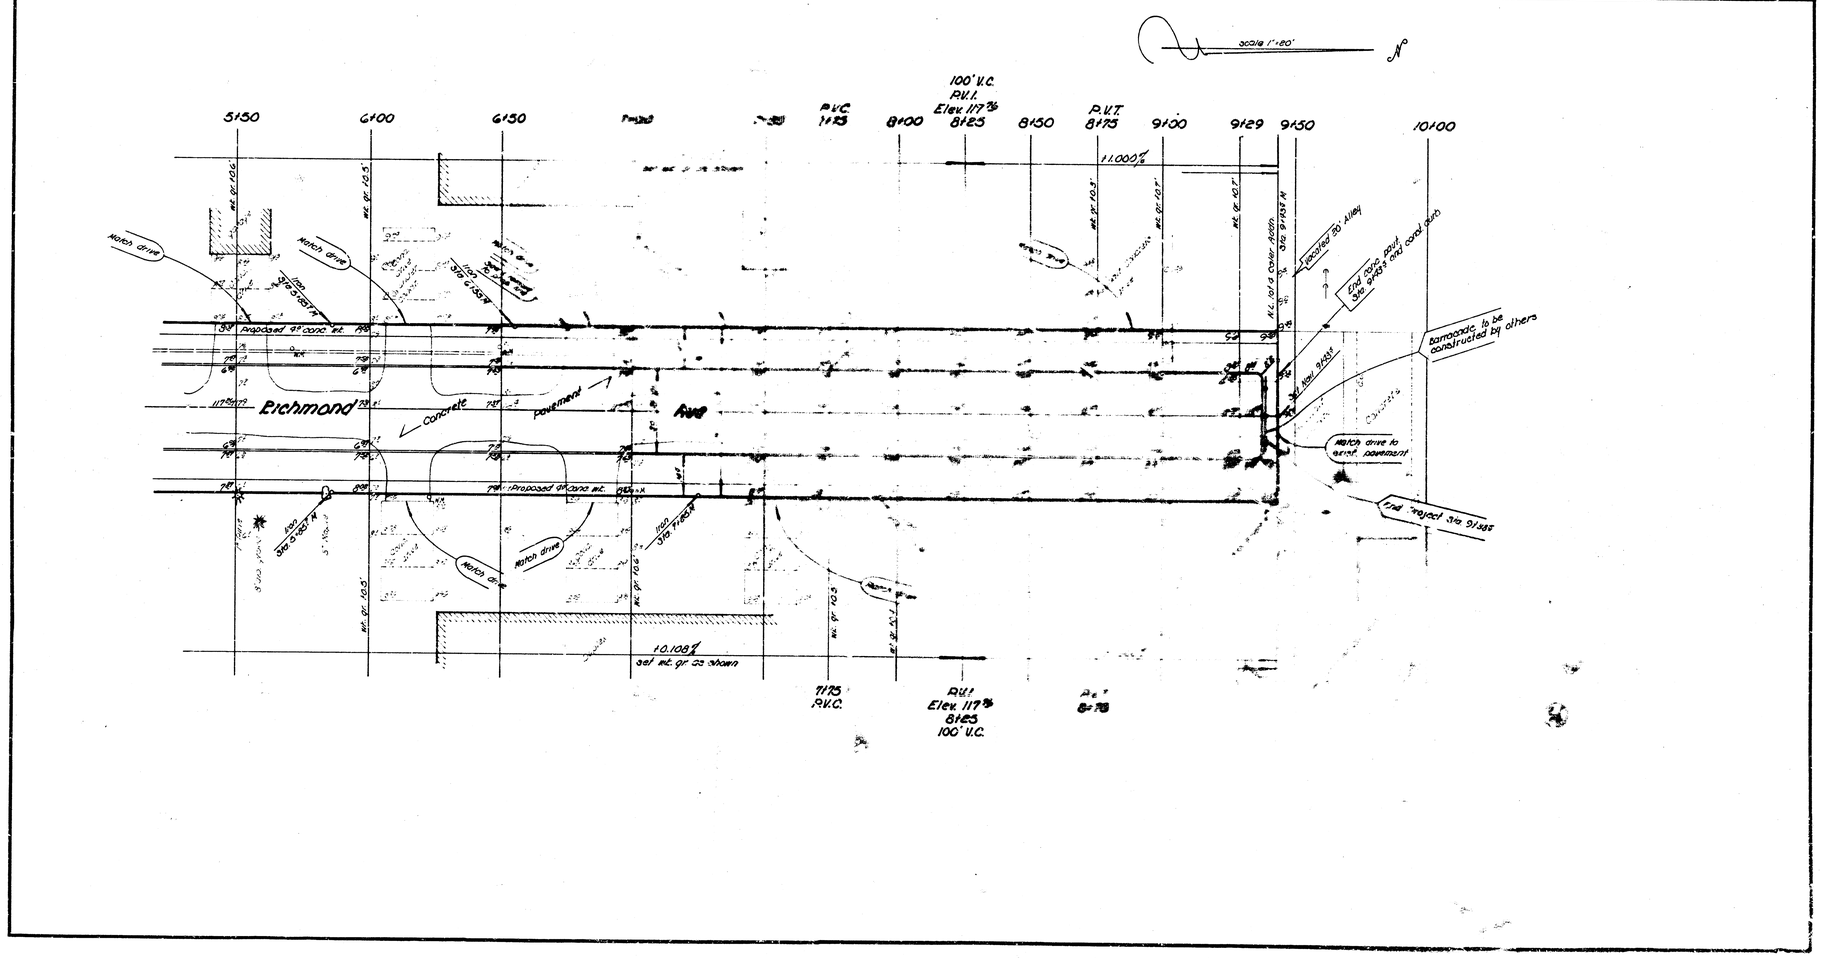
scale 1"=20'
N
5+50
6+00
6+50
P.V.C.
7+75
8+00
100' V.C.
P.V.I.
Elev. 117.36
8+25
8+50
P.V.T.
8+75
9+00
9+29
9+50
10+00
11.000%
Match drive
Richmond
Ave
Concrete
pavement
Proposed 9" conc. st.
End new pave. Sta. 9+43 ± old conc. curb
Barricade to be constructed by others
Match drive to exist. pavement
End "Project" Sta. 9+55
10.108%
set wt. gr. as shown
7+75
P.V.C.
P.V.I.
Elev. 117.36
8+25
100' V.C.
P.V.T.
8+75