



B.M. 127.05 2" in E. Richey, U. Co. Wilson, E.L. Richmond
 B.M. 128.55 2" in Richey, E. Co. Richmond, N.L. 28th
 B.M. 129.79 N.E. Cor. Park #2603 S.W. Cor. Richmond & Columbine
 B.M. 126.25 #60 Spike E.S. PP. N.S. Richmond & N.L. Benjamin Hills 2nd Addn.
 B.M. 129.72 Step Bench PP. S. Meridian & E.S. 24th St.
 B.M. 129.63 #60 Spike E.S. PP. N.S. Richmond 115th S. of Manhattan
 Stationing on E.R.

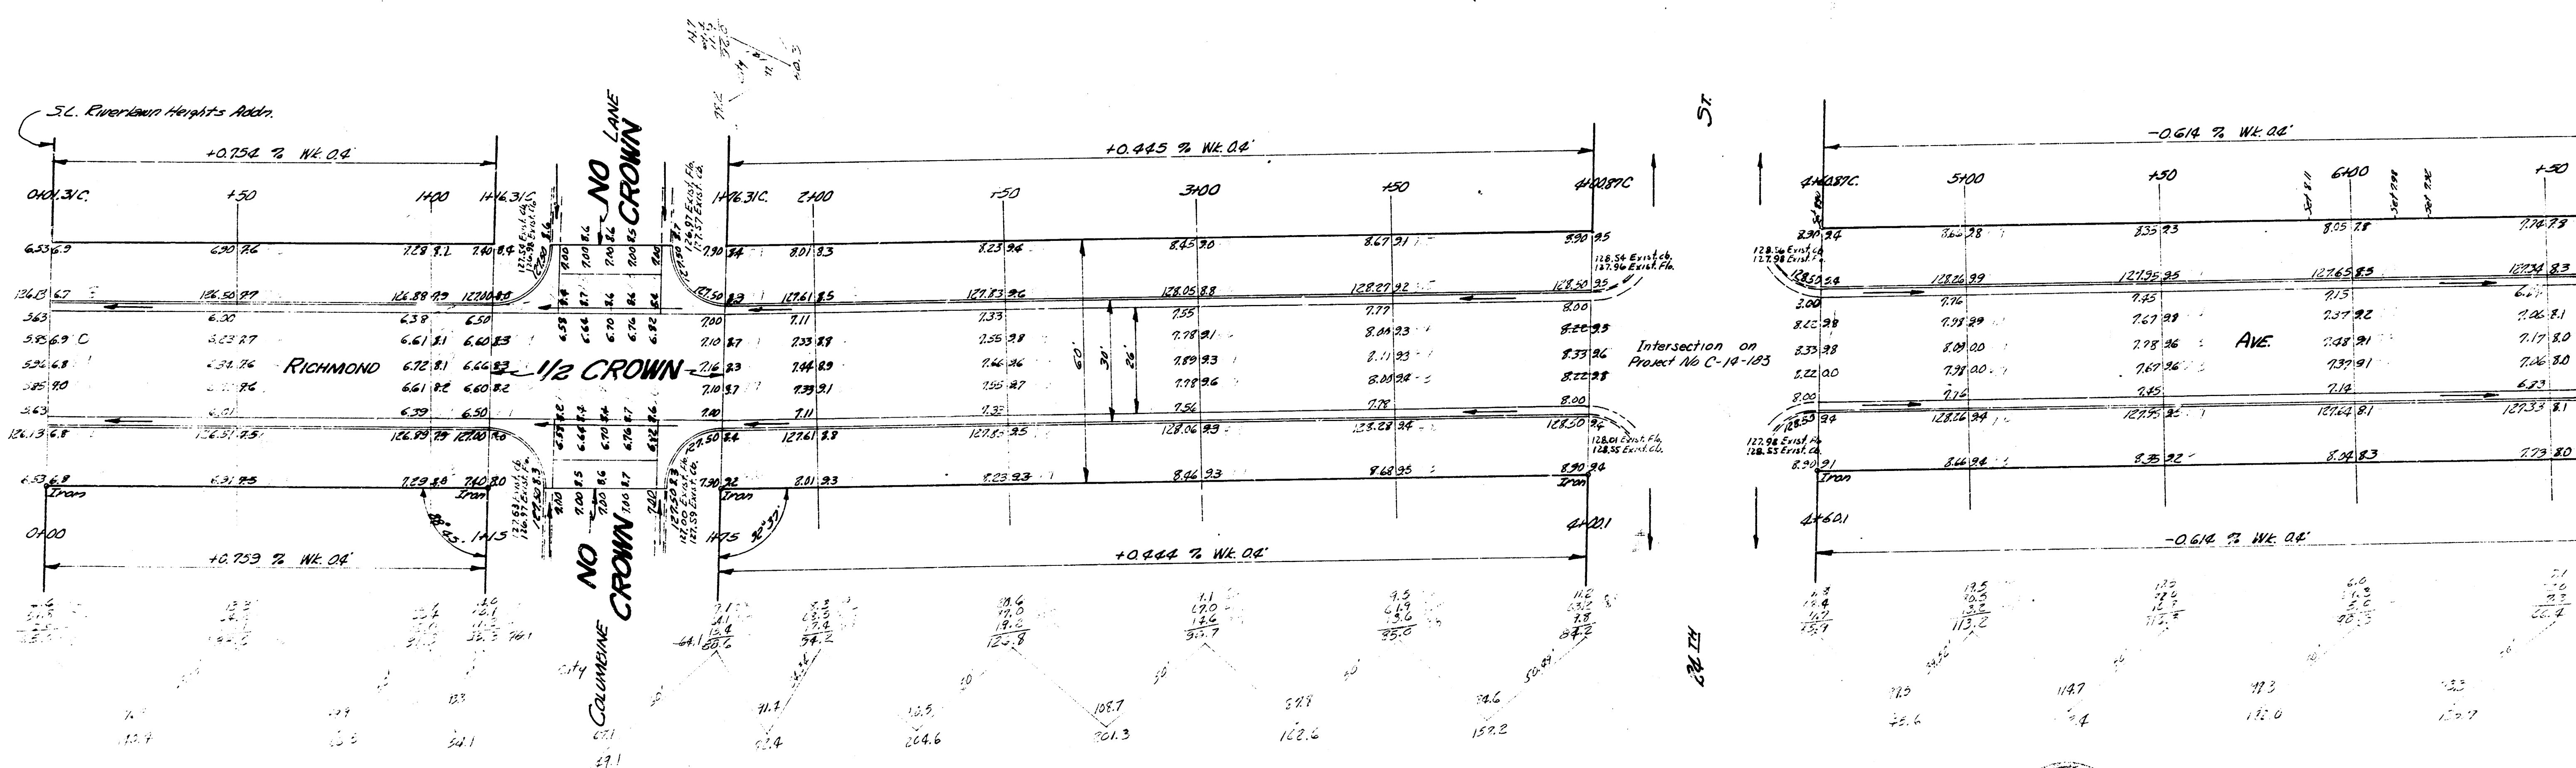

1/2

RICHMOND
 SL RIVERLAWN HEIGHTS ADDN TO SL 25th
 26-2-30 A.C.
 CITY OF WICHITA KANSAS
 B. E. SMITH CITY ENGINEER
 Aug. 1936 Per. No. CM-181

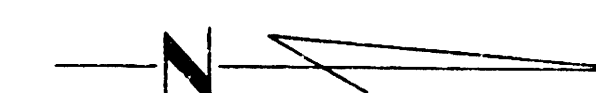