

Ck K-10

Total Property 220.0 / 42.0

City - 0

Priority
42.2
42.2
41.9
42.9
51.3
220.5

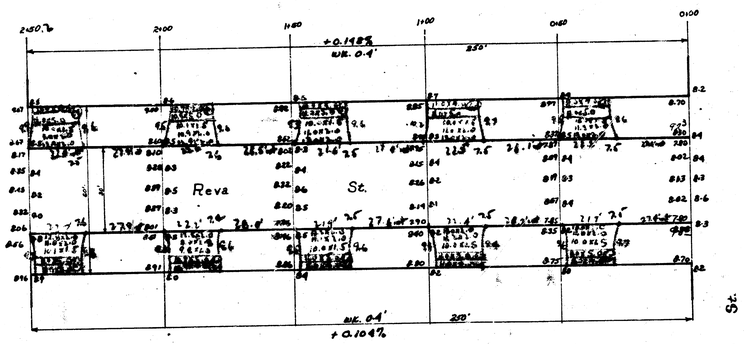

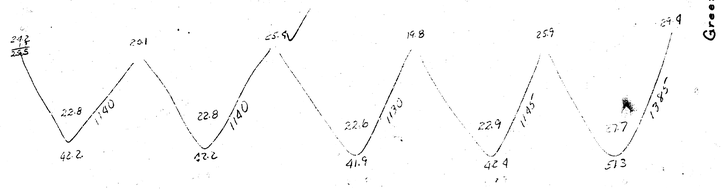

N

REVA ST.
WL GREEN 250' WEST
30' conc. & cb
City of Wichita, Kansas
L.K. White City Engineer
Sept. 1950 Proj. No. C10-90

1 7 4 (50)