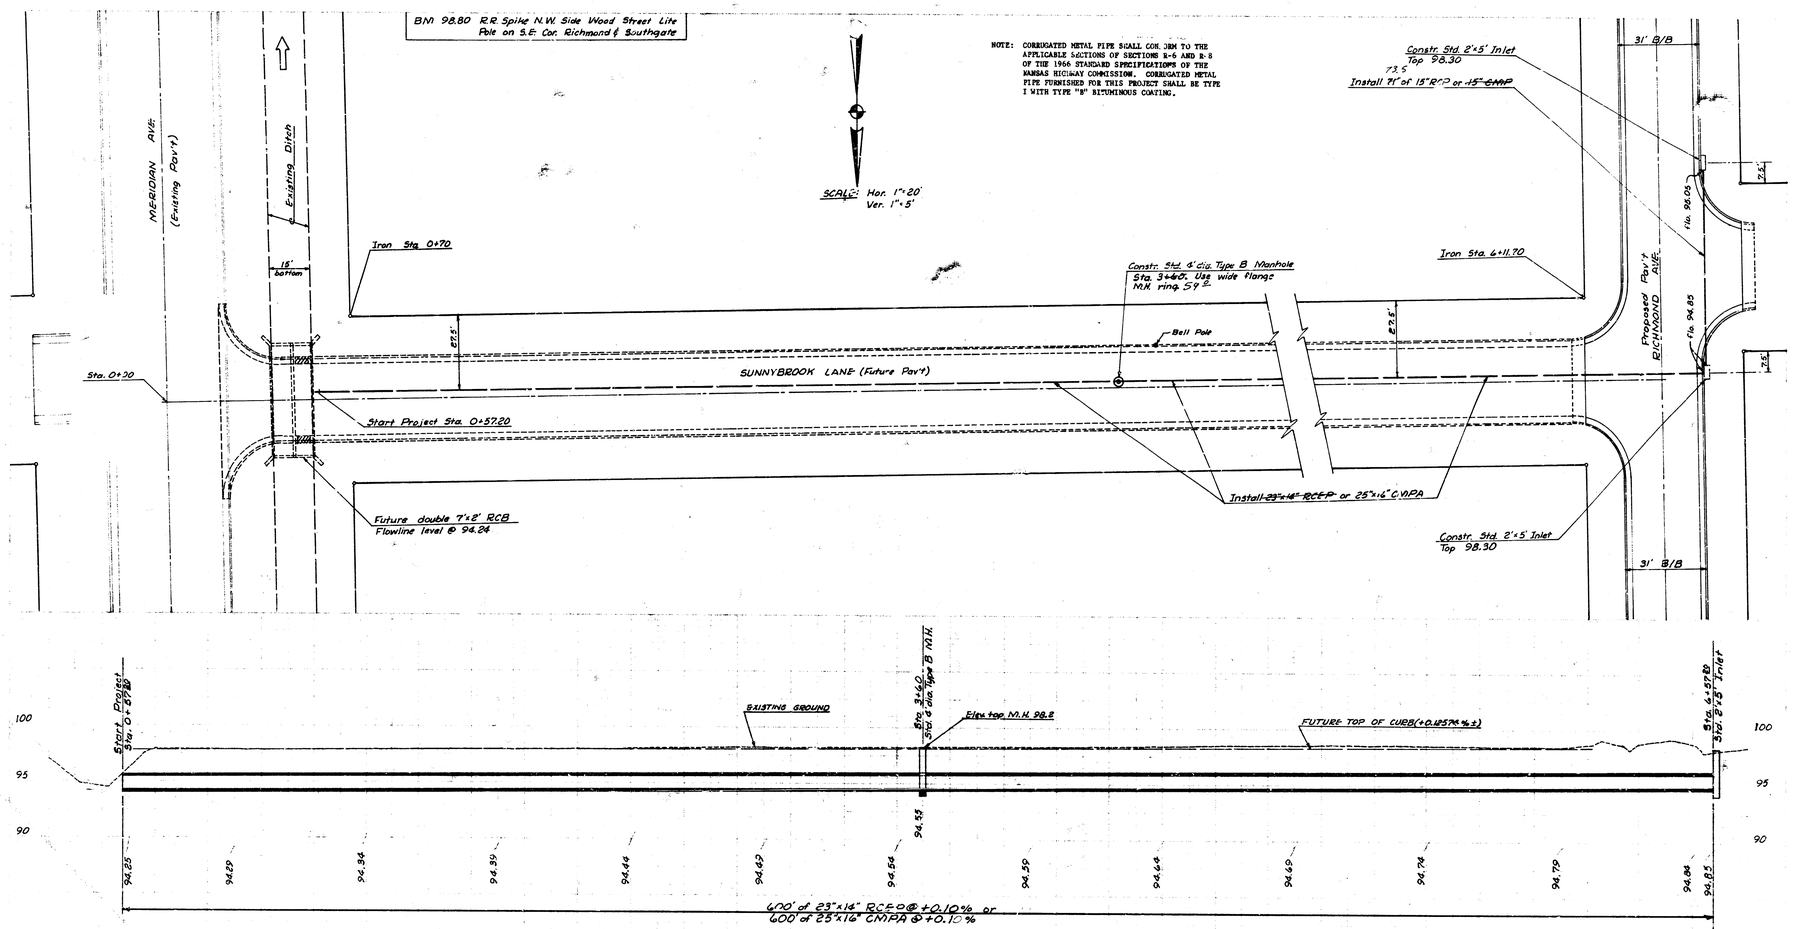

Final Meas.
S.W.S. #2 Atk.

INCIDENTAL
DRAINAGE IN CONNECTION WITH RICHMOND AVE. FROM S.L. SOUTHGATE TO N.L. BLOCK 4, BUILDERS 14th ADDITION.

CITY OF WICHITA, KANSAS

R.W. LINN, CITY ENGINEER

DATE: Dec. 1973

PROJECT NO. DAND 569056

SHEET 1 OF 1

DONALD E. SCHLUETER 6311 KANSAS PROFESSIONAL ENGINEER