


B.M. 131.00 SE. Cor. 1st Conc. Strip No. NE. Cor. 27th Richmond

NOTE TO CONTRACTOR & FIELD ENGR.
 From Sta 2+2 to 3+17.8 West side.
 Construct back of Walk in Drives 30' from
 C of P.B.T. NL Grds. Shown are 30' G

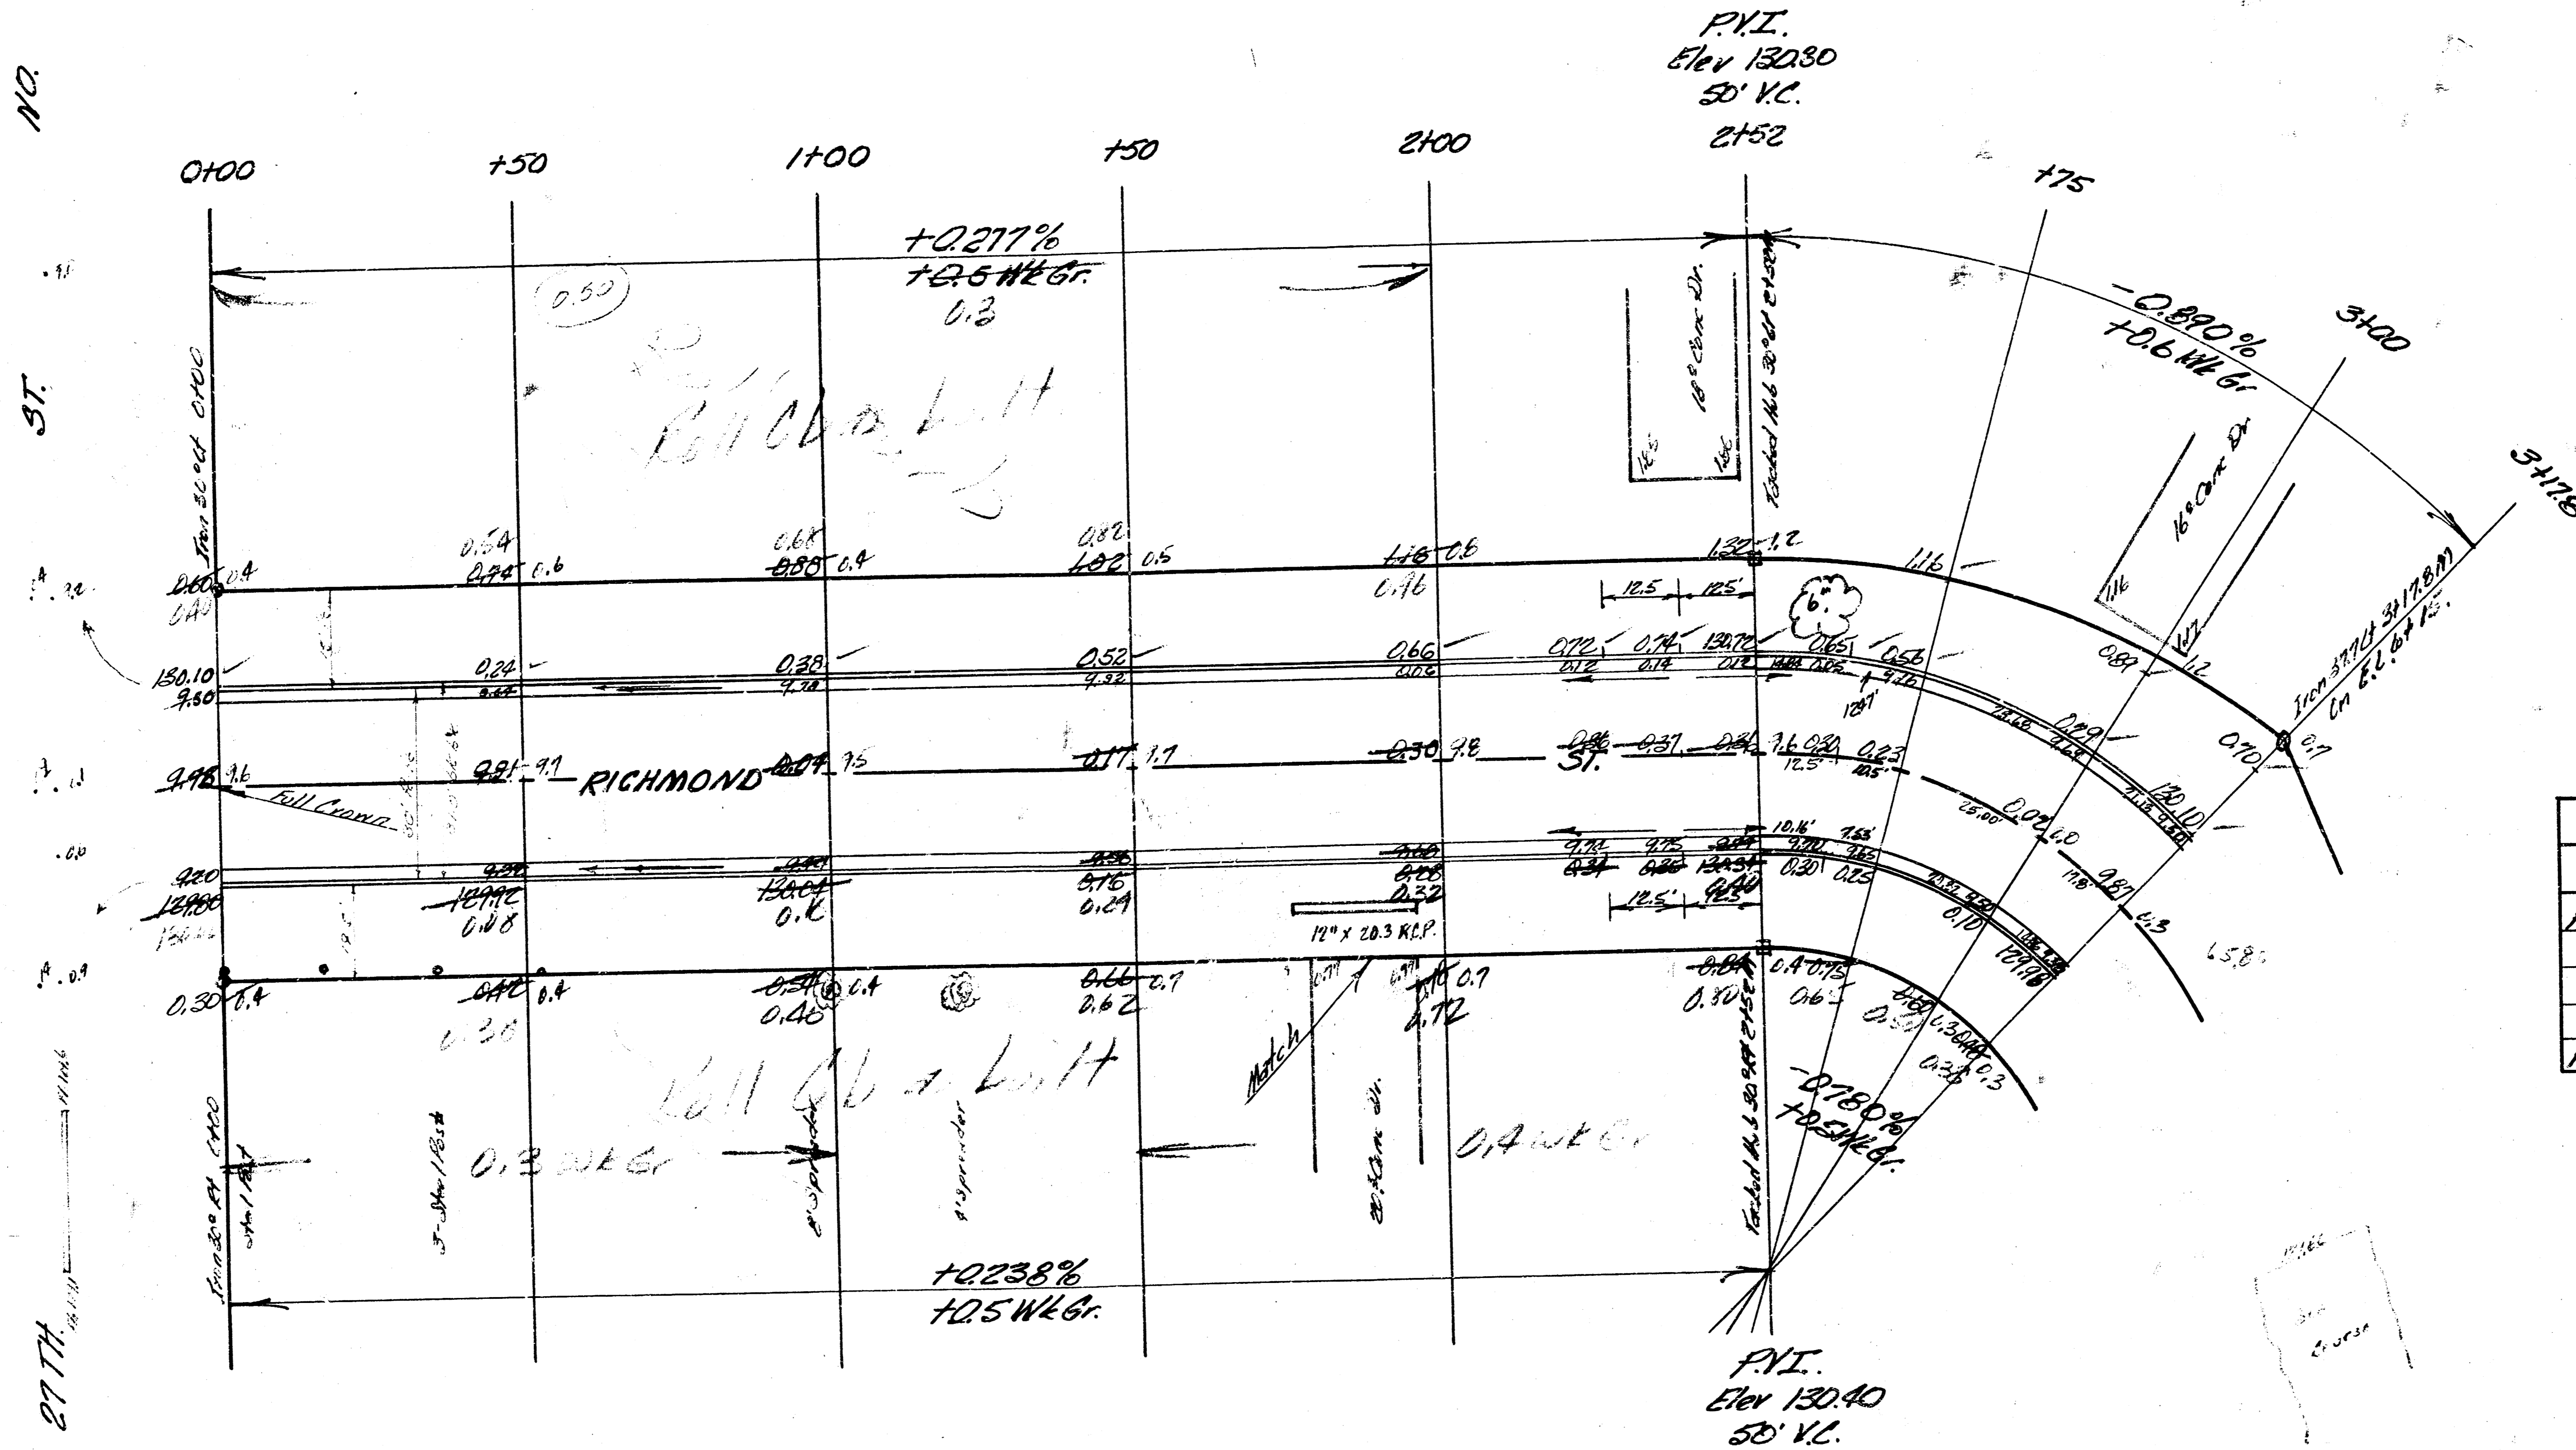


CURVE DATA BASED ON Q.R. 80.06 Δ 67° 44'

Sta	Arc	Chord B' @ Post Cb.	Chord B' @ Inst. Cb.	Deflection	Total Off's
PT. 2+52					
+75	23°	29.51'	16.34'	8° 13' 48"	8° 13' 48"
3+00	25°	32.05'	17.74'	8° 56' 44"	17° 10' 32"
3+17.8	17.2	22.87'	12.66'	6° 22' 10"	23° 30' 42"
PT. 3+14.64	28.22	36.93'	20.45'	10° 19' 18"	33° 52' 20"

2146981 mil. ft.

Baseline = 30' W of E.P.

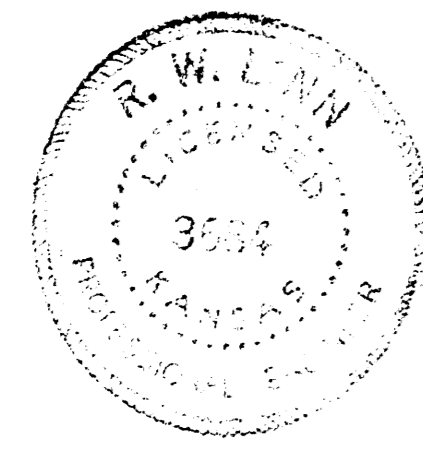

Excavation Prop	Comp Fill Prop.
304.0 CY	2.6 CY
30.4 +10%	2.8 +10%
334.4 CY Total	2.9 CY Total

RICHMOND ST.
 NL. 27th St. No. To
 E.L. Lot 15 Bldg 3, Valley Park Add.
 26'-2"-30' AC.
 CITY OF WICHITA, KANSAS
 B. SMITH CITY ENGINEER
 DATE: JUNE 1966 PROD. C15-7

1/2