


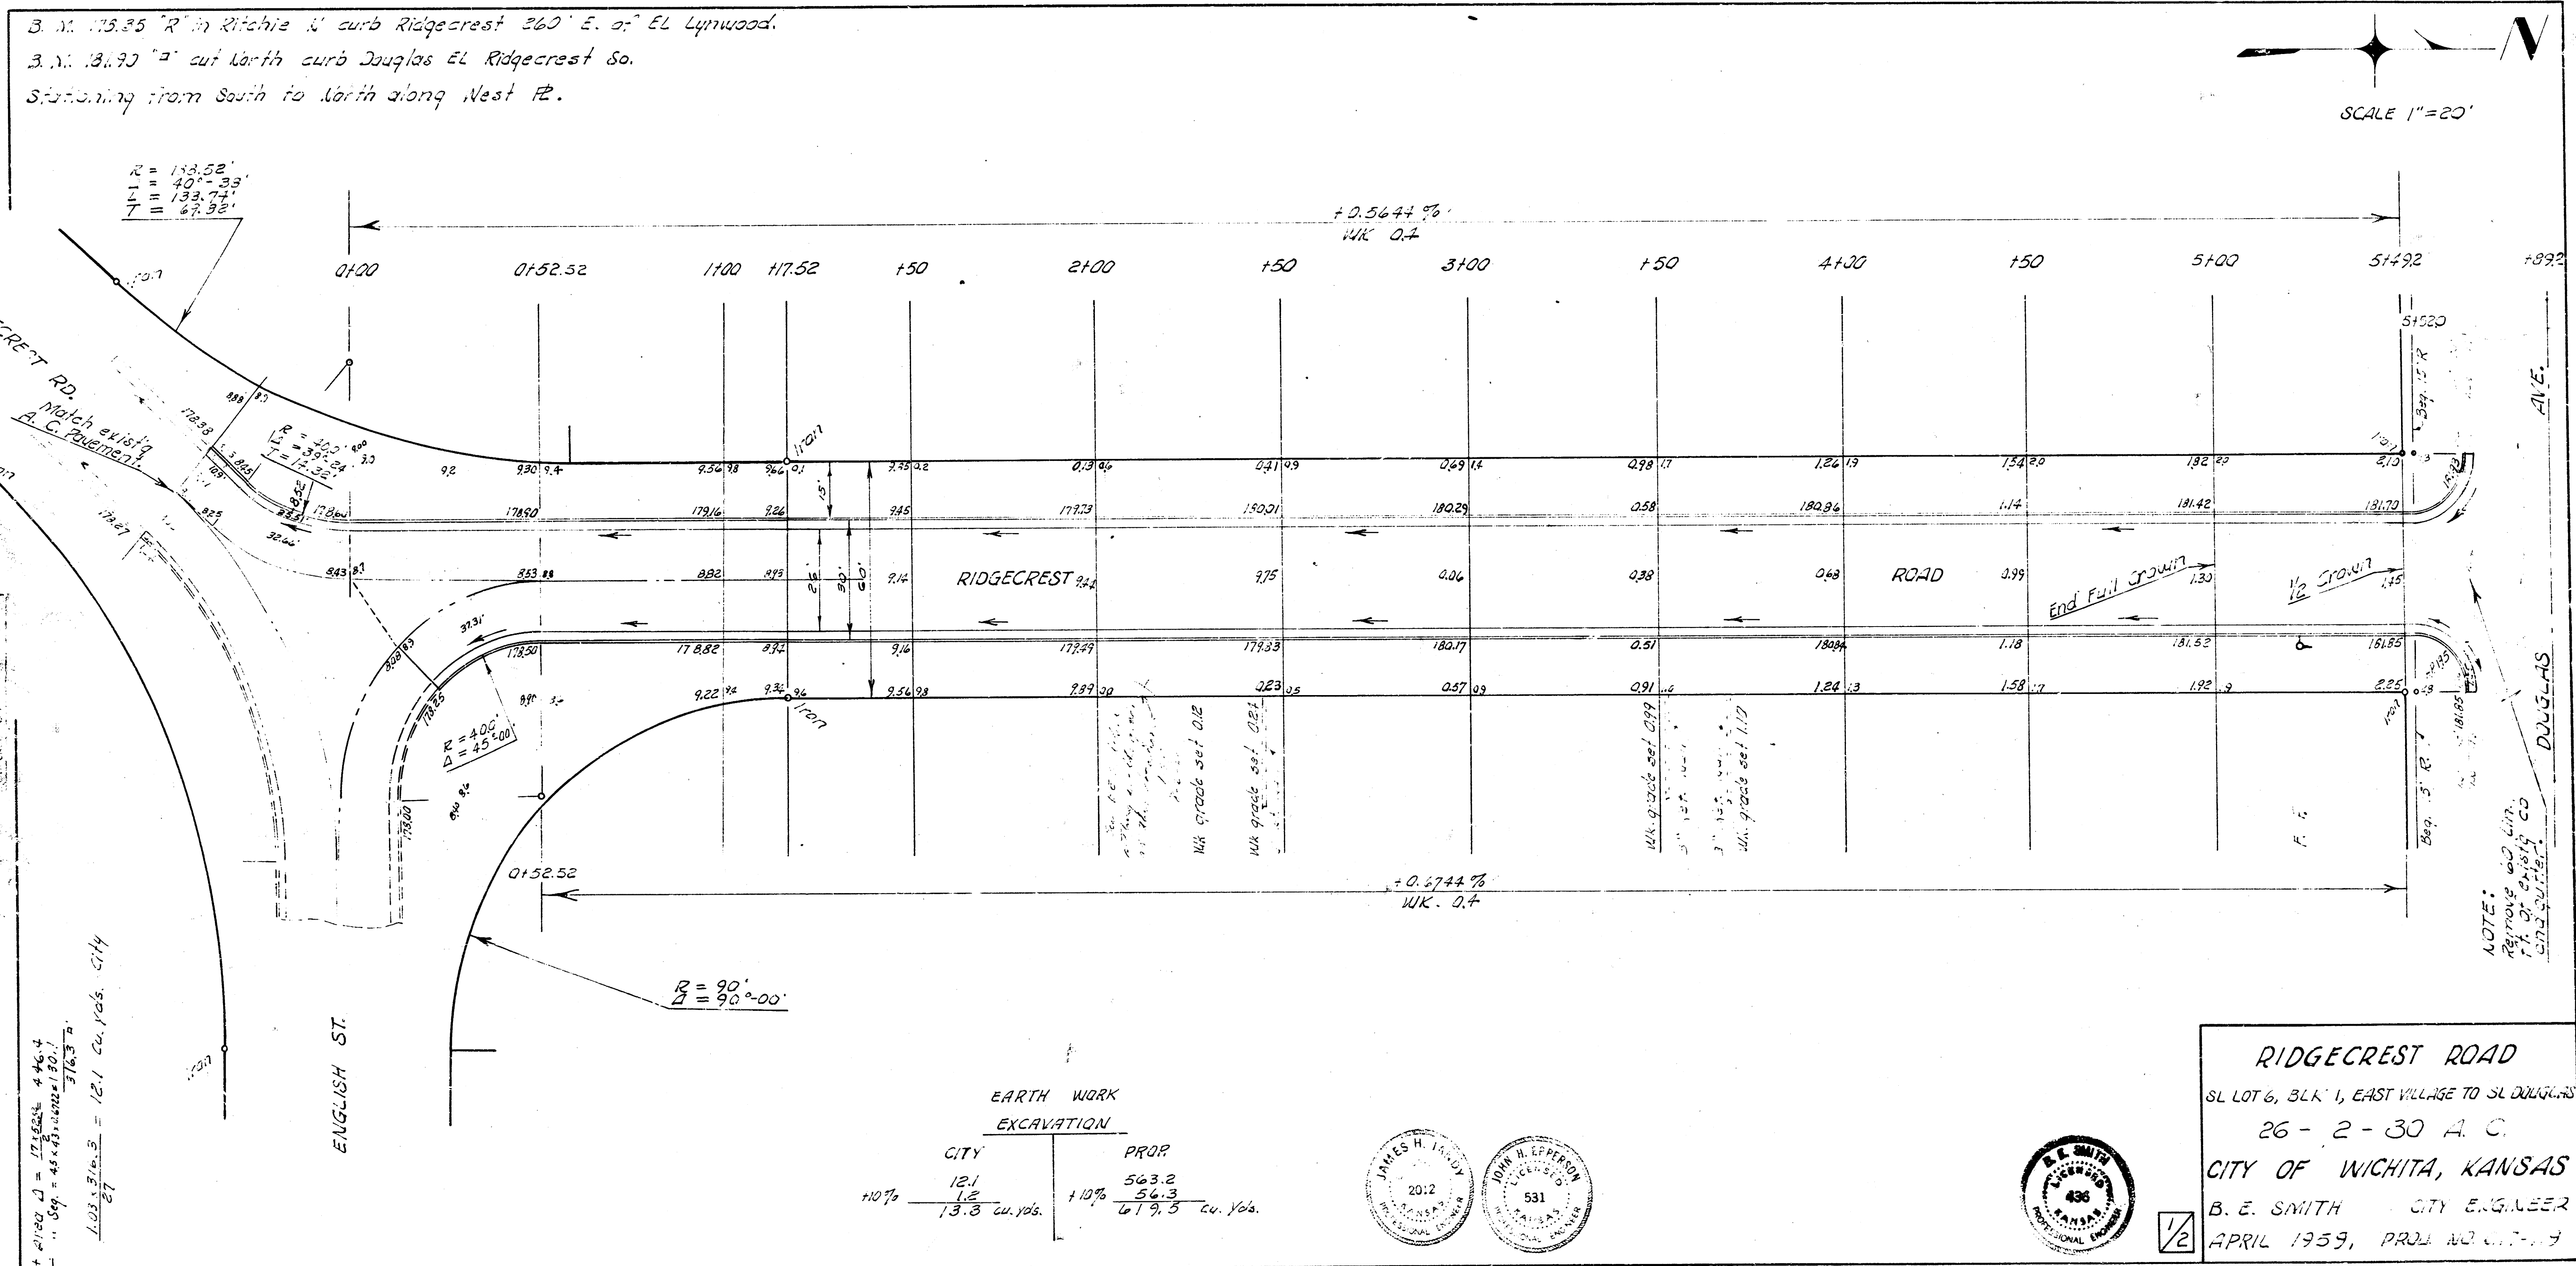

RIDGECREST ROAD
 SL LOT 6, BLK 1, EAST VILLAGE TO SL DOUGLAS
 26 - 2 - 30 A.C.
CITY OF WICHITA, KANSAS
 B. E. SMITH CITY ENGINEER
 APRIL 1959, PROJ. NO. 117-19

