
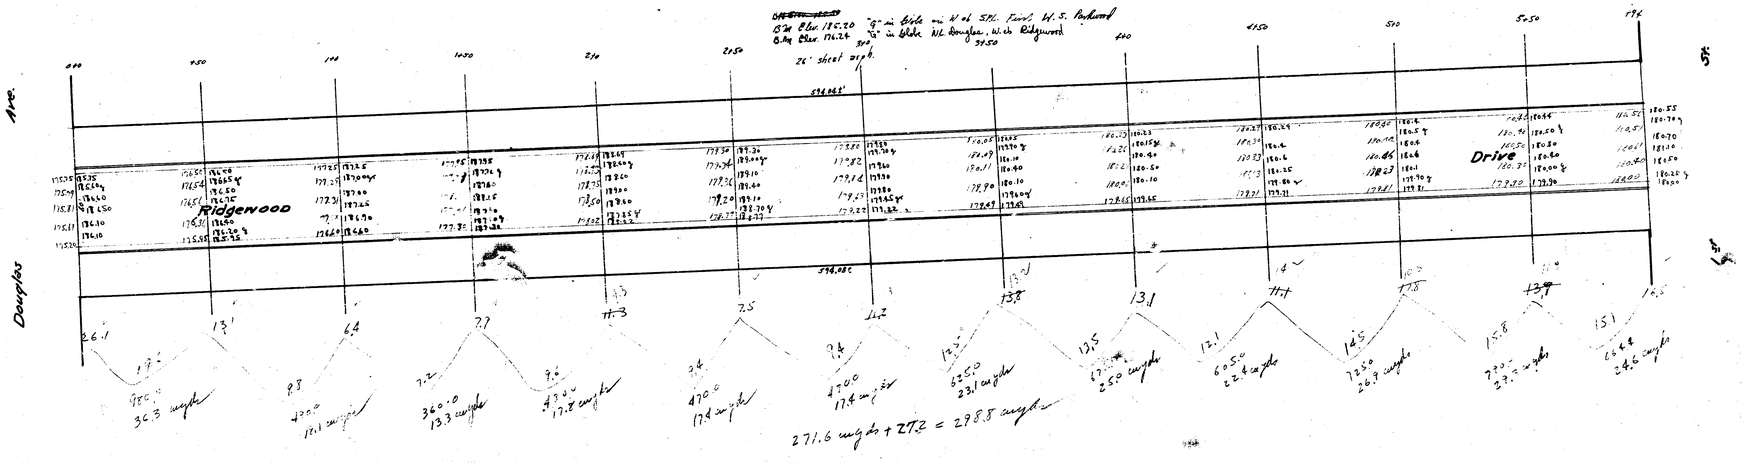


Plan Plan
1938
Ridgewood Dr
11 Couples
&
36 Feet

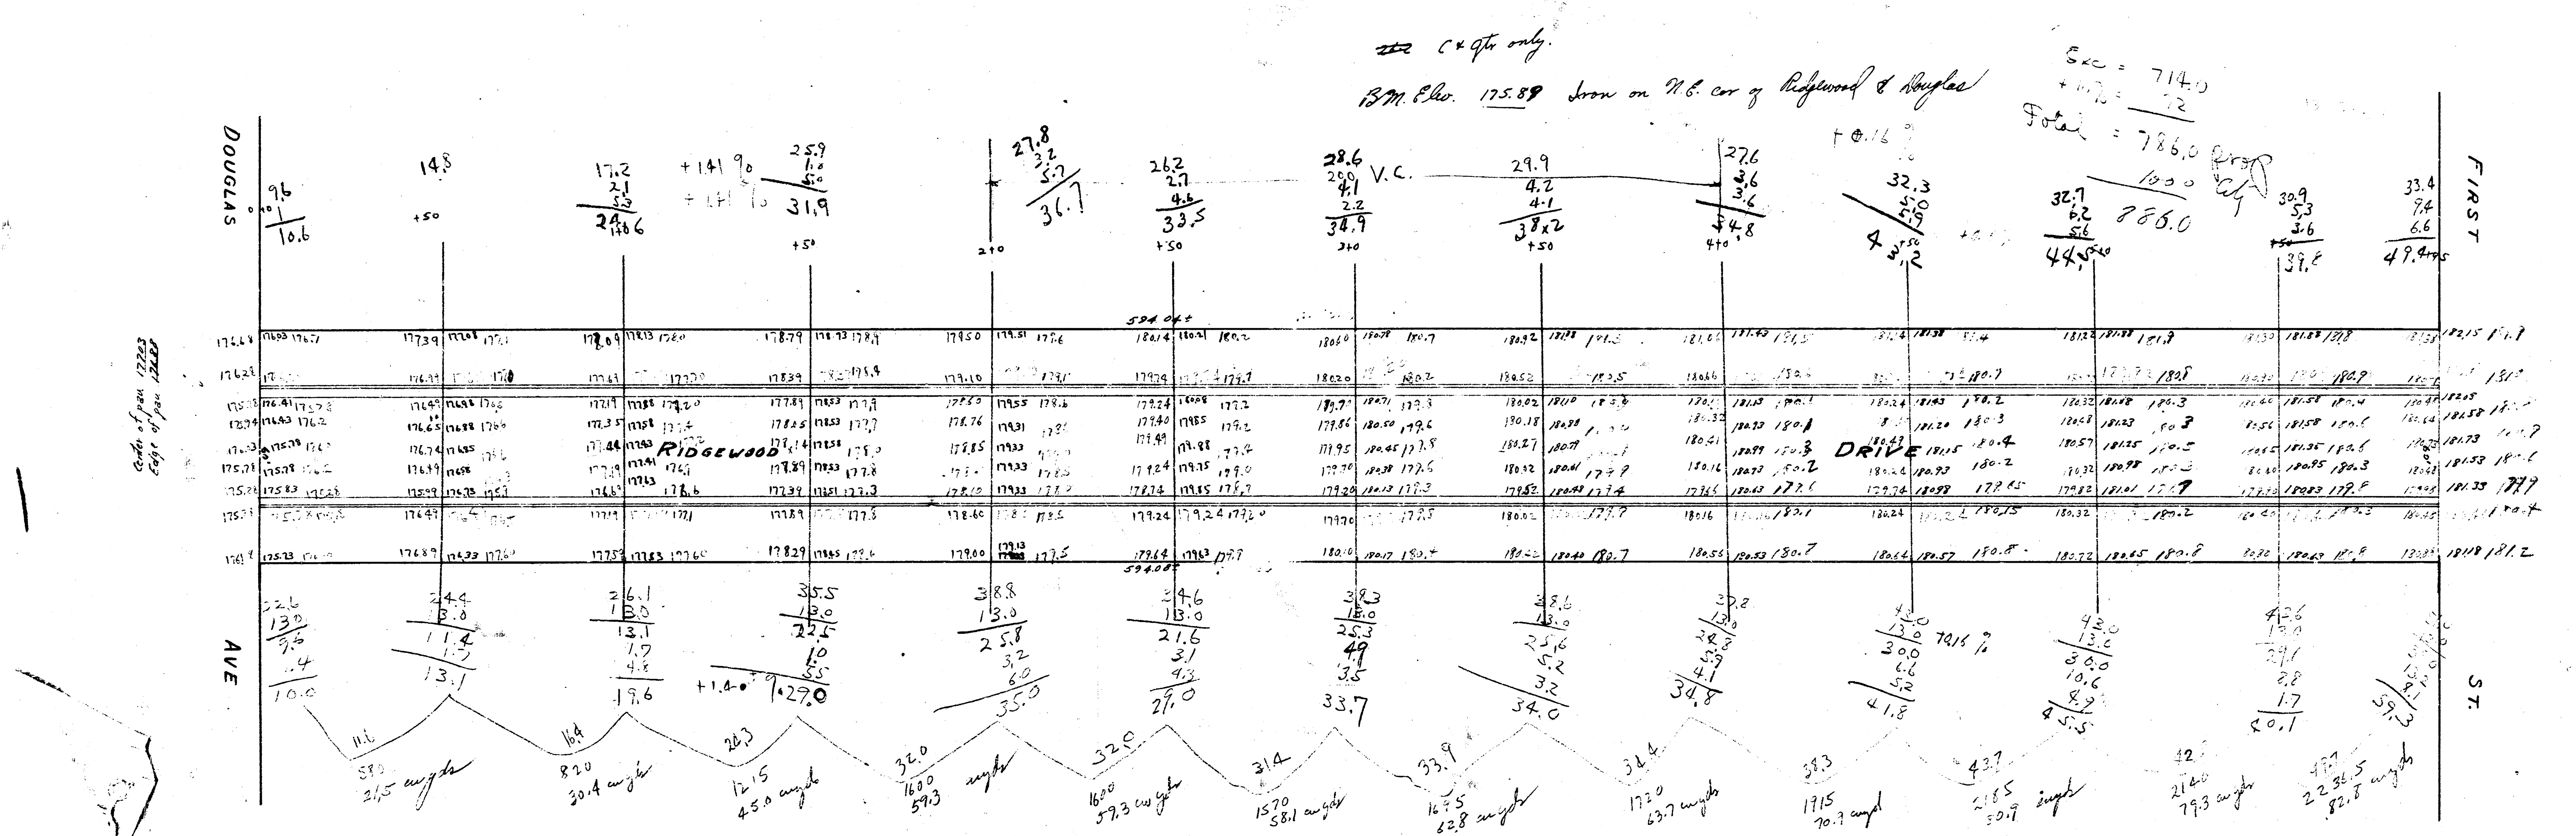

Pav Plan
1937
Ridgewood Dr.
N.L. Douglas
to
S.L. First