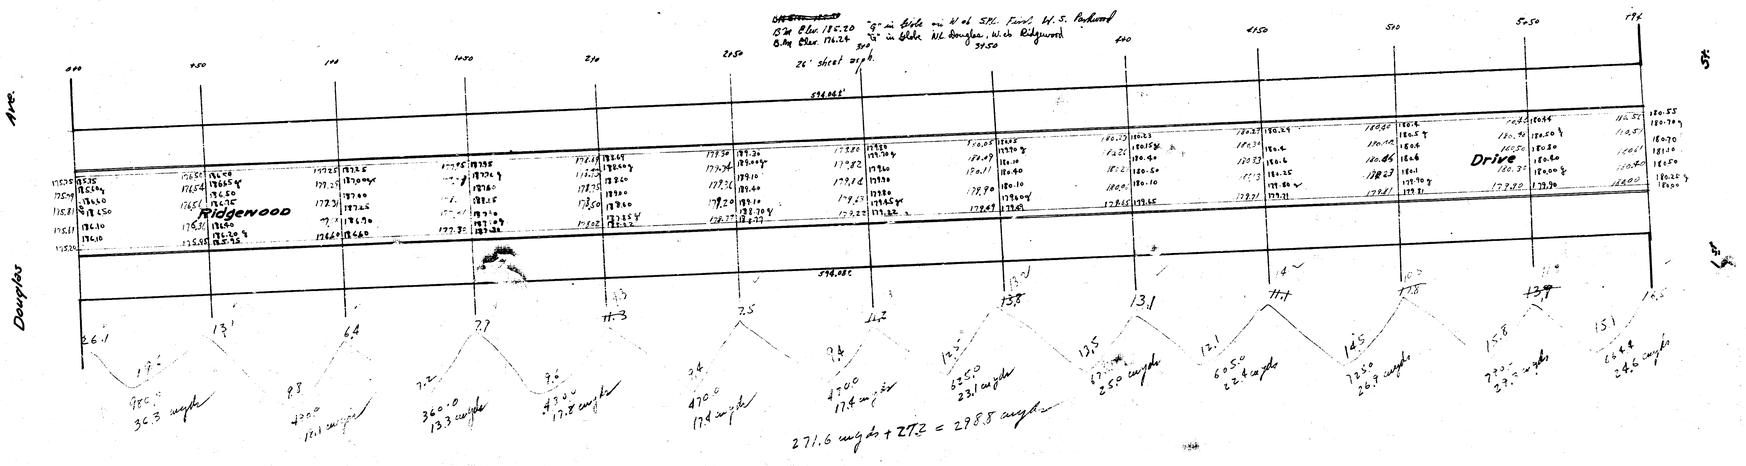
Ridgewood
Drive
Douglas
271.6 angles + 27.2 = 298.8 angles

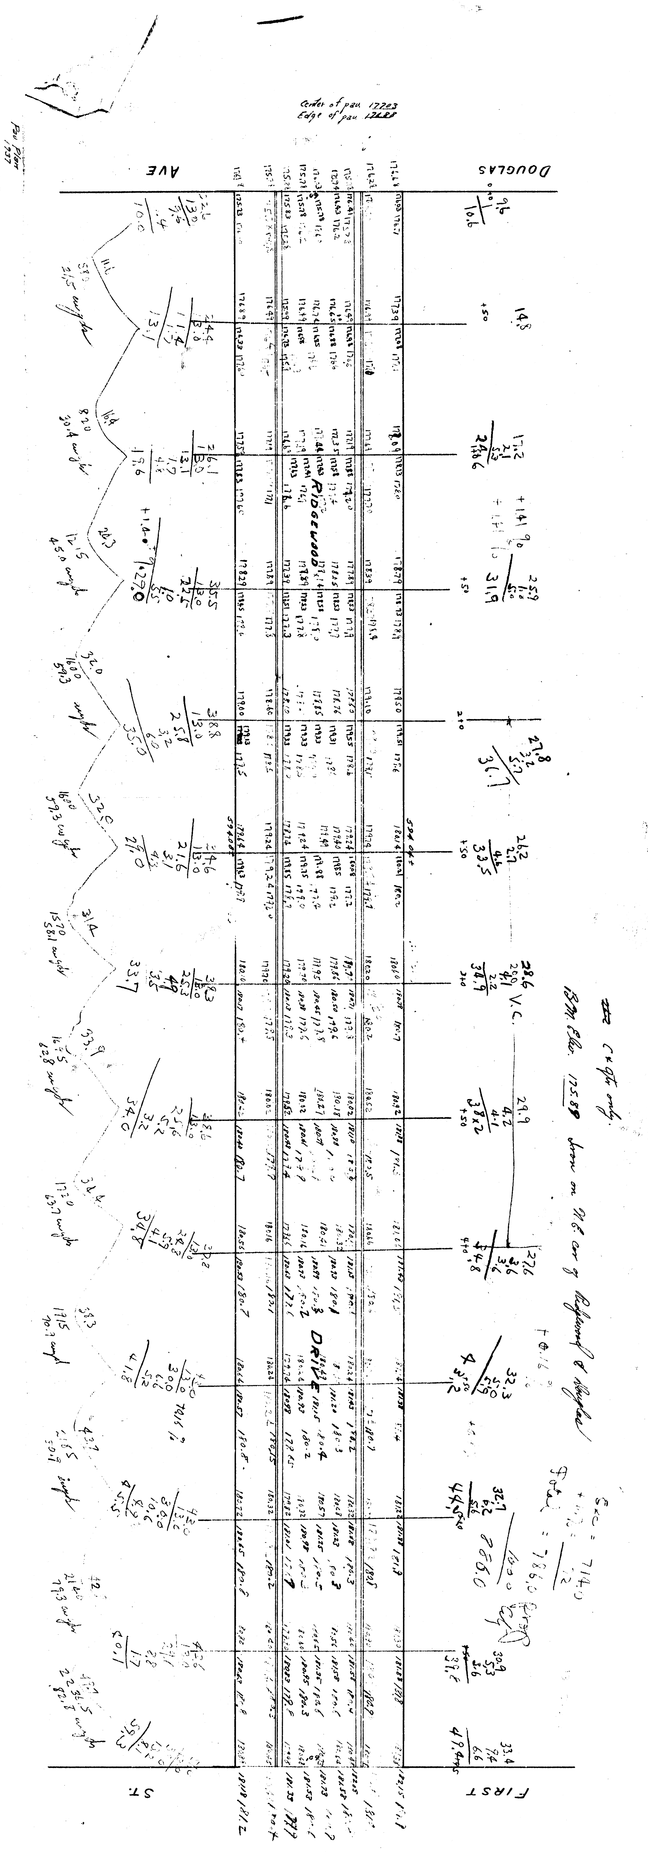

Sec = 719.0
Sec = 7886.0

Cr. of pt. only.

