
1941
RIDGEWOOD DR - N.L. 2ND TO S.L. 3RD
26' CONC.

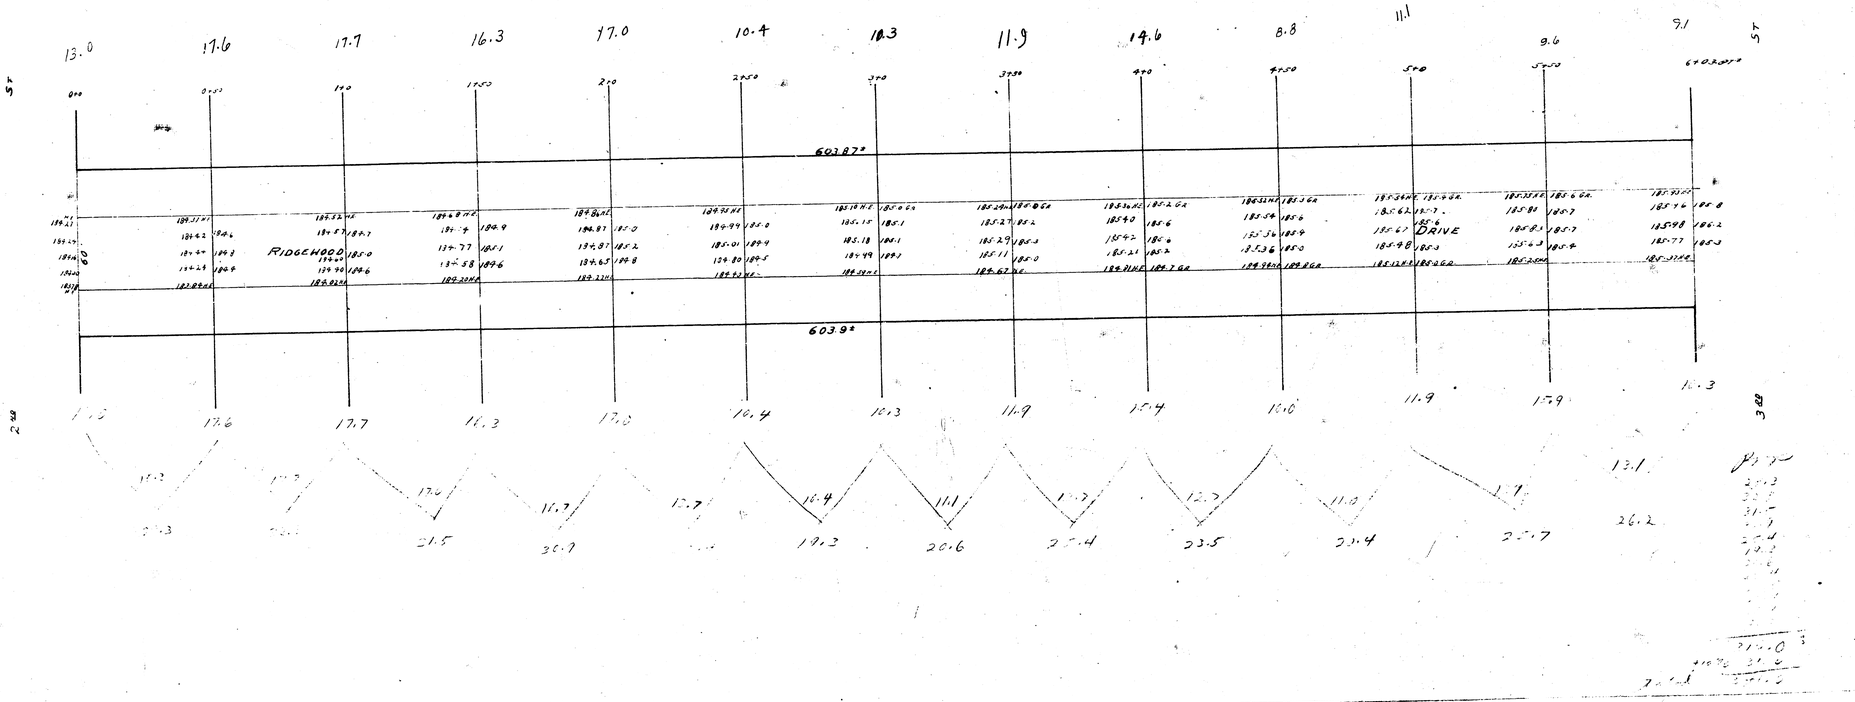

Comb. Cst'g. only

B/f. -114.83 - 5 Cl. 2nd & 2 Cl. Ridgewood

