




4-18-74

0 E S

Signature: D.E.S

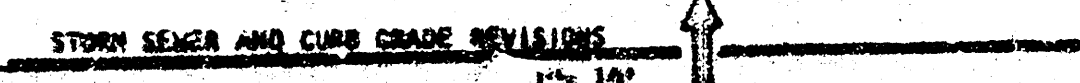

RELOCATION OF RIVERVIEW STREET NORTH
OF SECOND STREET.


