

ROCHESTER AVENUE

N.L. 14TH ST. TO S.L. 15TH ST.


PROJ. NO. C12-232

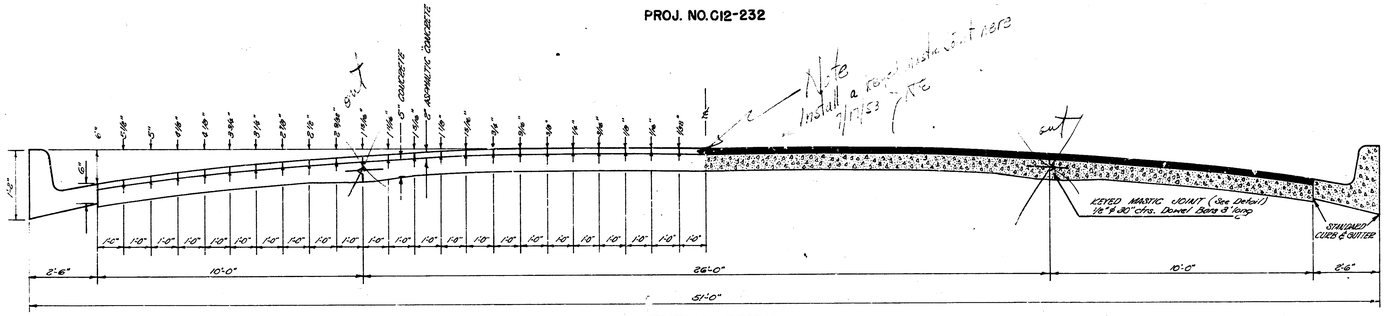

TYPICAL SECTION
NOT TO SCALE

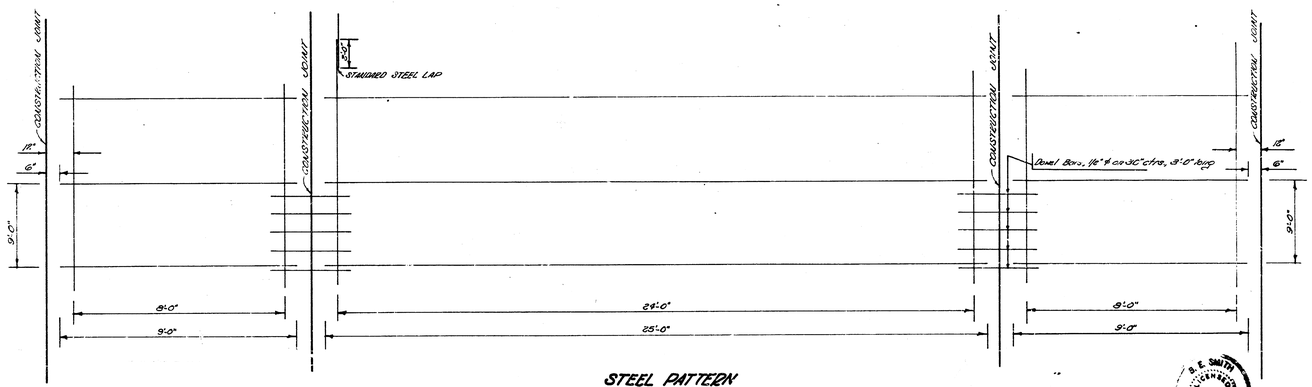

STEEL PATTERN
NOT TO SCALE
USE 3/4" ø BARS EXCEPT WHERE OTHERWISE NOTED

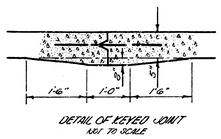

DETAIL OF KEYED JOINT
NOT TO SCALE



B.M. 123.90 N.E. Cor. Top Step No. #320 N. 15th St.
B.M. 123.07 "T" in "Troy on Fire Hyd. Bet. W. Cb. Sta. 0+19

Chain N. on ℄

EXCAV.

Prop.		City	
45.6		12.6	
4:1		1:3	
715.7	Cu. yd.	13.9	Cu. yd.

Total — Total

14th St (Vacated)

+0.128%

-0.192%

Elev. 1009.9 — Elev. 1009.8

Avenue "D"

+0.103%

Elev. 1010.2

Avenue "C"

+0.110%

-0.134%

Elev. 1012.7

15th St

Survey Manual Bk. W/10
Plan
Est. A.E.
Checked J.F.

ROCHESTER AVE.
N.L. 14TH TO S.L. 15TH
46' R/W.

CITY OF WICHITA, KANSAS
B.E. SMITH CITY ENGINEER
JAN. 26, 1953 PROJ. No. C-12-232