


Survey 20169
 Plan 51 Cont. 52
 Lt. Zilmer
 Checked

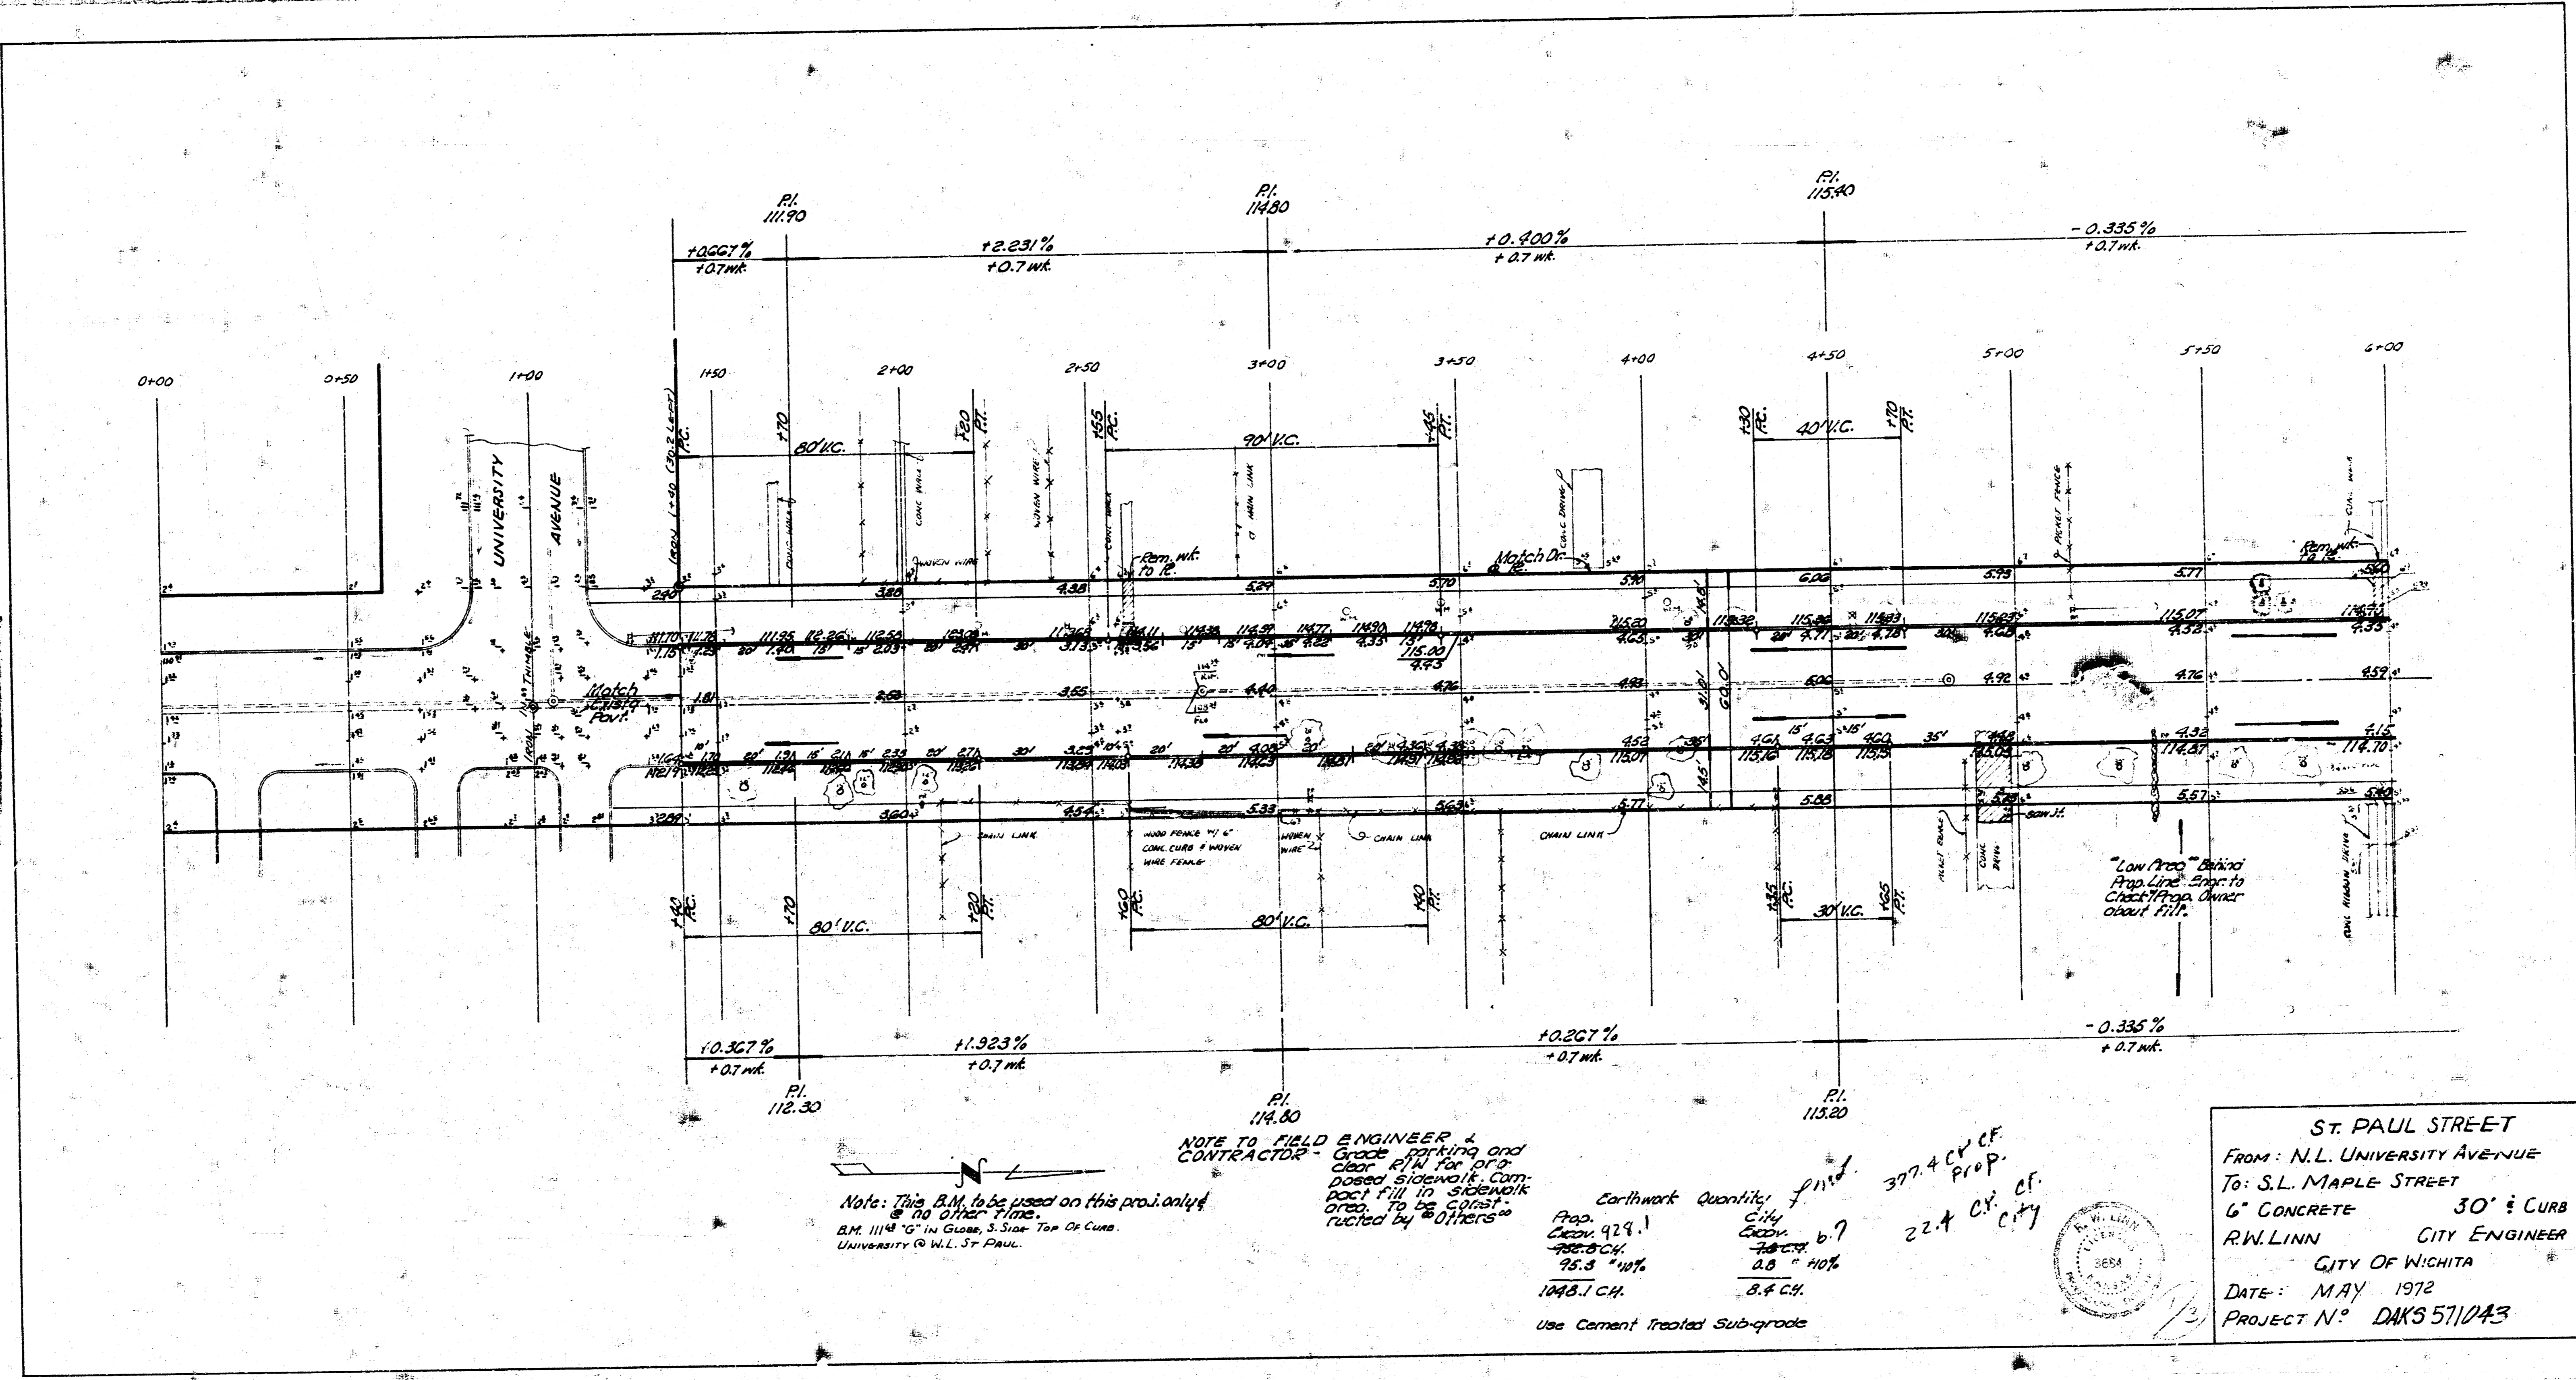

ST. PAUL STREET
 FROM: N.L. UNIVERSITY AVENUE
 TO: S.L. MAPLE STREET
 6" CONCRETE 30' ± CURB
 R.W. LINN CITY ENGINEER
 CITY OF WICHITA
 DATE: MAY 1972
 PROJECT N° DAK5 5710A3

2

