



BM 11612 6" m. Globe-Norm E. Ch. SE 35' Pct. 6.1'

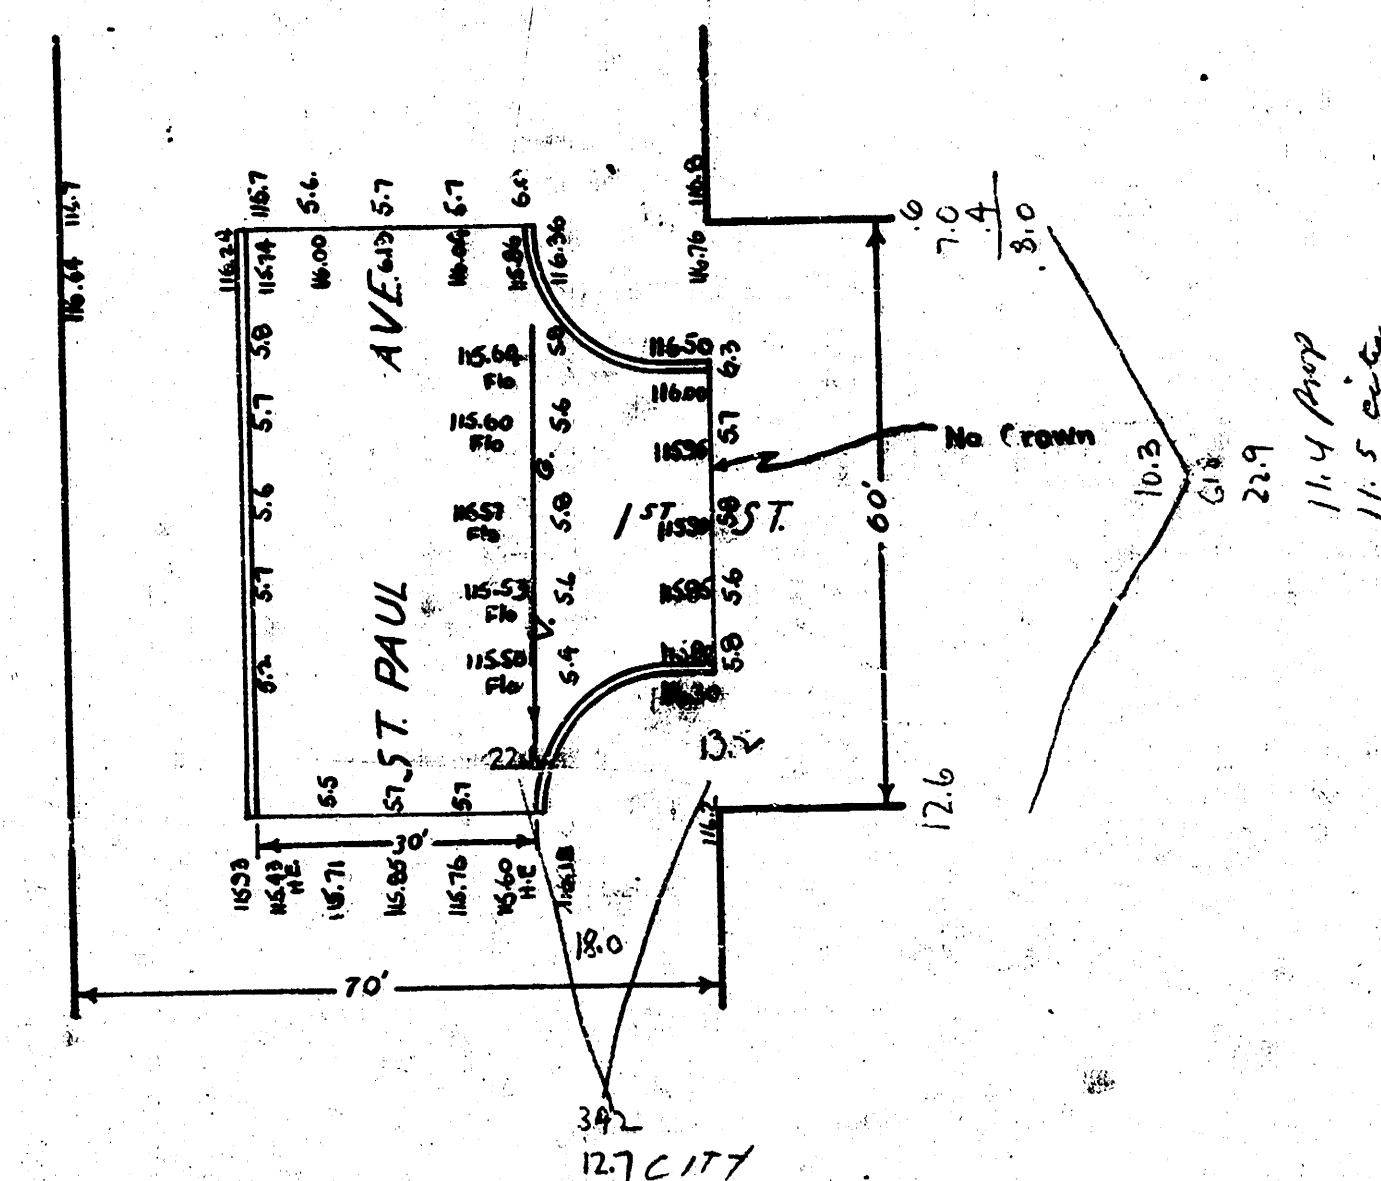

Prop	City
11.4	12.7
11.4	11.5
1.1	2.2
12.5	2.66

ST. PAUL AVE
 30' CONCRETE & CB
 CITY OF WICHITA, KANSAS
 L.K. WHITE CITY ENGINEER
 JUNE 1946

BM 1154 0.0' in Globe E. En. Ch. Rct. NE Corner S. 1st
 BM 1152 0.0' in Globe E. En. Ch. Rct. NE Corner S. 1st

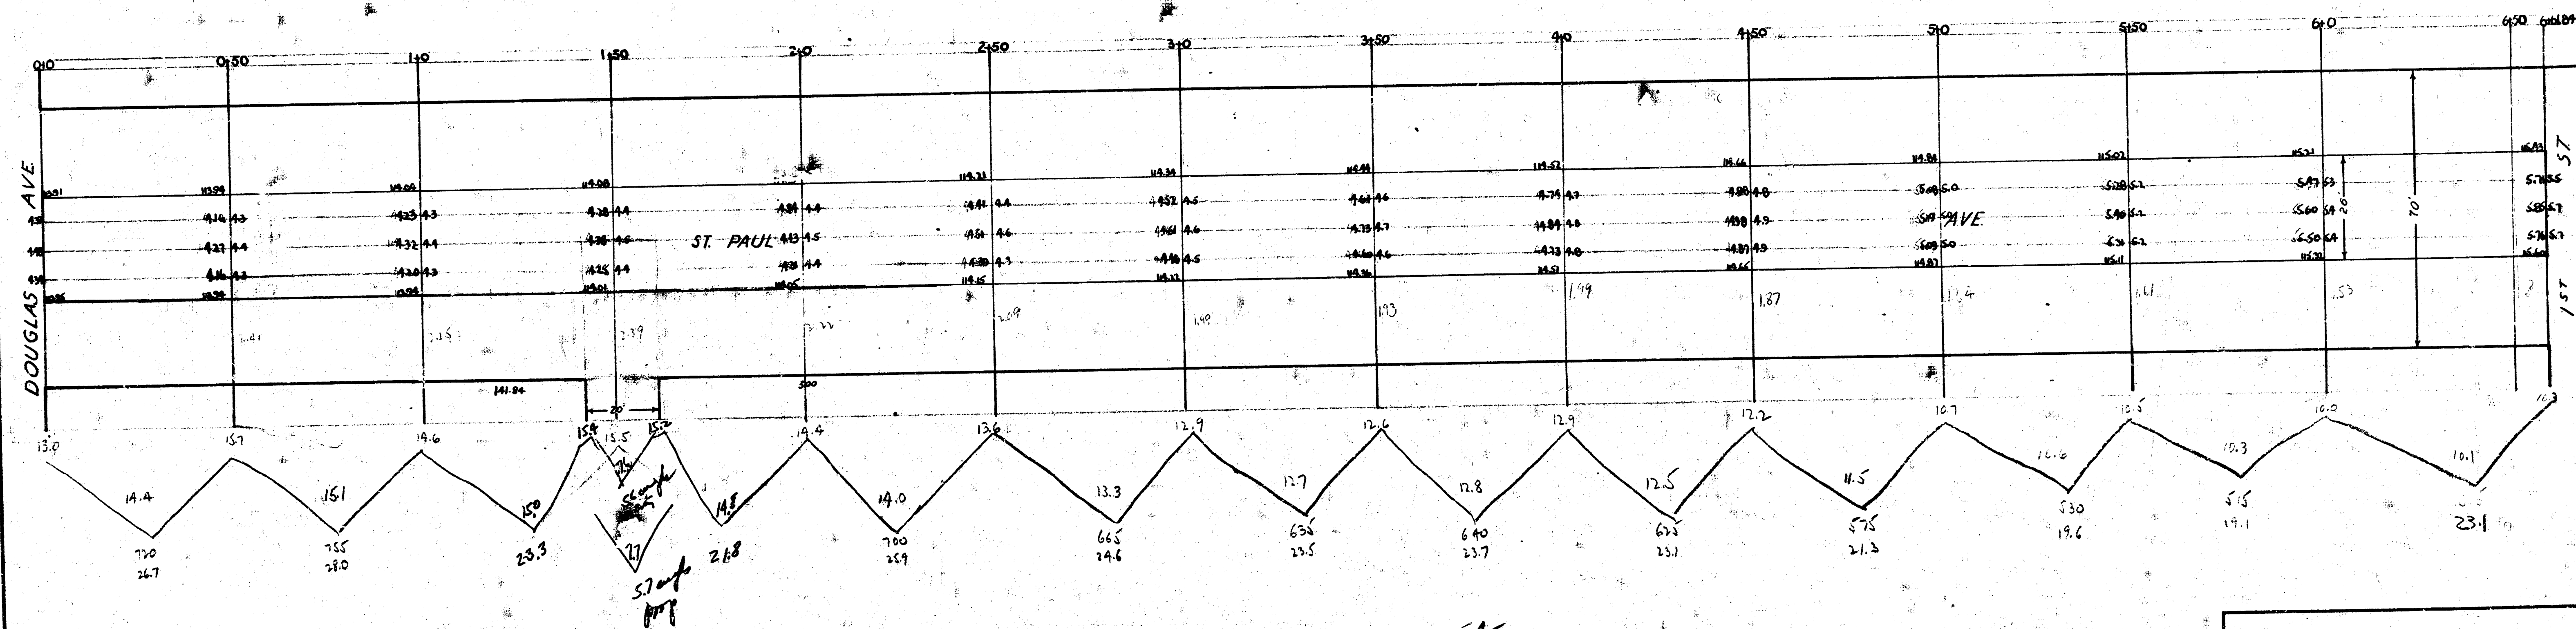

$$\begin{array}{r} 257 \\ +1070 \\ \hline 1327 \end{array}$$

$$\begin{array}{r} 5.6 \\ 6.2 \\ \hline 11.8 \end{array}$$

$$\begin{array}{r} 309.4 \\ 30.9 \\ \hline 340.3 \end{array}$$

ST PAUL AVE
 N. L. DOUGLAS TO S. L. 1st ST
 26' CONCRETE
 CITY OF WICHITA, KANSAS
 L. K. WHITE CITY ENGINEER
 JUNE 1946

[illegible]