


194
125
163

1941
SALINA AVE. - SL. 17TH TO NL. 18TH
COMBINED CURB & GTR
20' PRO-W

H.P.

NOTE: Figures on right of station are ground elevations. Those on left side are grade elevations.

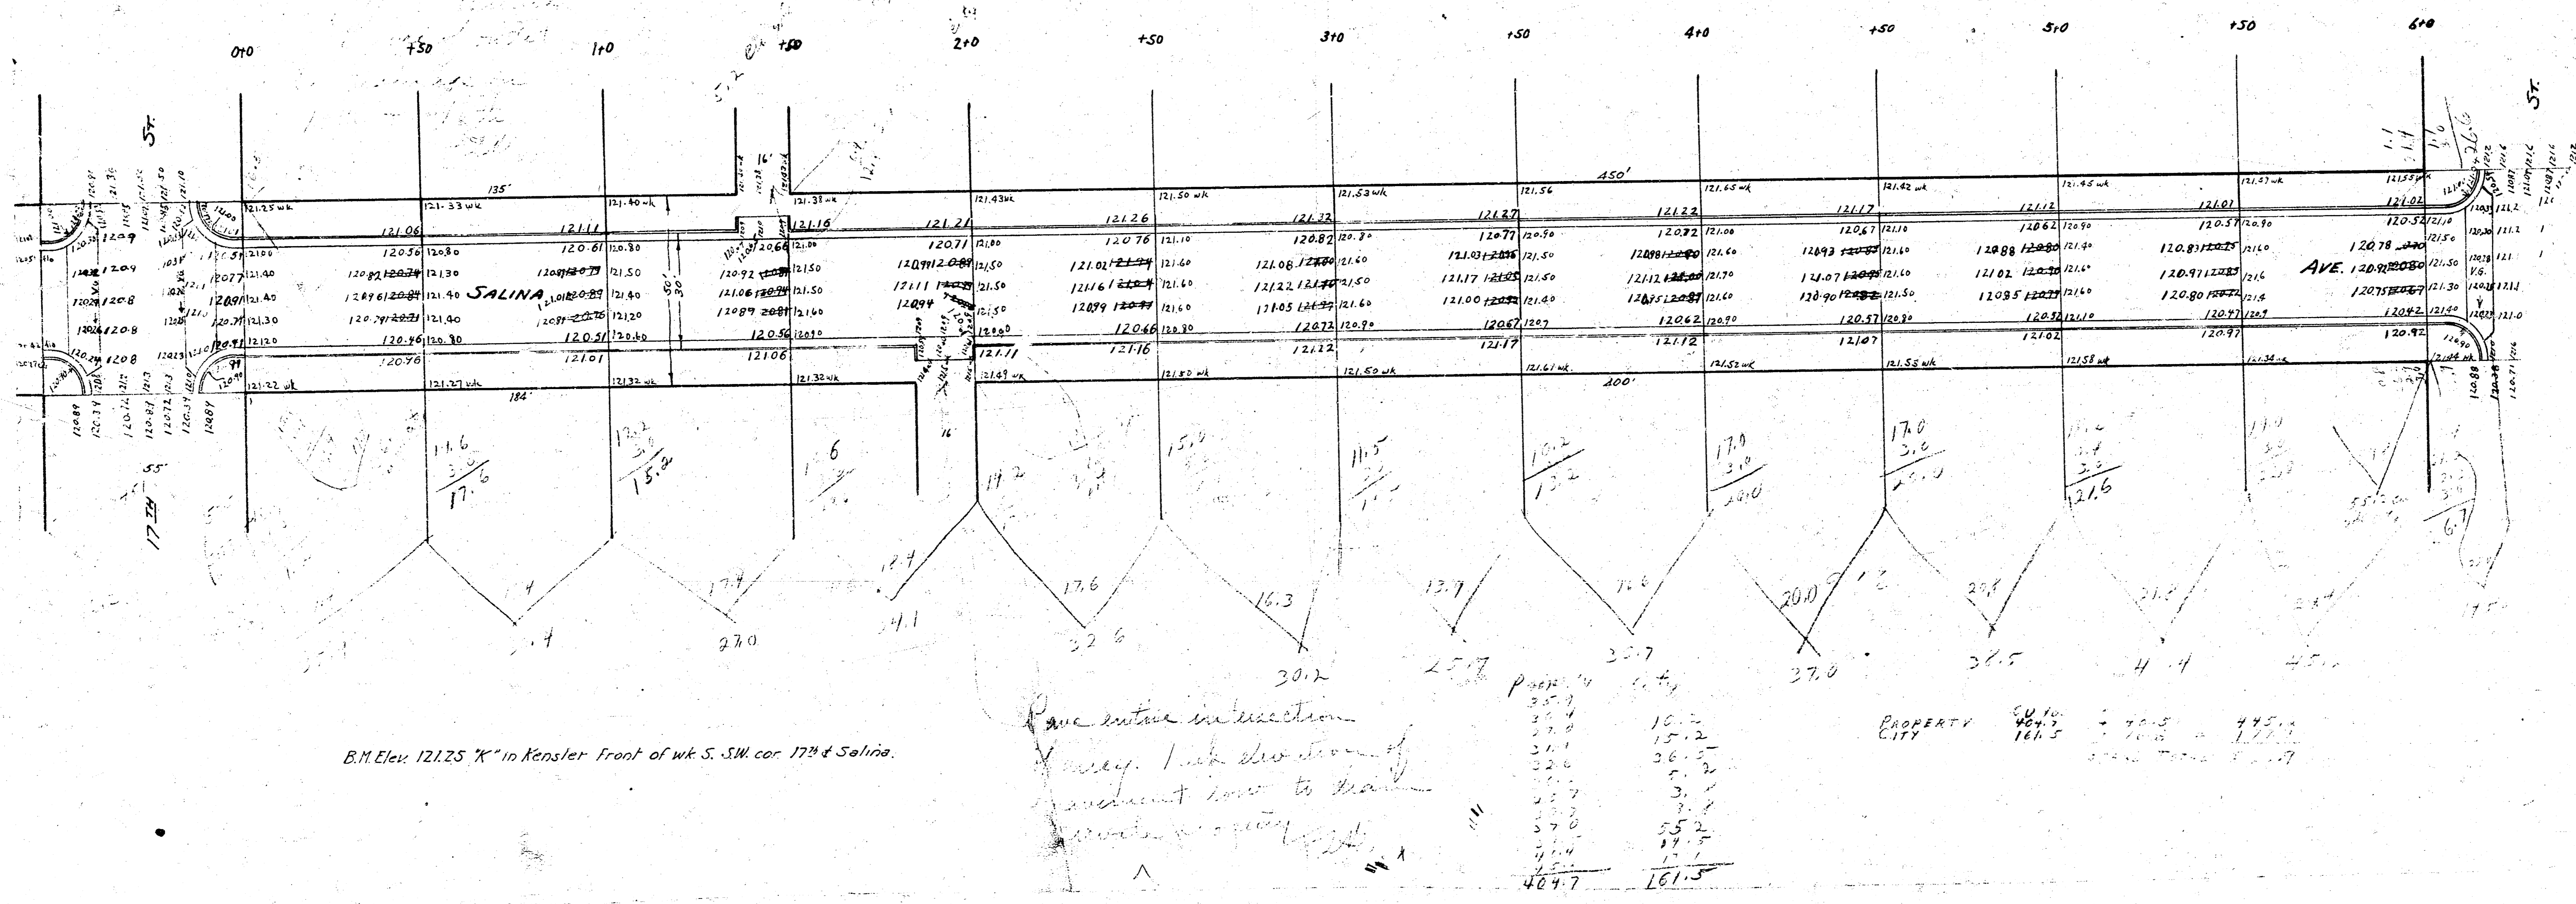

B.M. Elev. 121.25 'X' in Kenster front of blk. S. SW. cor. 17th & Salina.

Have entire intersection survey. With elevation of adjacent low to drain...

PROPERTY CITY






10.2
15.2
26.5
3.2
3.1
3.1
3.1
55.2
14.5
1.1
161.5

B. M. 121.41 '6" in Globe E.S. Int. of S.E. Cor. 17th & Salina

Chain N. on E


DATE: 10/1/54
 DRAWN BY: B.E. SMITH
 CHECKED BY: J.W. GAYNE

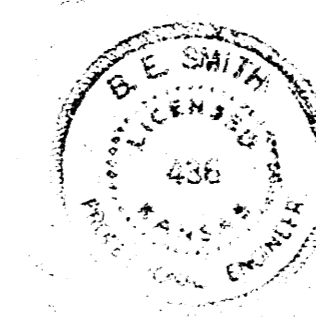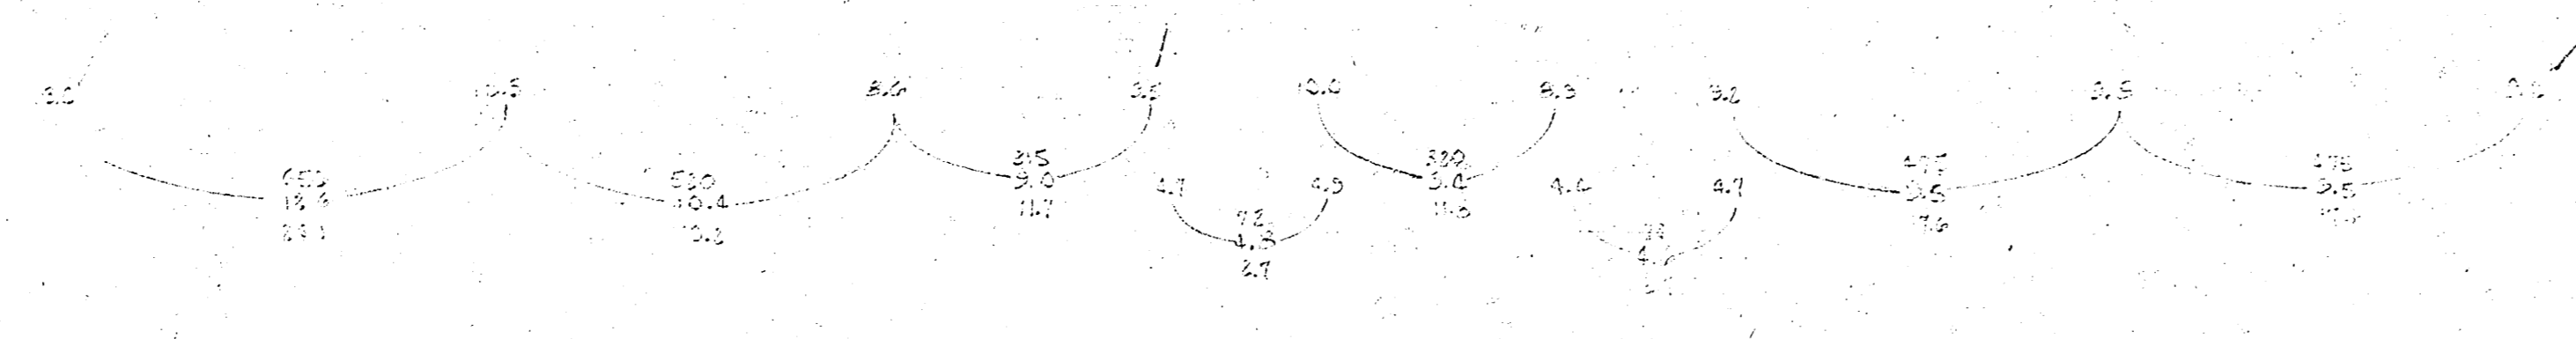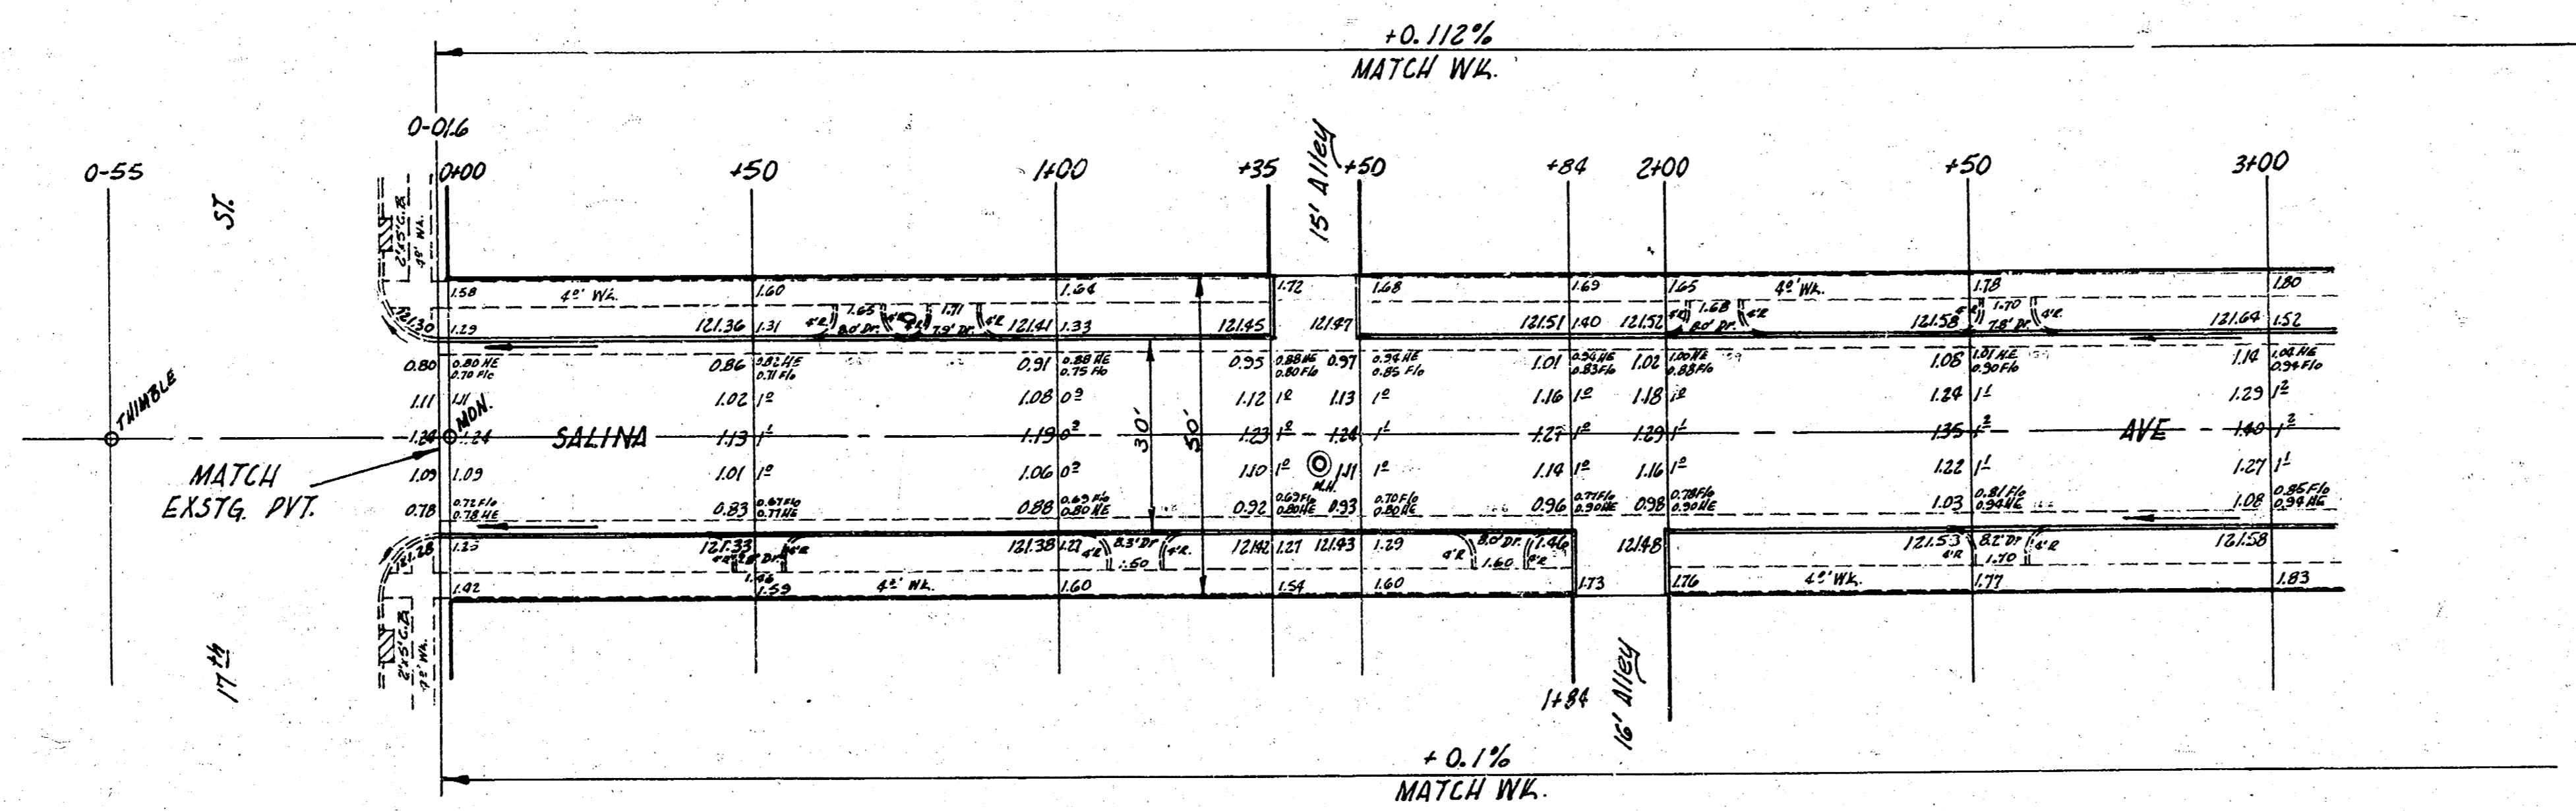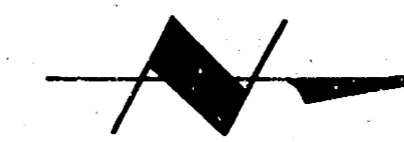

1/2

SALINA AVE.
 N.L. 17th - S.L. 18th
 30' CONC. & C.B.
 CITY OF WICHITA, KANS.
 B.E. SMITH CITY ENGINEER
 OCT., 1954 PROJ. NO. C14-266

10/1/54
 B.E. SMITH
 10/1/54

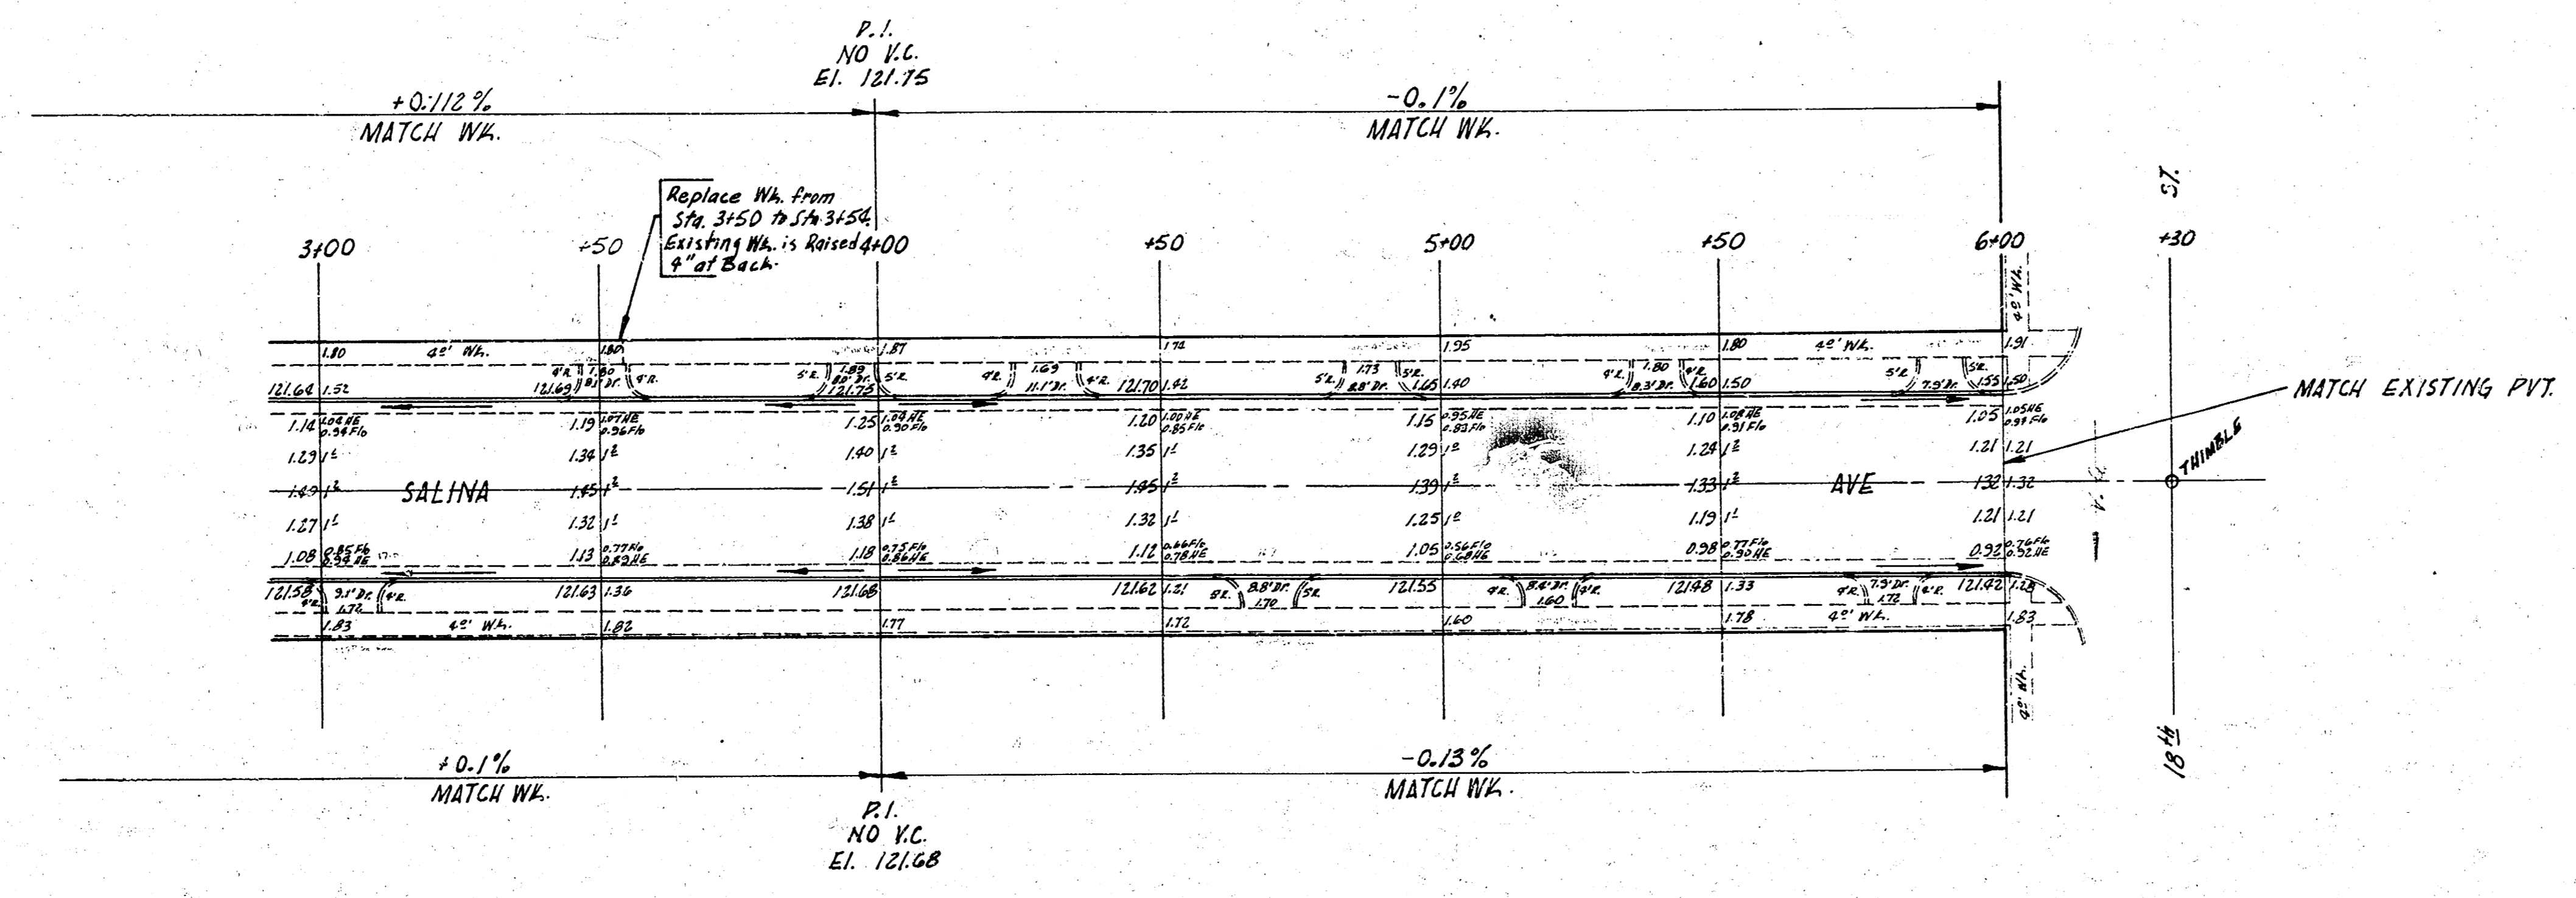

22

SALINA AVE.
 PROJ. NO. C14-266