



SENECA

S.L. ESTHNER TO N.L. MERTON

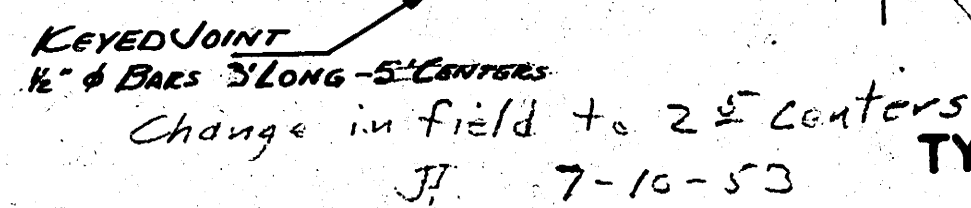


TYPICAL SECTION
NO SCALE

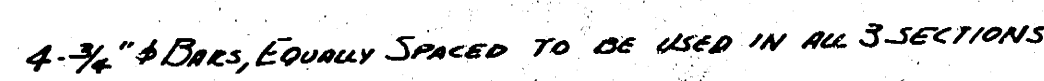

STEEL PATTERN
NO SCALE




DETAILS OF CONTRACTION JOINT
NO SCALE

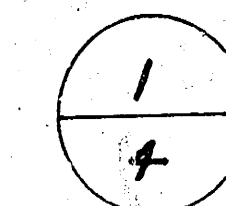

S-19

B.M. X 44 S. Co. ESTHNER W.S. SENECA 101.20
B.M. R.R. SPUR E.S. K&E P.W. SW Co. SENECA 102.87

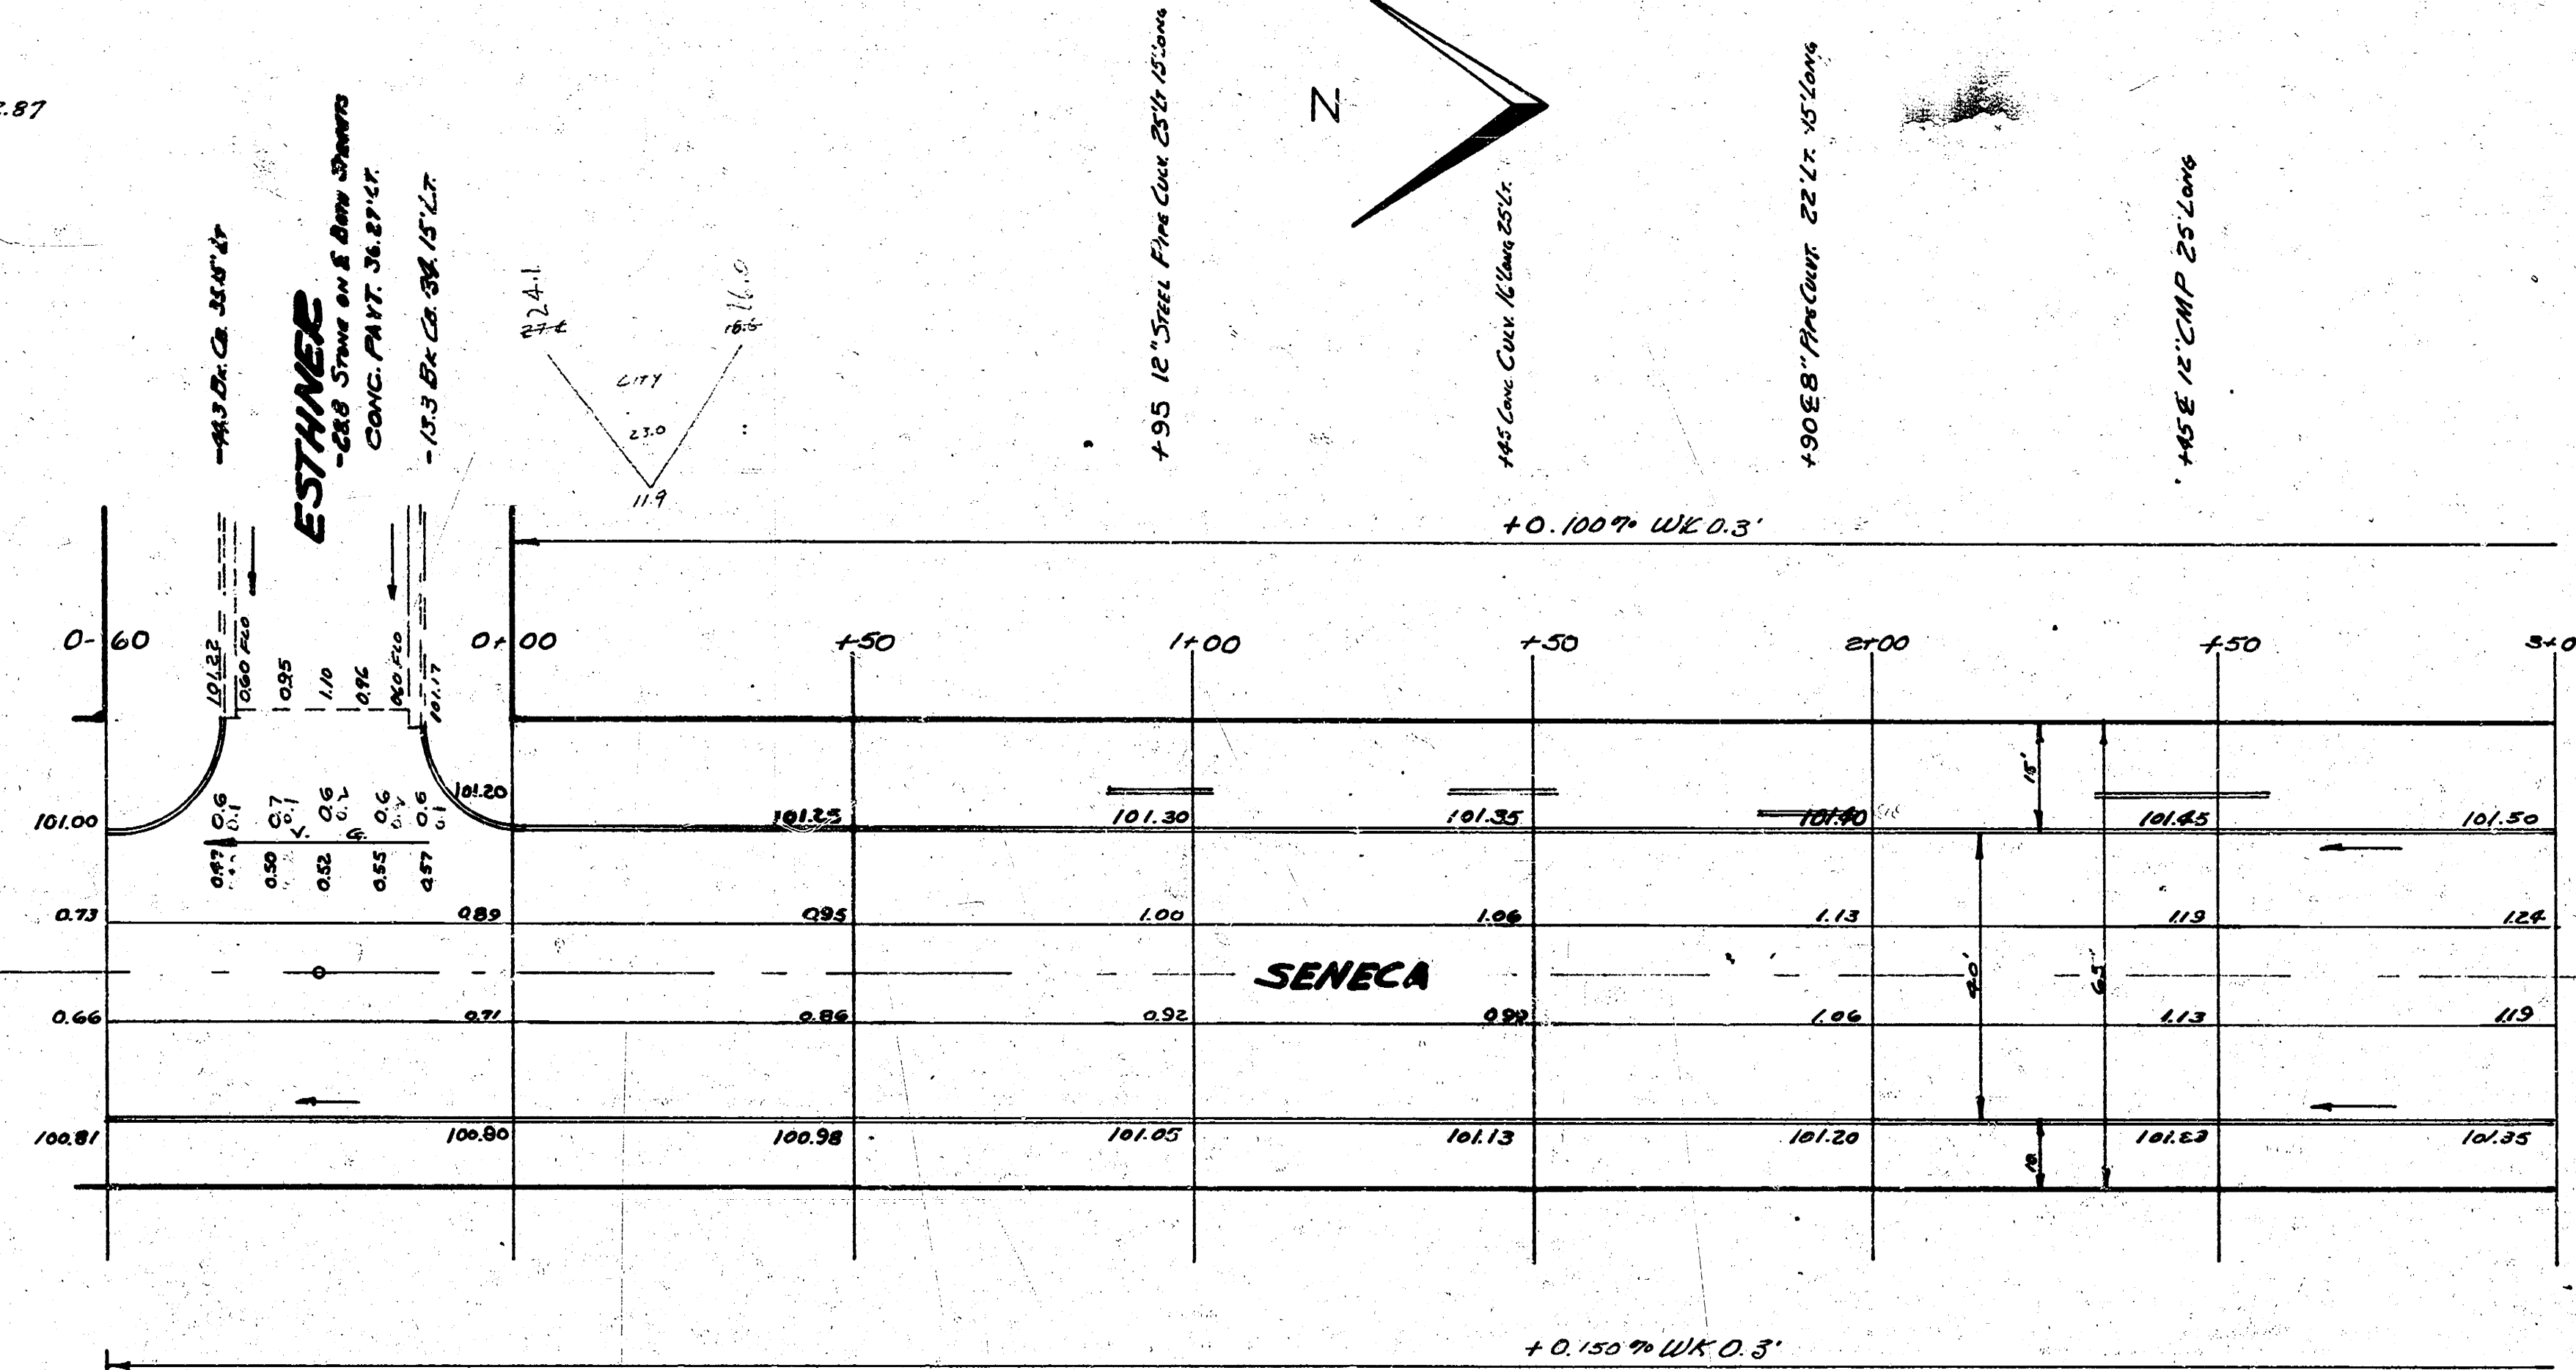


TOTALS

C12-162		CITY	
PROP.	FILL	PROP.	FILL
988.2 yds	880.4 yds	135.6 yds	494 yds

C12-163	
PROP.	FILL
477.2 yds	281.2 yds

NOTE TO FIELD ENGINEER & CONTRACTOR:
PLACE ENTRANCE CULVERT PIPE ON OWNERS
PROPERTY THE STREET DEPT. WILL REMOVE
THIS PIPE AT THE REQUEST OF THE OWNER.

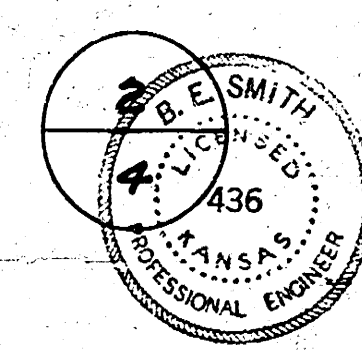

SENECA
S.L. ESTHNER TO N.L. MERTON
30' CONC. CURB, WIDEN TO 40'
CITY OF WICHITA
L.K. WHITE CITY ENGINEER
Oct. 1952 PROJ. C12-162, C12-163

