

SHERIDAN AVENUE

N. L. 31ST. STREET SO. TO N. L. SUNNYBROOK LANE


TYPICAL SECTION 29'-0" CONCRETE PAVEMENT

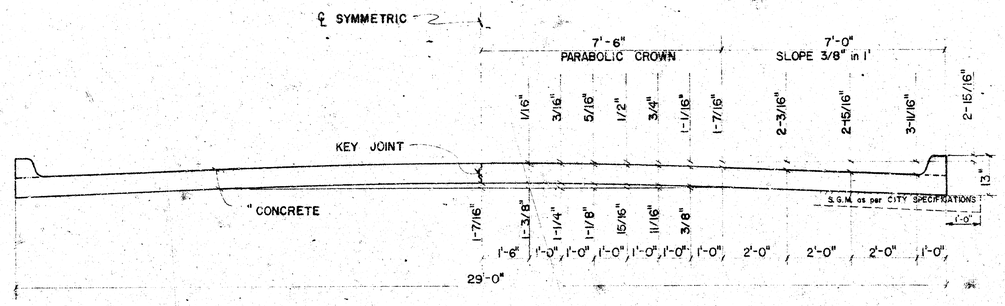

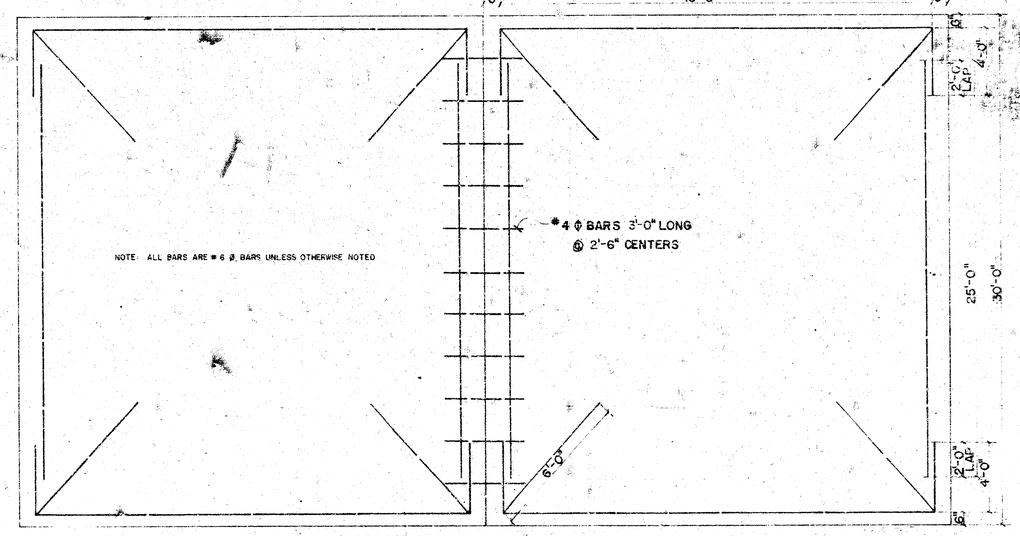


STEEL PATTERN


NO SCALE

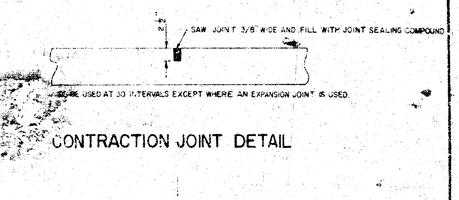

CONTRACTION JOINT DETAIL

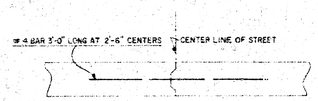

KEY JOINT DETAIL

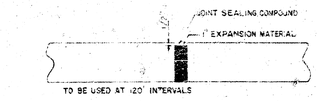

EXPANSION JOINT DETAIL

CITY OF WICHITA, KANSAS

DEPARTMENT OF PUBLIC WORKS-ENGINEERING DIVISION

B. E. SMITH — CITY ENGINEER

DATE: — PROJ. NO. DAKS575049

1/6


FILMED FROM THE BEST AVAILABLE COPY

B.M. 103.22 City Std. Top East End South Handrail To R.C.B. @ Sheridan & 31st Street

Baseline on East R/ of Sheridan

Scale: 1"=20'

Note: Drainage Ditch Grading By "Others."

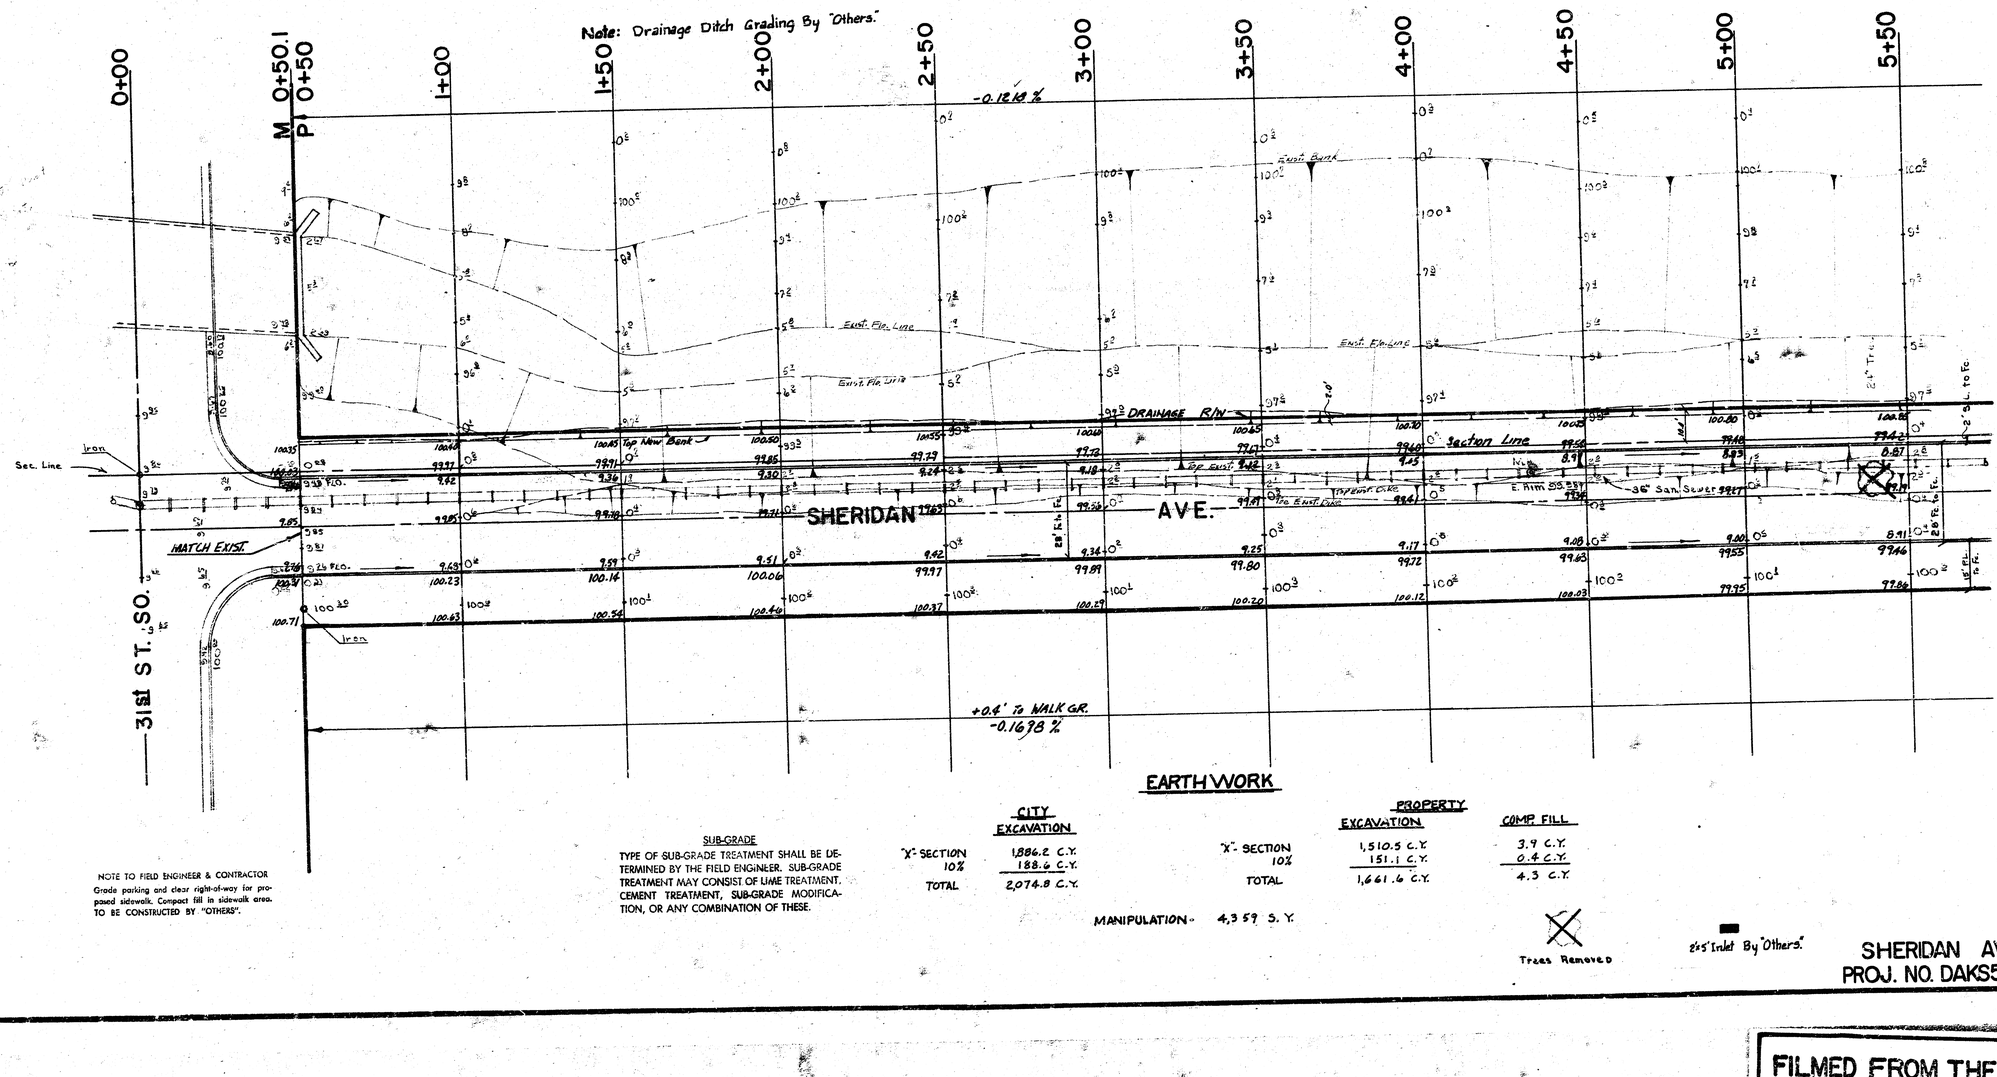

NOTE TO FIELD ENGINEER & CONTRACTOR

Grade parking and clear right-of-way for proposed sidewalk. Compact fill in sidewalk area. TO BE CONSTRUCTED BY "OTHERS".

SUB-GRADE

TYPE OF SUB-GRADE TREATMENT SHALL BE DETERMINED BY THE FIELD ENGINEER. SUB-GRADE TREATMENT MAY CONSIST OF LIME TREATMENT, CEMENT TREATMENT, SUB-GRADE MODIFICATION, OR ANY COMBINATION OF THESE.

EARTHWORK

	CITY EXCAVATION	PROPERTY EXCAVATION	PROPERTY COMP FILL
"X" SECTION	1,886.2 C.Y.	1,510.5 C.Y.	3.9 C.Y.
10%	188.6 C.Y.	151.1 C.Y.	0.4 C.Y.
TOTAL	2,074.8 C.Y.	1,661.6 C.Y.	4.3 C.Y.

MANIPULATION - 4,359 S.Y.


Trees Removed

2'x5' Inlet By "Others."

SHERIDAN AVE.
PROJ. NO. DAKS575049

2/6


FILMED FROM THE BEST AVAILABLE COPY

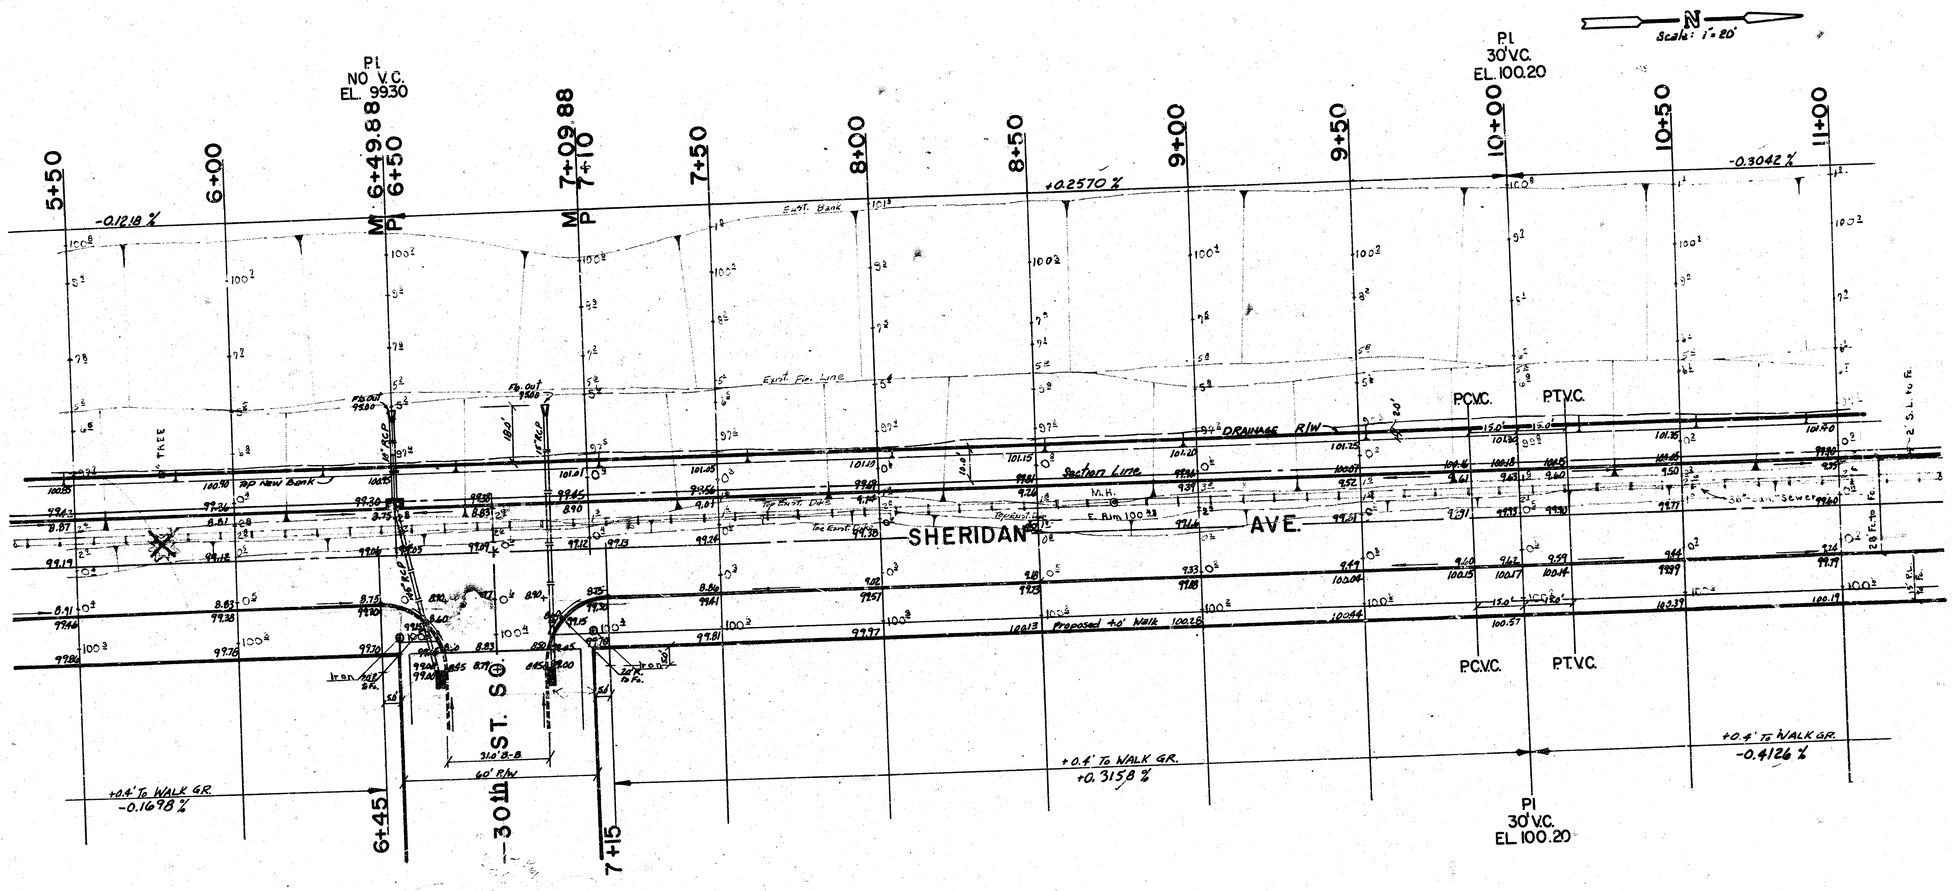

SHERIDAN AVE.
PROJ. NO. DAKS575049

3/6

FILMED FROM THE BEST
AVAILABLE COPY

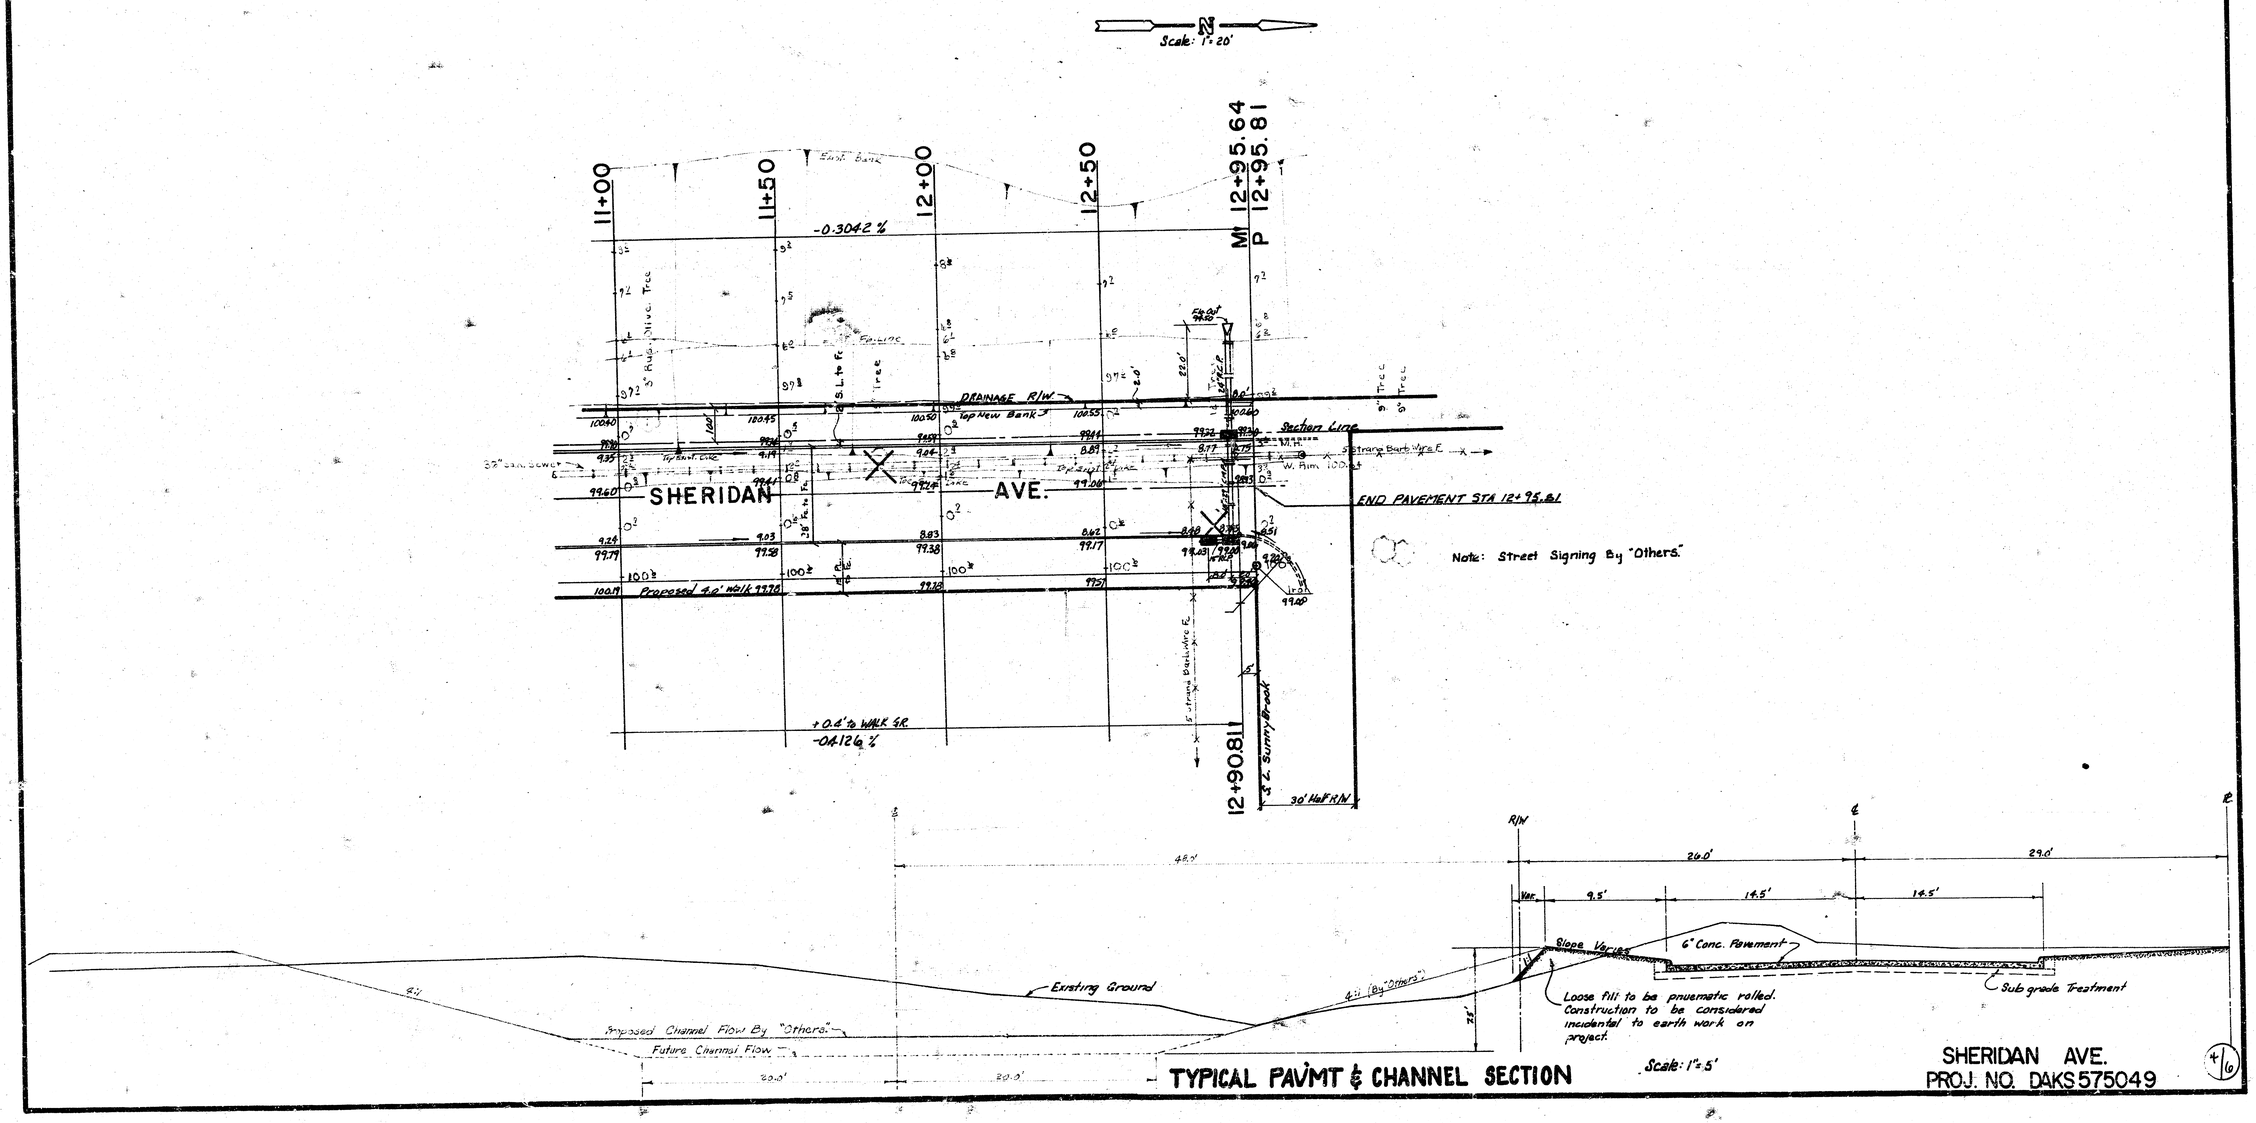


TYPICAL PAVMT & CHANNEL SECTION

SHERIDAN AVE.
PROJ. NO. DAKS 575049


4/6


FILMED FROM THE BEST AVAILABLE COPY

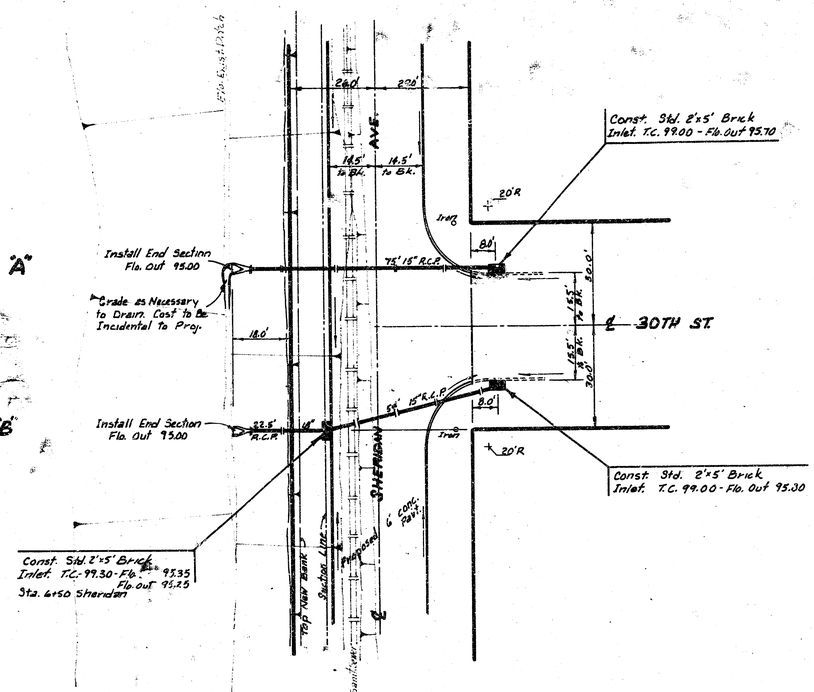

PLAN SCALE: 1" = 20'
PROFILE SCALE: 1" = 10' HORIZ.
1" = 5' VERT.

Note: Cost for end sections to be included in the price bid for pipe. Cost for mechanically tamped backfill to be incidental to project.

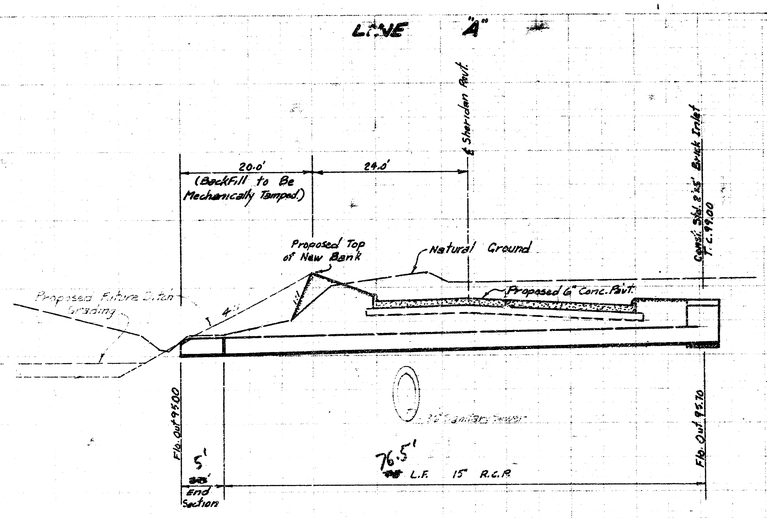

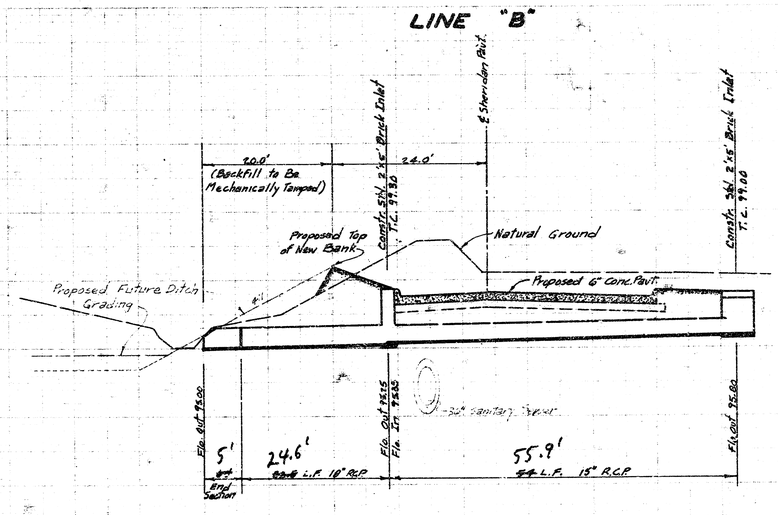


As Built 4-8-76

INCIDENTAL DRAINAGE
IN CONNECTION WITH THE PAVING
OF
SHERIDAN AVENUE
N.L. 31ST ST. SO. to N.L. SUNNYBROOK LN.
CITY OF WICHITA, KANSAS
R. W. LINN - CITY ENGINEER
DATE: PROJ. NO. DAKD575049

5/6

FILMED FROM THE BEST AVAILABLE COPY

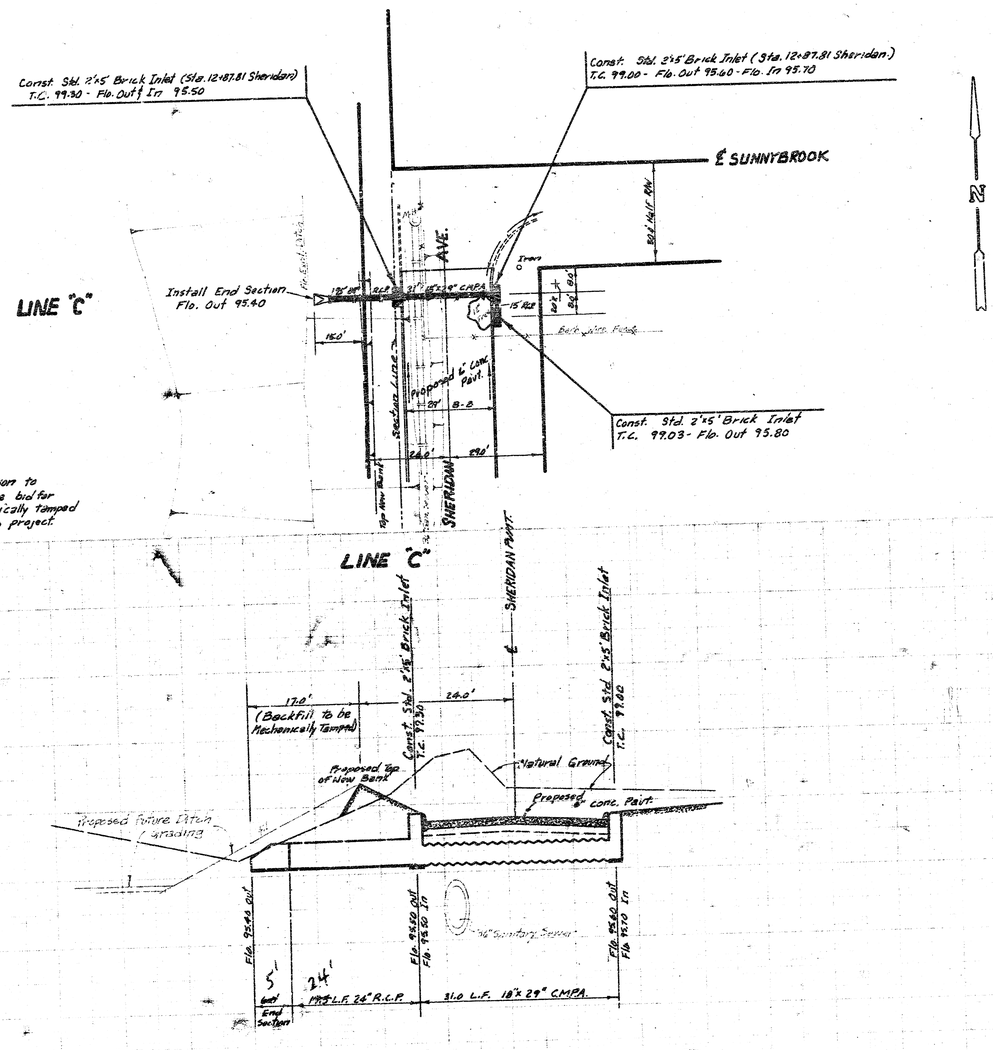

Note: Cost for end section to be included in the price bid for pipe. Cost for mechanically tamped backfill to be incidental to project.

PLAN SCALE: 1"=20'
PROFILE SCALE: 1"=10' HORIZ.
1"=5' VERT.

105
100
95
90

INCIDENTAL DRAINAGE
IN CONNECTION WITH THE PAVING
OF
SHERIDAN AVENUE
DAKO 5750(9)
N.L. 31ST ST. SO. TO N.L. SUNNYBROOK LN.
6/63

FILMED FROM THE BEST AVAILABLE COPY