SILVER SPRINGS

LOT 2, BLOCK 1, SILVER SPRINGS

AN ADDITION TO THE CITY OF WICHITA, KANSAS

INTERIM DECELERATION LANE & MAJOR ENTRANCE ON RIDGE ROAD

PROJECT # 472-76-245-80000-000-000-008

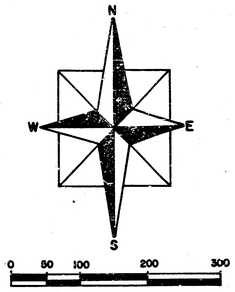

SCALE: 1"=100'

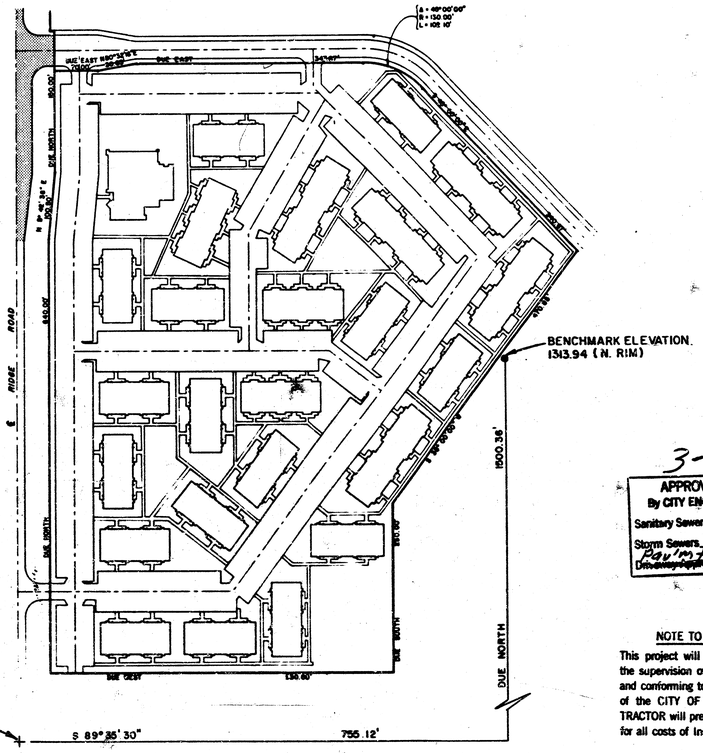

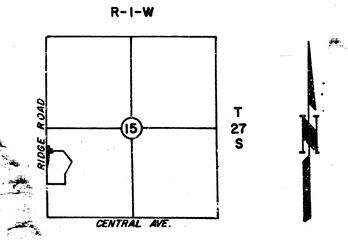

LOCATION MAP

OWNER:

FLOYD R. HARDESTY
4606 SOUTH GARNETT
TULSA, OKLAHOMA
74145
PHONE: 622-3600

GENERAL NOTES

ALL CONSTRUCTION TO BE IN STRICT ACCORDANCE WITH CITY OF WICHITA SPECIFICATION

EXISTING UNDERGROUND LINES HAVE SEEN SHOWN TO THE EXTENT KNOWN AND LOCATIONS ARE APPROXIMATE, THE EXACT LOCATIONS AND NOTIFICATION OF THE PROPER AGENCY IS THE RESPONSIBILITY OF THE CONTRACTOR PRIOR TO ANY EXCAVATION.

LEGEND

	PROPOSED STORM SEWER
	PROPOSED MANHOLE
	PROPOSED INLET
	DRAINAGE AREA LIMITS
SAN. SWR. ESM'T	SANITARY SEWER EASEMENT
STM. SWR. ESM'T	STORM SEWER EASEMENT
U/E	UTILITY EASEMENT
D/E	DRAINAGE EASEMENT
700	EXISTING GROUND CONTOUR
00	PROPOSED FINISHED CONTOUR

BENCHMARK: APPROXIMATELY 755.12 FEET EAST AND 1500.36 FEET NORTH OF THE SOUTHWEST CORNER OF THE SW/4 OF SECTION 15, T-27-S R-1-W.

3-23-84

APPROVED AS NOTED
By CITY ENGINEER OF WICHITA
Sanitary Sewers
Storm Sewers
Pavmt.
Driveway Approaches D.E.A.

INDEX

SHEET NO.	DESCRIPTION
1	TITLE SHEET
2	DECEL LANE PLAN
3	ENTRY & DECEL LANE PLAN

NOTE TO CONTRACTOR

This project will be constructed under the supervision of the CITY ENGINEER and conforming to the SPECIFICATIONS of the CITY OF WICHITA. The CONTRACTOR will prepay the City of Wichita for all costs of Inspection.

AL C. YOUNG & ASSOCIATES
OF TULSA, INC.
CONSULTING ENGINEERING • PLANNING • ENVIRONMENTAL ANALYSIS

No.	REVISION	BY	DATE

☐ APPROVED FOR CONSTRUCTION
☐ NOT APPROVED FOR CONSTRUCTION

CITY OF WICHITA, KANSAS
AL C. YOUNG & ASSOCIATES OF TULSA, INC.
008 S. PEORIA • TULSA, OKLA. 74120 • 918/583-4181

PLAN SCALE 1"=100'	DRAWN	APPROVED:
	DESIGNED SILVER SPRINGS	
PROFILE SCALE HORIZONTAL 1"=	TITLE SHEET	
VERTICAL 1"=	RECOMMENDED ENGINEERING DIRECTOR	1/3
FILE: 4337	DRAWING:	DATE:
ATLAS PAGE NO:		SHEET 1 OF 3 SHEETS

FILMED FROM THE BEST

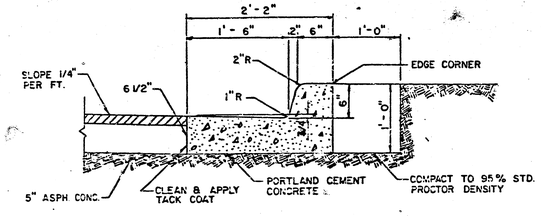

COMBINED CURB AND GUTTER
SCALE: 1"=1'

NOTE: REVERSE GUTTER SLOPE FOR MEDIAN SECTION.

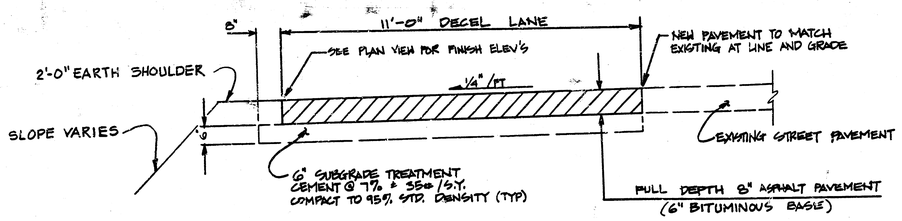

TYPICAL SECTION-DECEL LANE
1/2"=1'-0"

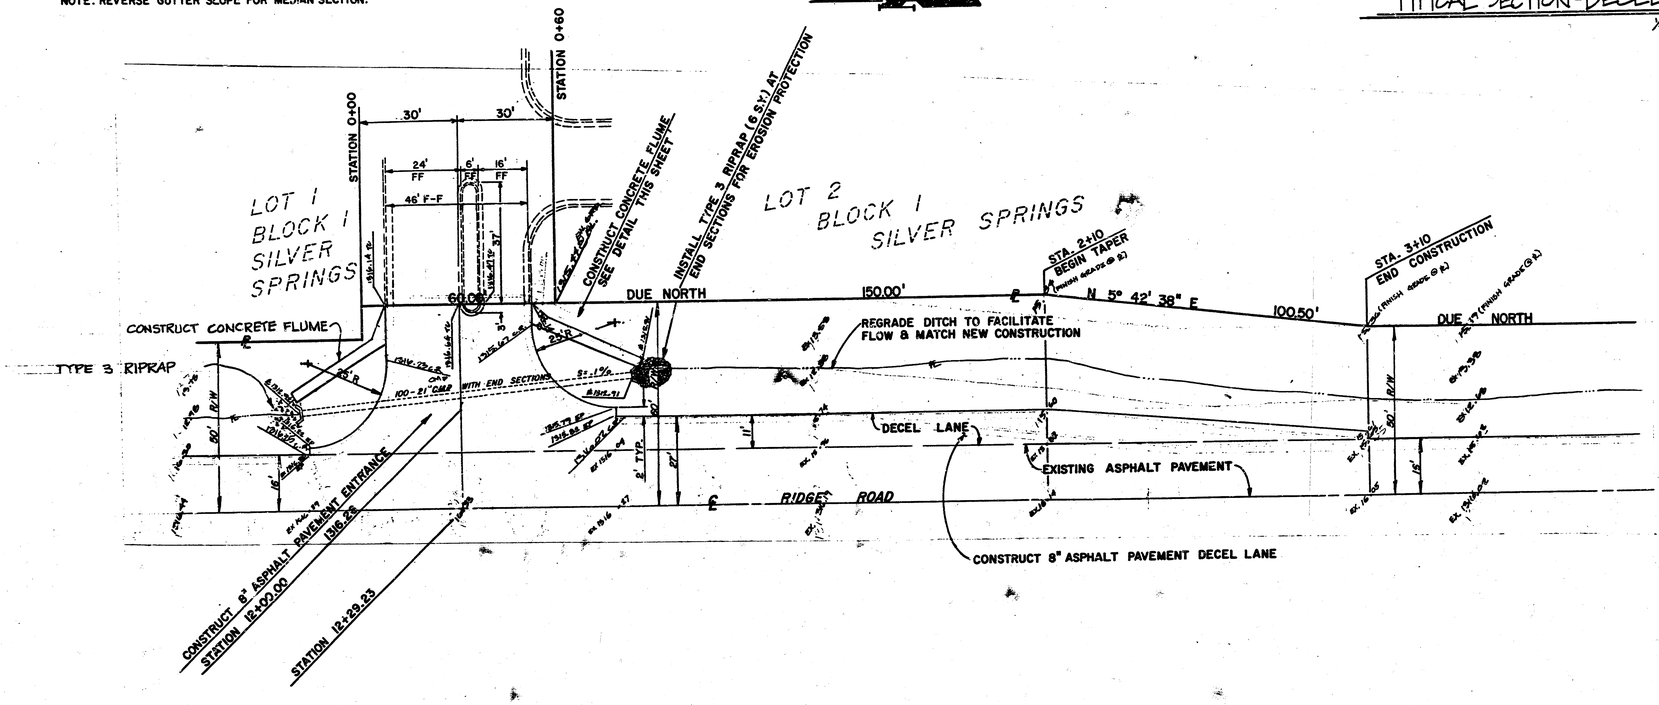

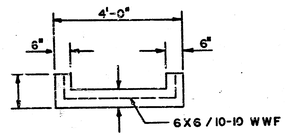

CONCRETE FLUME DETAIL
SCALE: 1"=2'-0"

CITY OF WICHITA, KANSAS
AL C. YOUNG & ASSOCIATES
OF TULSA, INC.
806 S. PEORIA • TULSA, OKLA 74120 • 918/583-4181

REVISION	BY	DATE

PLAN SCALE 20'	DRAWN S. DAVIS	APPROVED
	DESIGNED T.A.S.	
PROFILE SCALE HORIZONTAL	DECEL LANE	
	SILVER SPRINGS	
VERTICAL	RECOMMENDED	SURVEY ASSEMBLY SHEET 2/3
FILE 4337	DRAWING	DATE
ATLAS PAGE NO.		SHEET 2 OF 3 SHEETS

FILMED FROM THE BEST

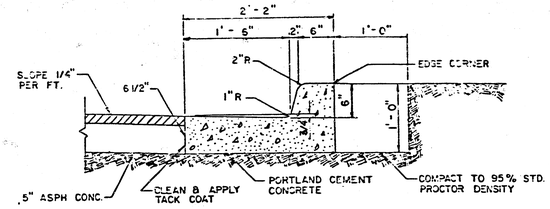

COMBINED CURB AND GUTTER

SCALE: 1"=1'

NOTE: REVERSE GUTTER SLOPE FOR MEDIAN SECTION.

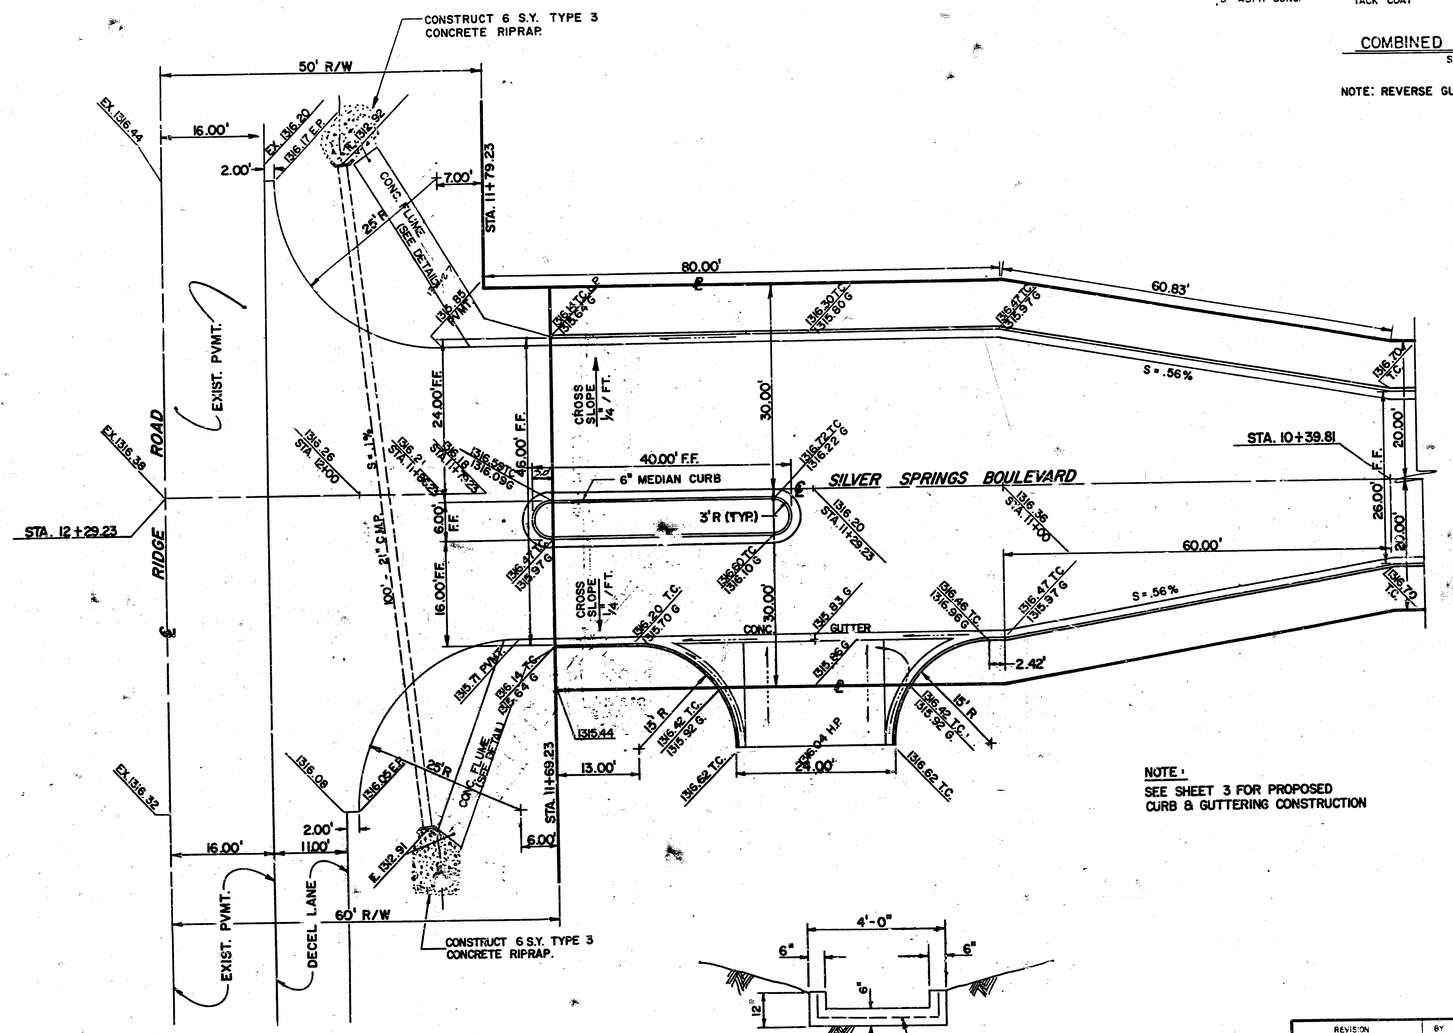

NOTE:
SEE SHEET 3 FOR PROPOSED CURB & GUTTERING CONSTRUCTION

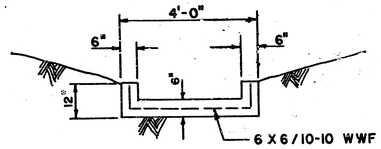

CONCRETE FLUME DETAIL

SCALE: 1"=2'-0"

REVISION	BY	DATE

CITY OF WICHITA, KANSAS

AL C. YOUNG & ASSOCIATES OF TULSA, INC.

808 S. PEORIA • TULSA, OKLA. 74120 • 918/583-4181

PLAN SCALE 1" = 10'

PROFILE SCALE HORIZONTAL 1" = VERTICAL 1" =

DRAWN C. DAVIS

DESIGNED E.A.P.

SILVER SPRINGS DECEL LANE, ENTRY DETAIL SHEET

RECOMMENDED

ENGINEERING DIRECTOR

APPROVED:

CITY ENGINEER 3/3

SUPT. OF WATERWORKS AND SEWERAGE

FILE DRAWING

DATE:

ATLAS PAGE NO.

SHEET 3 OF 3 SHEETS

FILMED FROM THE BEST