


B.M. 129.50 S.W. COR. CONC. PORCH, HOUSE NO. 1962 SHERIDAN.
 B.M. 127.20 N.W. COR. LOWER STEP, HOUSE NO. 1860 SHERIDAN.
 BASELINE ON W. R.

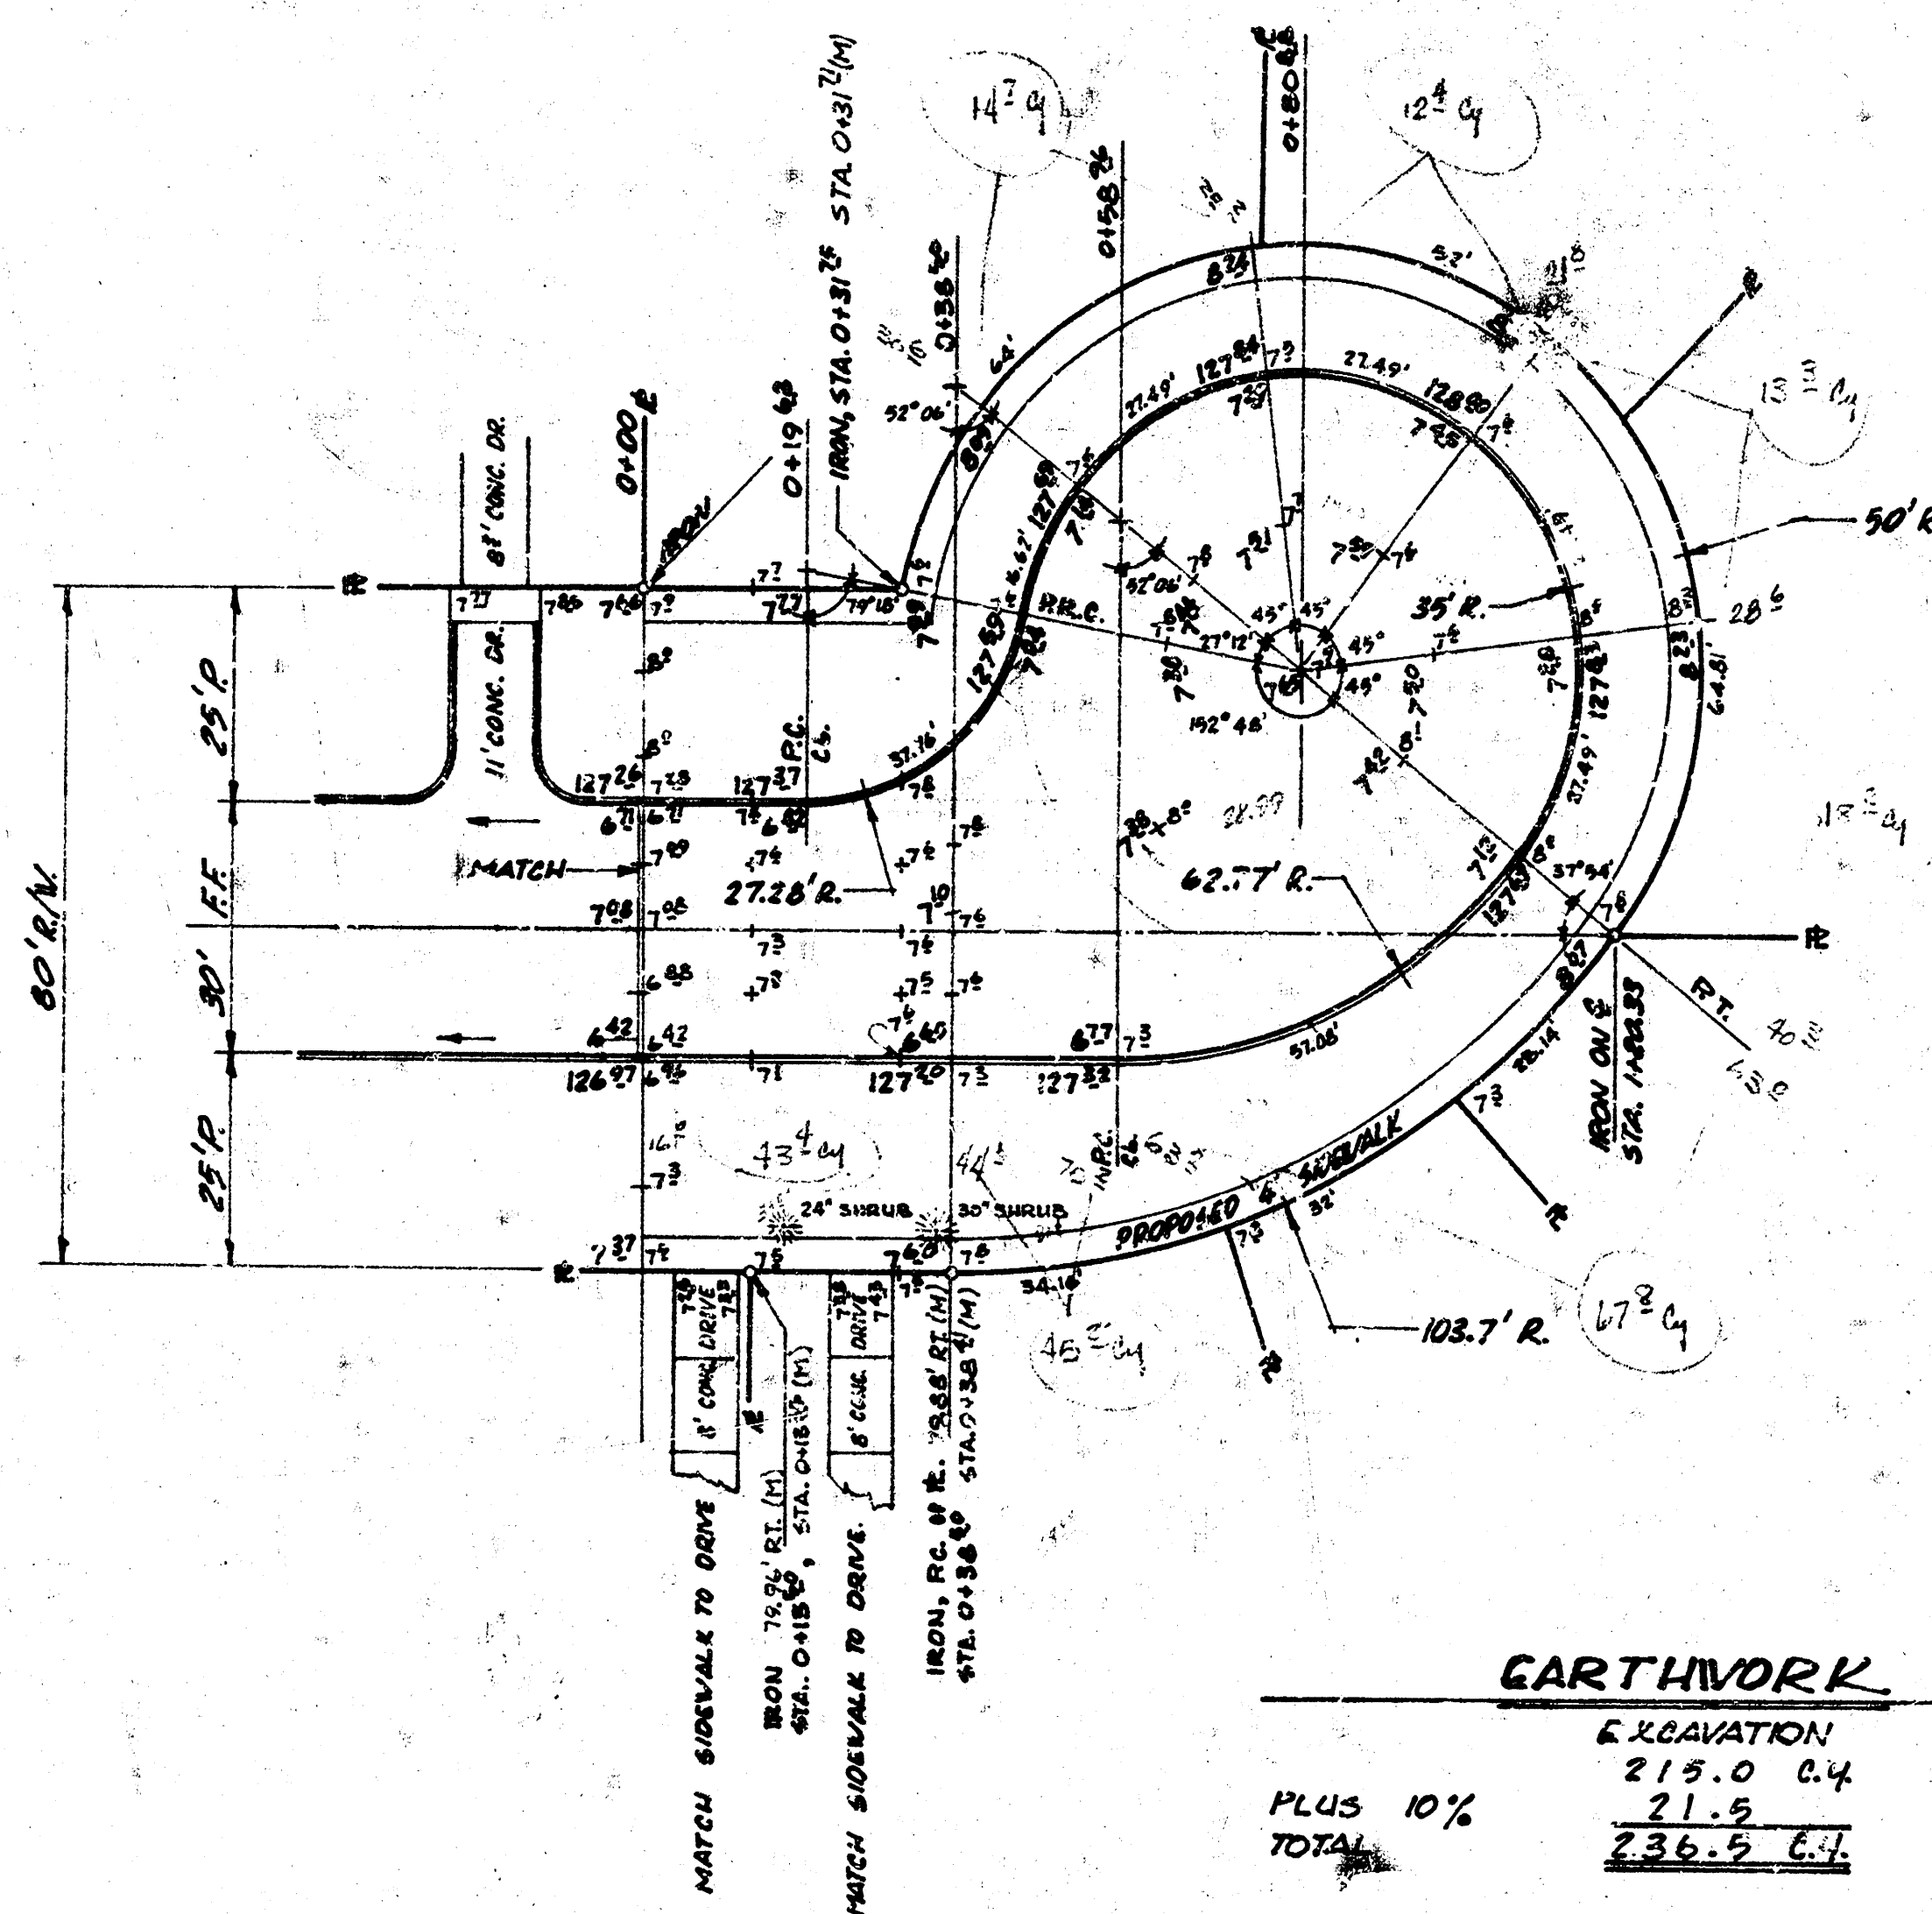

EARTHWORK	
EXCAVATION	COMPACTED FILL
215.0 C.Y.	135 C.Y. 3.4 M.
PLUS 10%	
TOTAL	236.5 C.Y.

GENERAL NOTES

- 1) CONTRACTOR TO GRADE PARKINGS & CLEAR R/W. AS NECESSARY TO CONSTRUCT PROPOSED 4' SIDEWALK. SIDEWALK TO BE CONSTRUCTED BY OTHERS.
- 2) DIMENSIONS ARE BASED ON PLATTED INFORMATION, EXCEPT MEASUREMENTS DENOTED BY (M).

SHERIDAN AVENUE S.E. BLK. 1, ROBESON SCENE
 HEIGHTS, TO 4' INCLUDING CURB & GUT.

30' CONCRETE PAV'T., 6\" THK., 1/2\" INT. CURBS.

CITY of WICHITA, KANSAS.
 B. E. SMITH CITY ENGINEER

DATE: OCT. 1968

PROJECT No. C17-77
 SHEET 1 of 1