
Survey: D.L.K. Book: AC-618
Plan: Schmitt
Ck.: do.
Checked: F. Smith

Scale: 1"=20'

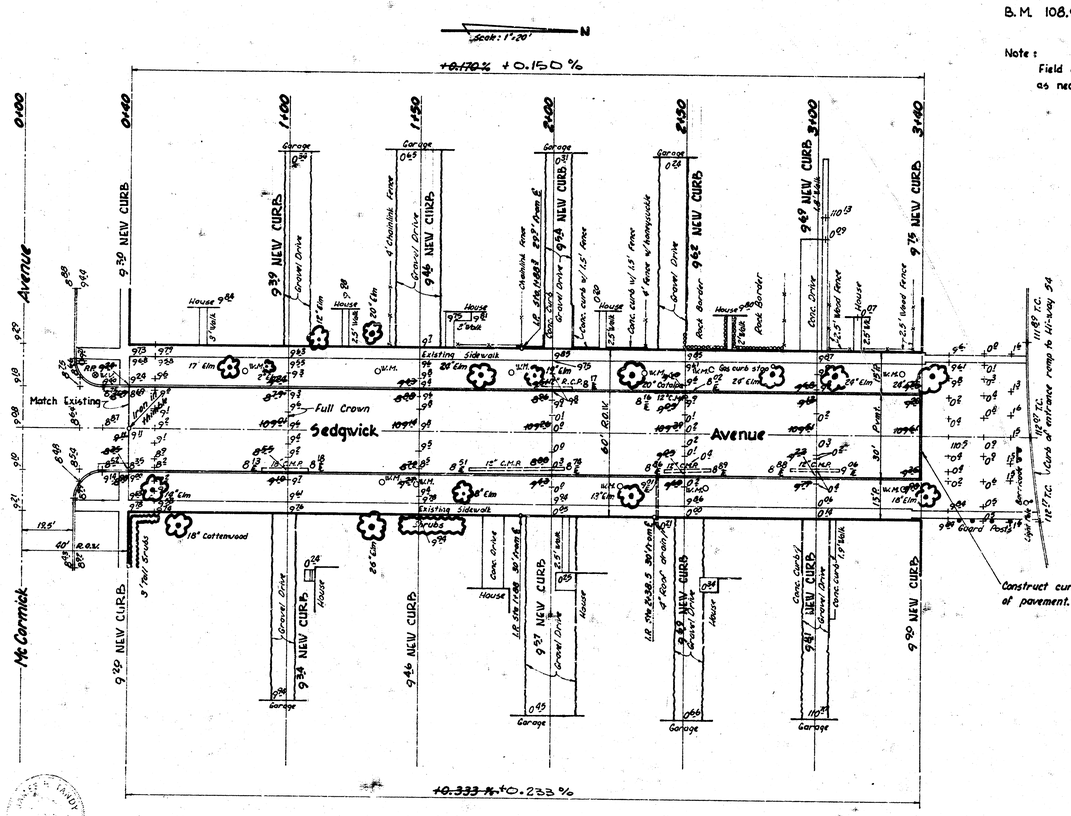

B.M. 108.96 Iron in thimble, N.L. McCormick & ℄ Sedgwick.

Note:
Field engineer shall determine where to remove sidewalks thru drives as necessary to provide acceptable entry.

Earthwork

Property	Excavation	Compacted Fill
	445.9 C.Y.	183.3 C.Y., S.G.M.
Plus 10%	44.6	–
Totals	490.5 C.Y.	183.3 C.Y., S.G.M.

B. E. SMITH LICENSED 486 KANSAS PROFESSIONAL ENGINEER

(1/2)

Sedgwick Avenue N.L. McCormick to N.L. lots 5 & 6 Lawnfield Addn.
30' Concrete & Curb

City of Wichita, Kansas.

B. E. Smith City Engineer
Date: Aug. 1909 Project No. C19-32