B.M. 108.96 Iron in thimble, N. L. McCormick & ℄ Sedgwick.

Note:

Field engineer shall determine where to remove sidewalks thru drives as necessary to provide acceptable entry.

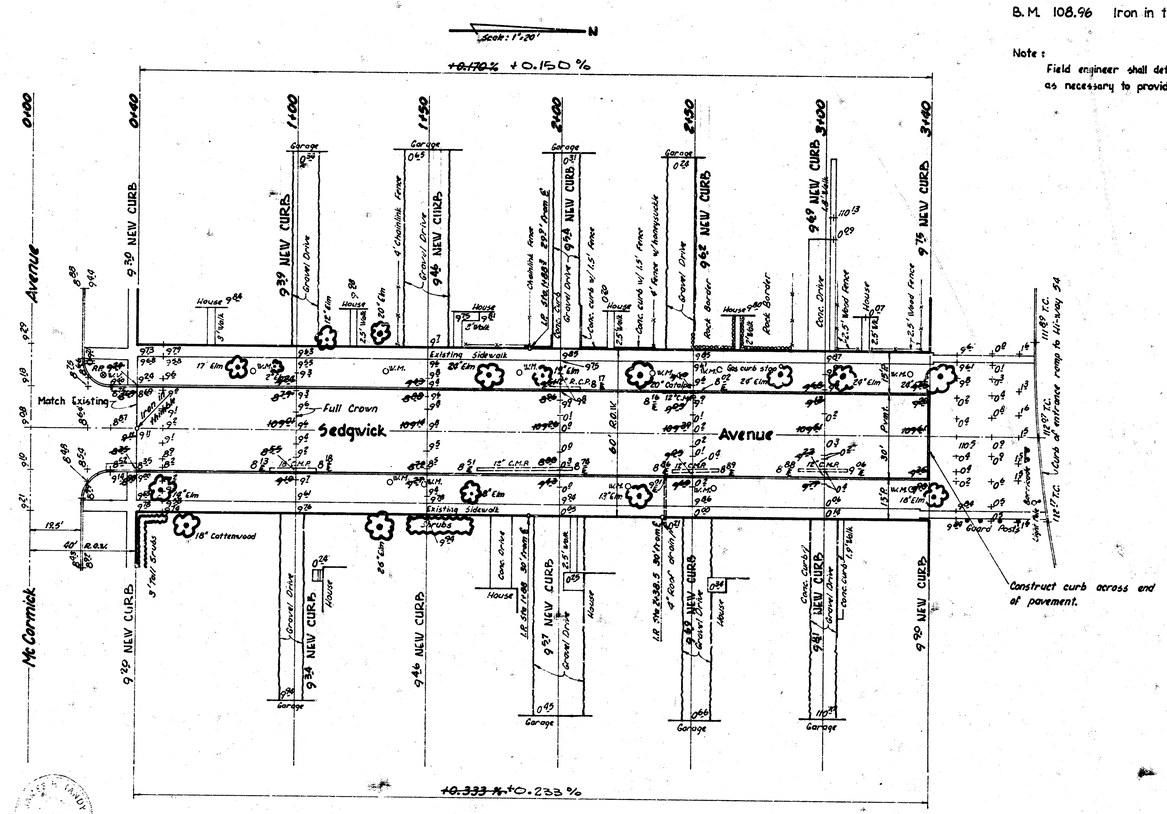

Earthwork

	Property	
	Excavation	Compacted Fill
	445.9 C.Y.	183.3 C.Y., S.G.M.
Plus 10%	44.6	–
Totals	490.5 C.Y.	183.3 C.Y., S.G.M.

Survey: D.L.K. Book: DLK 15
Plan: Schmitt
Cx: ok
Checked: [illegible]

B. E. SMITH LICENSED 486 KANSAS PROFESSIONAL ENGINEER

(1/2)

Sedgwick Avenue N.L. McCormick to N.L. lots 5 & 6 Lawnfield Addn.

30' Concrete & Curb

City of Wichita, Kansas.

B. E. Smith City Engineer

Date: Aug. 1969 Project No. C19-32