

ST

D.M. 120.25 S.W. Cor. Conc. Base RR Crossing Post St Paul & Newell

SLIP MON. ON 4. OF ST. PAUL & 50. SIDE OF WICHITA & COLORADO RR. R/W.
TIES:
(1) 125' S.E. TO COR. FENCE POST
(2) 385' S.W. TO N.E. COR. HOUSE # 681 ST. PAUL
N.W. WICHITA & COLORADO RR. R/W.
TIES:
(1) 450' S.W. TO JOINT IN NO. RAIL, W. OF CENTER
(2) 957' S.E. TO JOINT IN NO. RAIL, E. OF CENTER

NOTE: BEGIN TO RAISE FLO LINE 25' EACH SIDE OF TRACK SO THAT AT TRACK FLO LINE AND CURB GRADE ARE SAME.

NO PAC RR

ST PAUL


NEWELL

AVE. CENTRAL

ST. PAUL ST
SL. NEWELL TO SL. CENTRAL
80' CONCRETE & CURB
CITY OF WICHITA, KANS.
L.K. WHITE : CITY ENGINEER
NOV. 1946

Prop Ecu
17
5.2
8.7
4.4
2.1
21.5
32.8
54.1
97.8
40.5
288.8
70.4
359.2 Comp

City Ecu
22.7
4.6
5.9
34.4
70.6
378.6 Comp

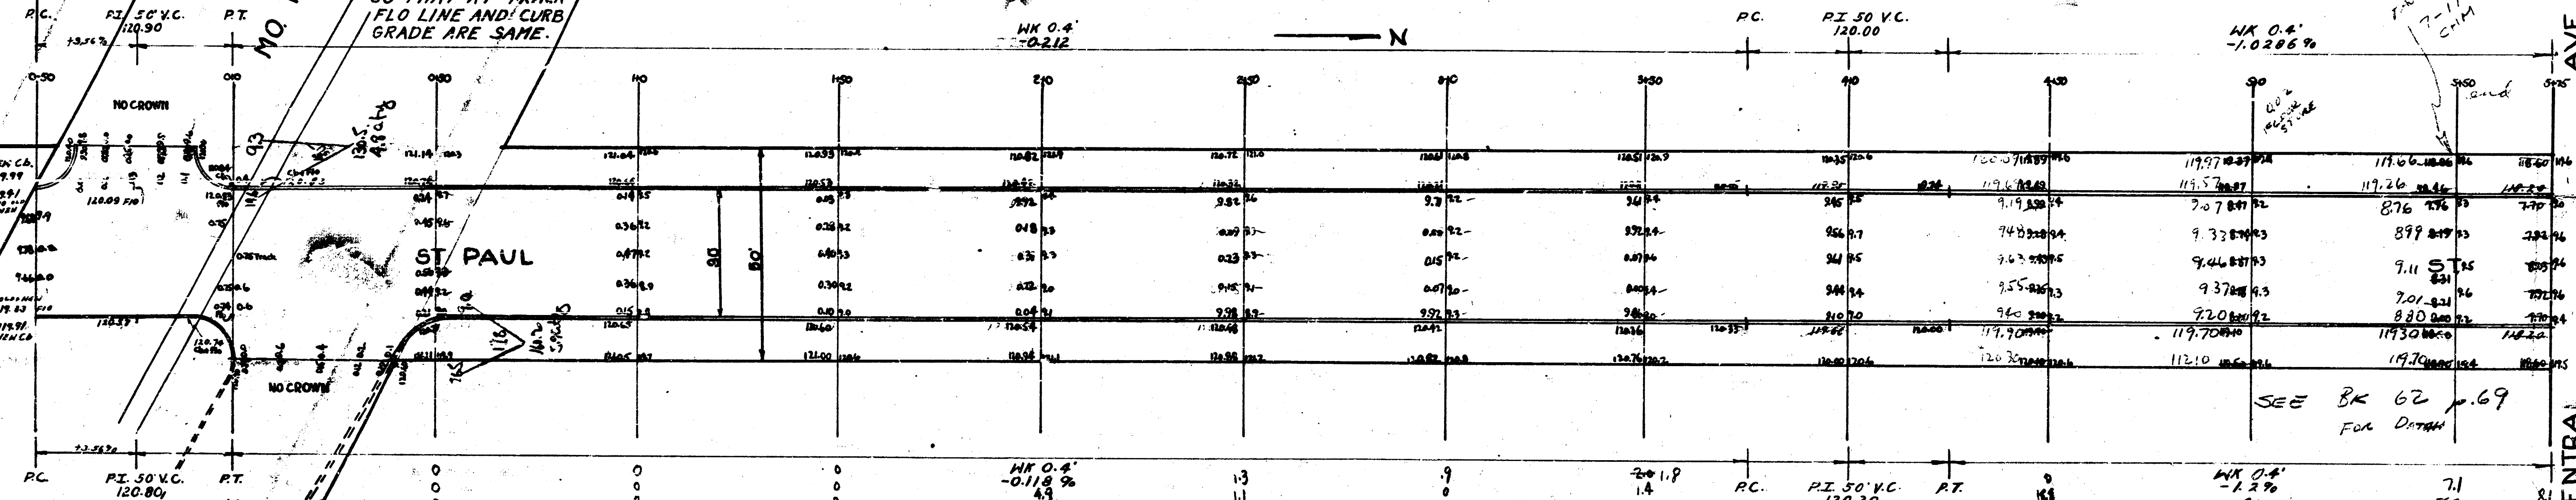

SEE BK 62 FOR DETAIL