B.M. 115.53 N.E. corner conc. porch S.W. corner Taft & St. Paul.

Ties to IRON Sta. 0+30 & Taft & St. Paul

1. 24.70' E. to nail in washer in S. face p. pole.
2. 71.66' S.S.W. to nail in washer E. face p. pole.
3. 28.31' N.N.W. to nail in washer W. face p. pole.
4. 80.98 N.E. to nail in washer W. face p. pole.


NOTE: Contractor to clear right-of-way & grade parkings for proposed sidewalk. Sidewalk to be constructed by others.

N

Scale: 1"=20'

NOTE: Notify the Sewer Maintenance Division before removing trees.

The Sewer Maintenance Division has requested the removal of the trees located near the sewer pipe. Use caution in removing these trees.

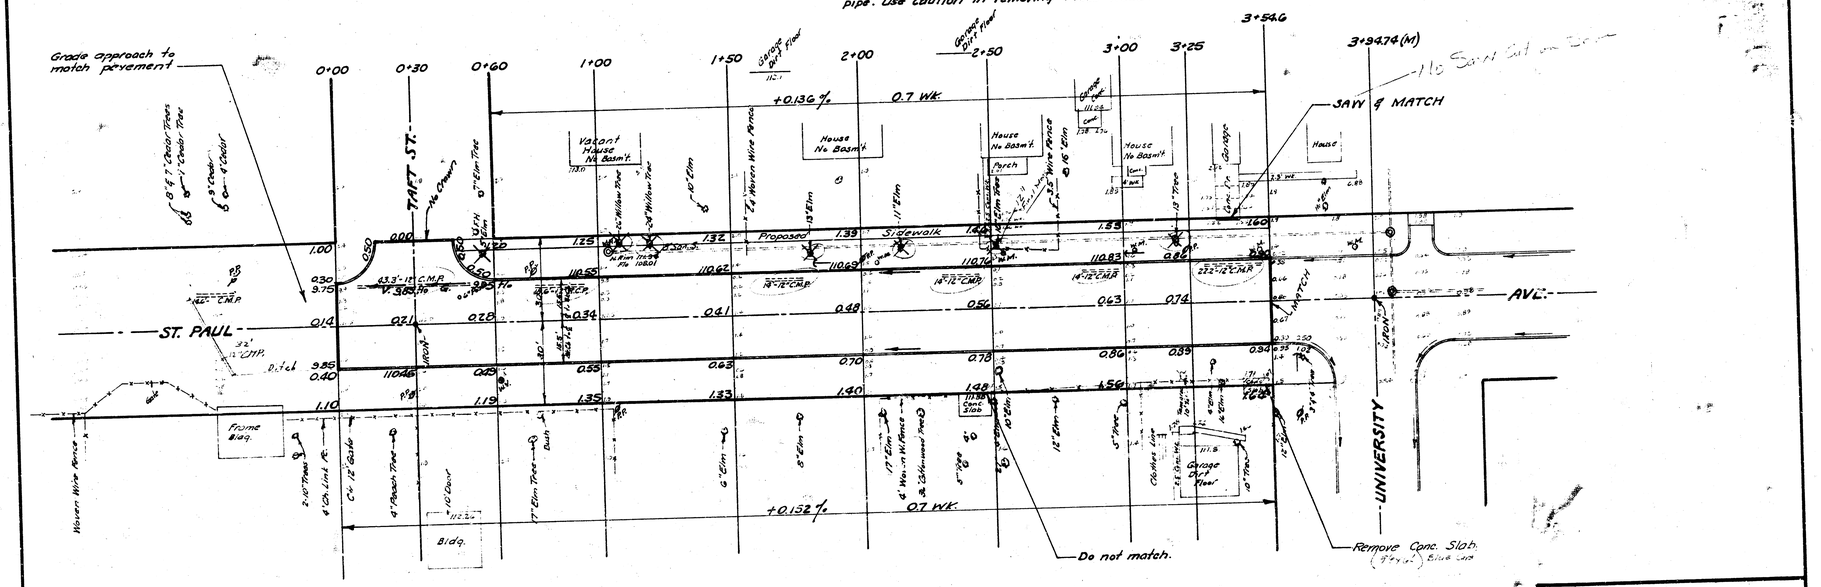

EXCAVATION

	PROPERTY	CITY
	686 Cu.Yds.	126 Cu.Yds.
+10%	69 "	13 "
Totals	755 Cu.Yds.	139 Cu.Yds.

COMPACTED FILL (Subgrade Modification)

200 Cu.Yds. 30 Cu.Yds.

Field Engineer to contact office prior to using any cement for Subgrade Treatment.

ST. PAUL AVE.
S.L. TAFT STREET to S.L. UNIVERSITY AVE.
6" Conc. 31' & Curb.
R.W. LINN CITY ENGINEER
CITY OF WICHITA KANSAS
Date: MAY 1972
Project No. DAKS 571048

1/2