



 All catch basins shown are existing catch basins.  
 Remove all sidewalk in alleys & intersections.

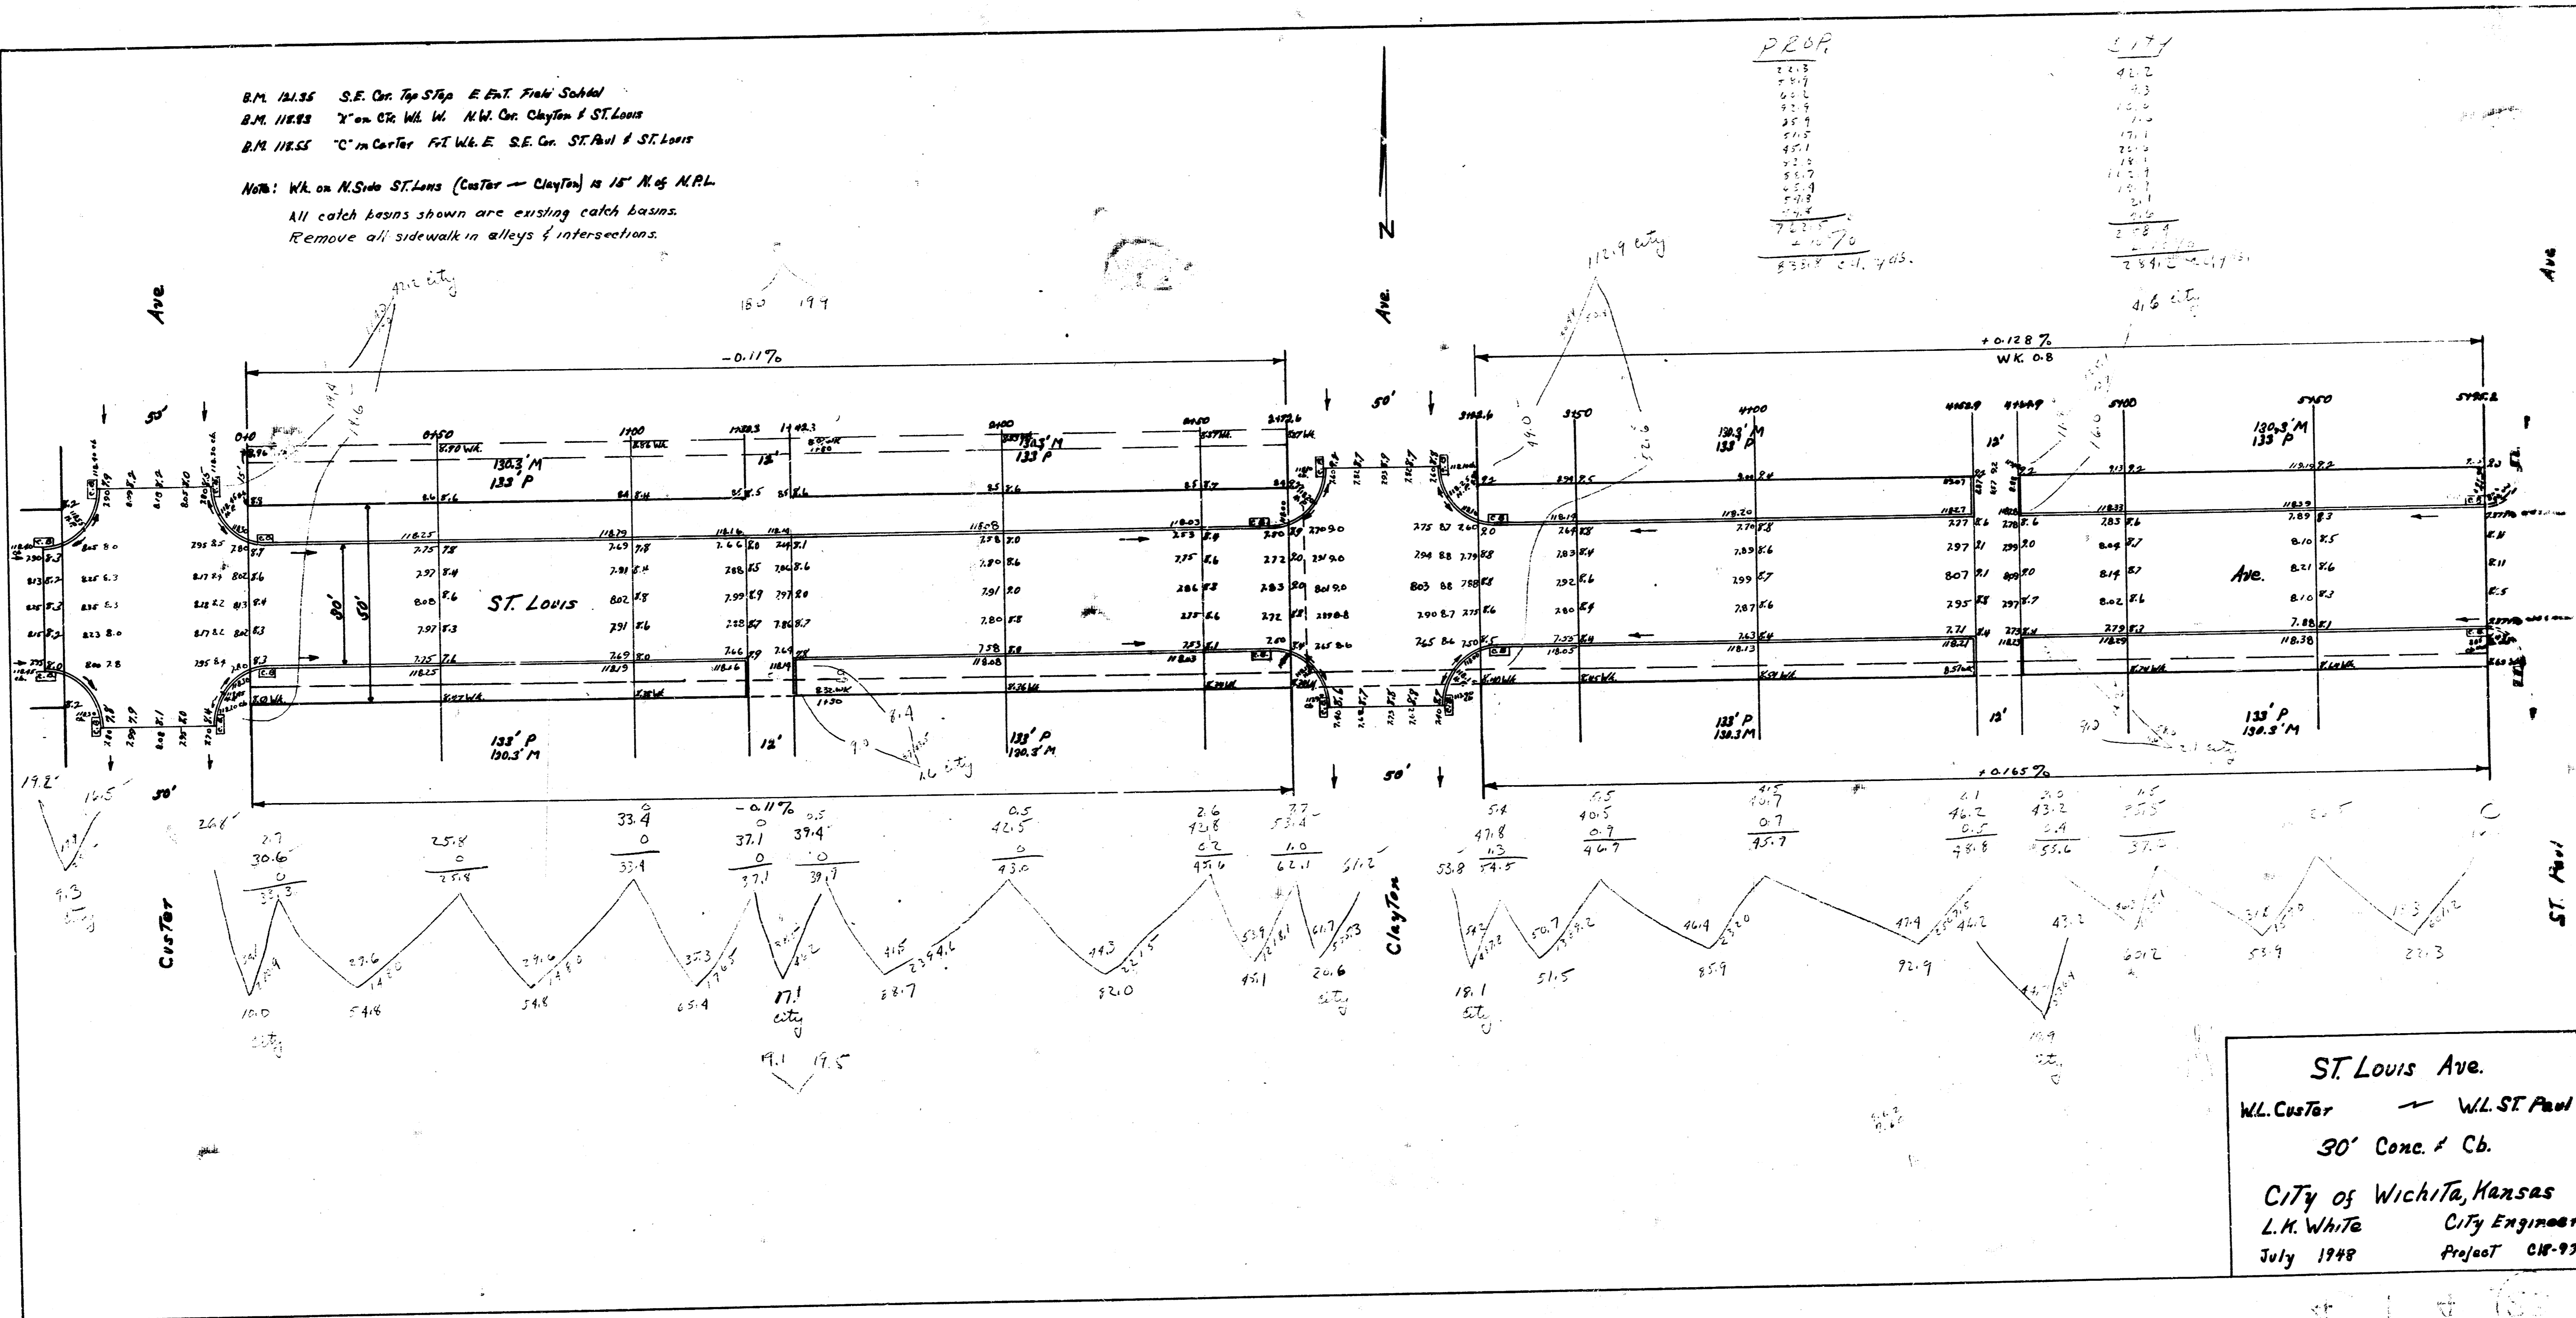

**ST. Louis Ave.**  
 W.L. Custer — W.L. St. Paul  
 30' Conc. & Cb.  
 City of Wichita, Kansas  
 L. K. White City Engineer  
 July 1948 Project CR-97