


E.M.-18.37- M.W. con. patch, @ 2459 Howell
 E.M.-18.42- S.W. con. of Stop 602 North St. Clair

Property
 55.8
 55.2
 156.8
 109.5
 129.7
 149.2
 82.7
 113.0
 102.8
 76.5
 53.1
 42.8
 21.0
 32.9
 130.4
 192.5

C.4
 44.5
 30.9
 61.6
 29.7
 7.2
 6.2
 190.6
 18.1
 198.7

Note to field engineer: Please
 Measure amount of gutter
 and combined Ch & p. removed
 L.H.

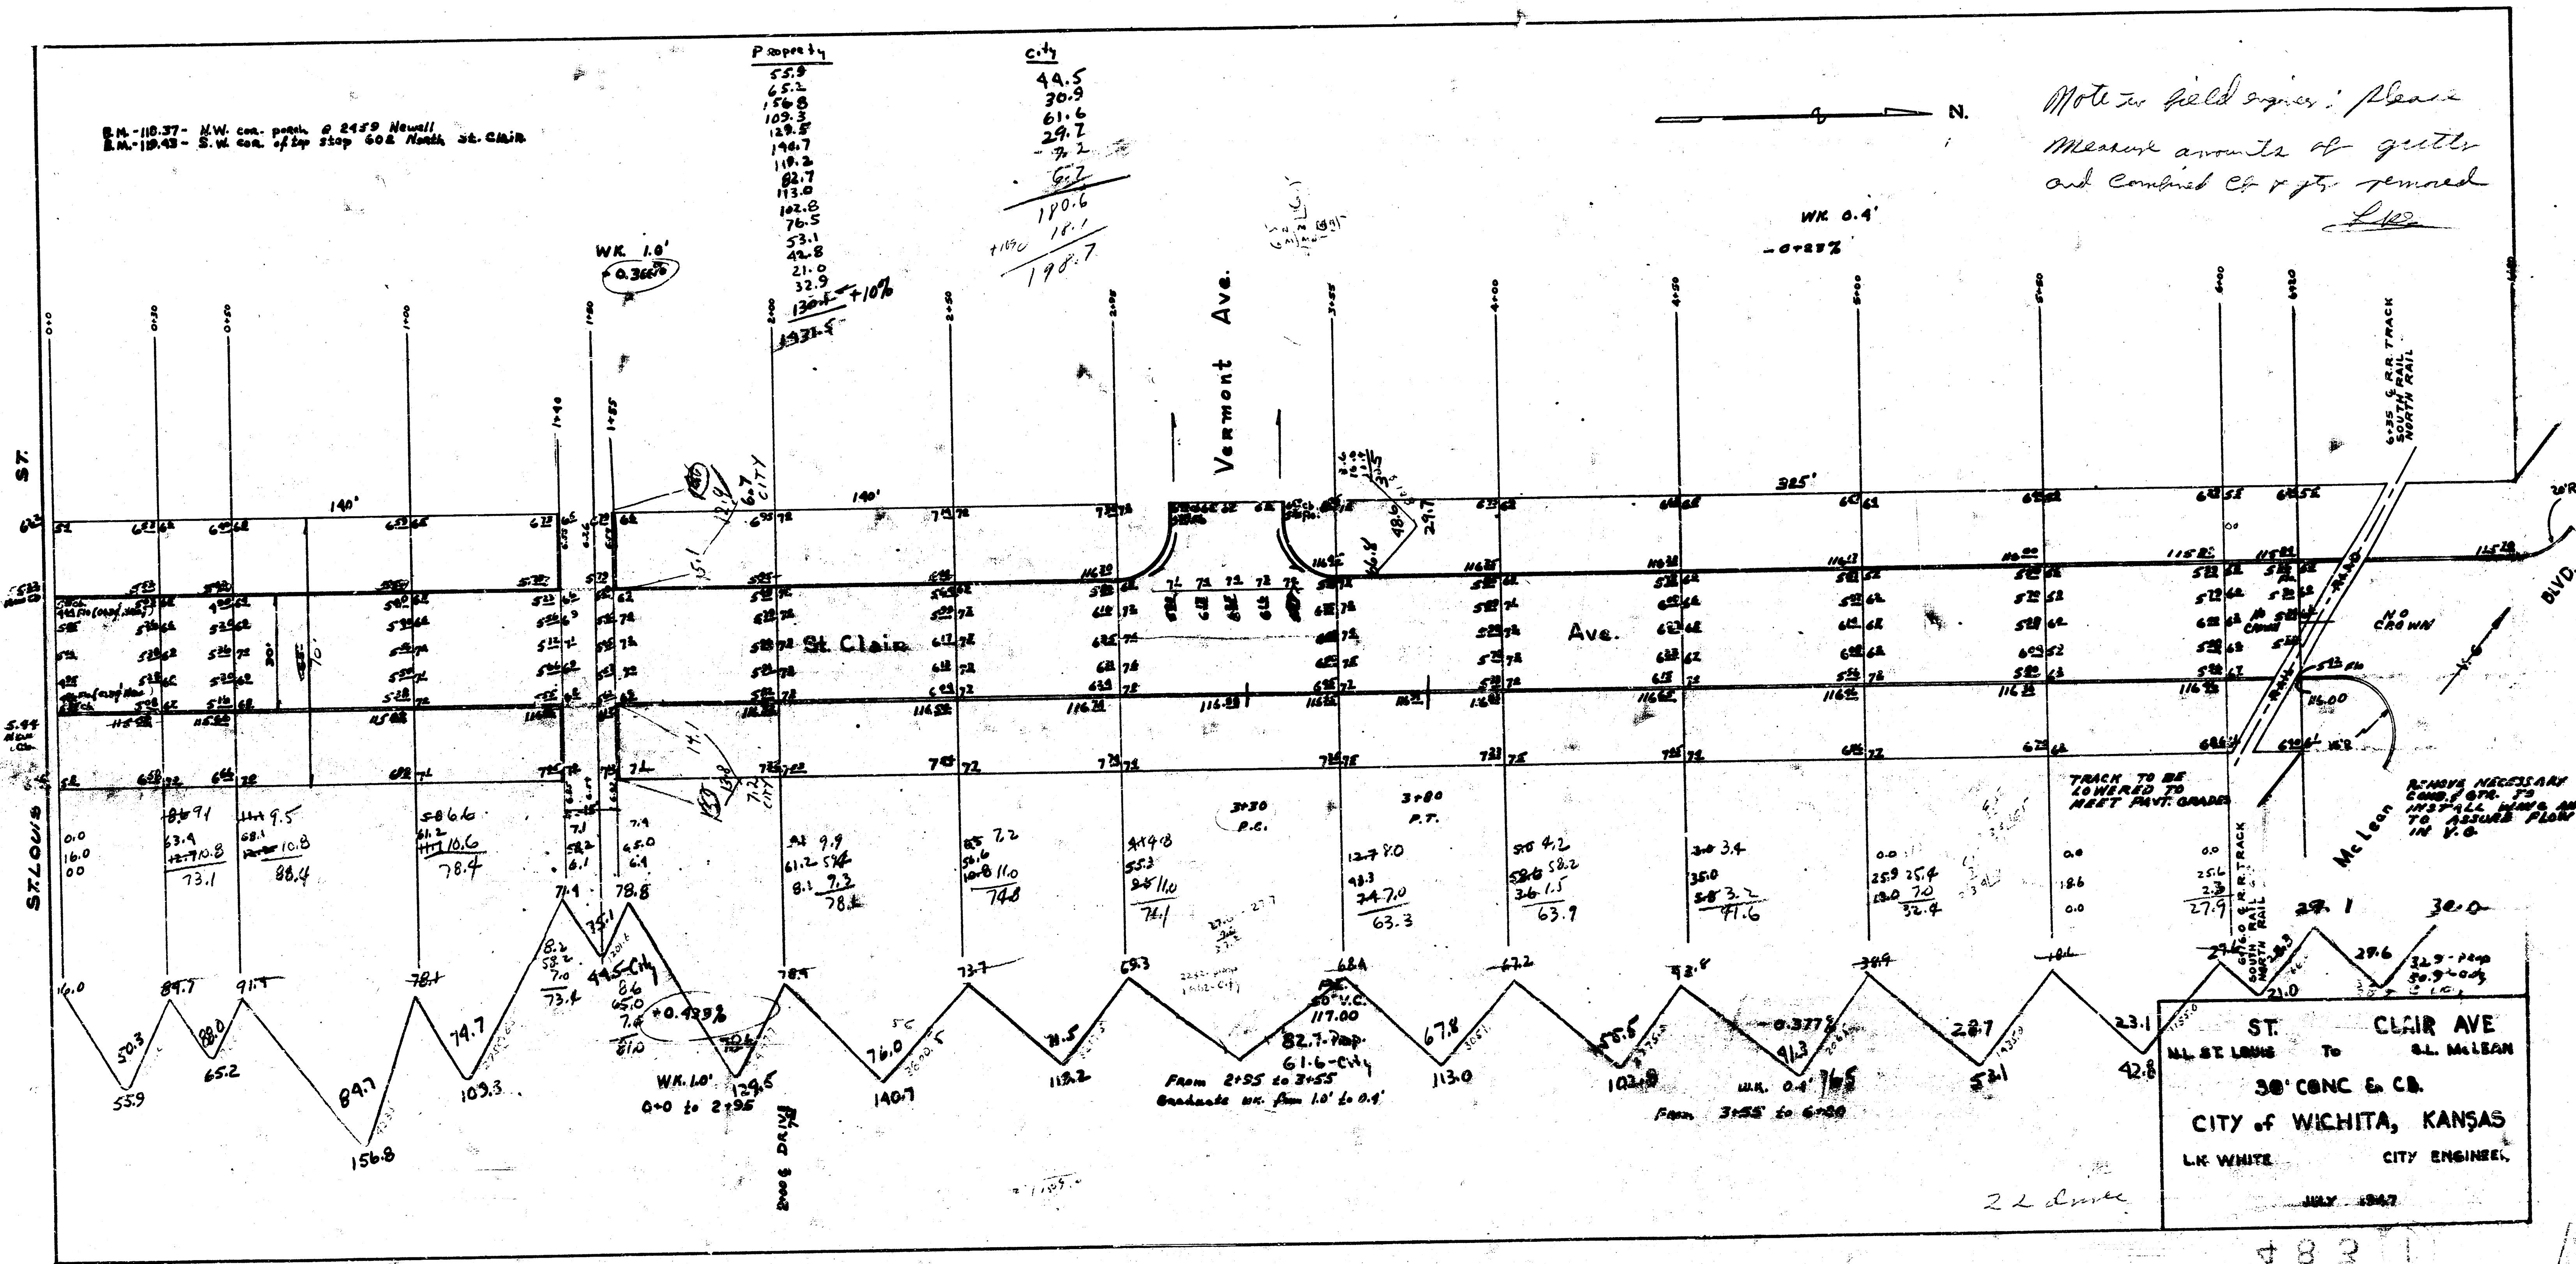

ST. CLAIR AVE
 30" CONC. & C.B.
 CITY OF WICHITA, KANSAS
 L.H. WHITE CITY ENGINEER
 JULY 1947

4821